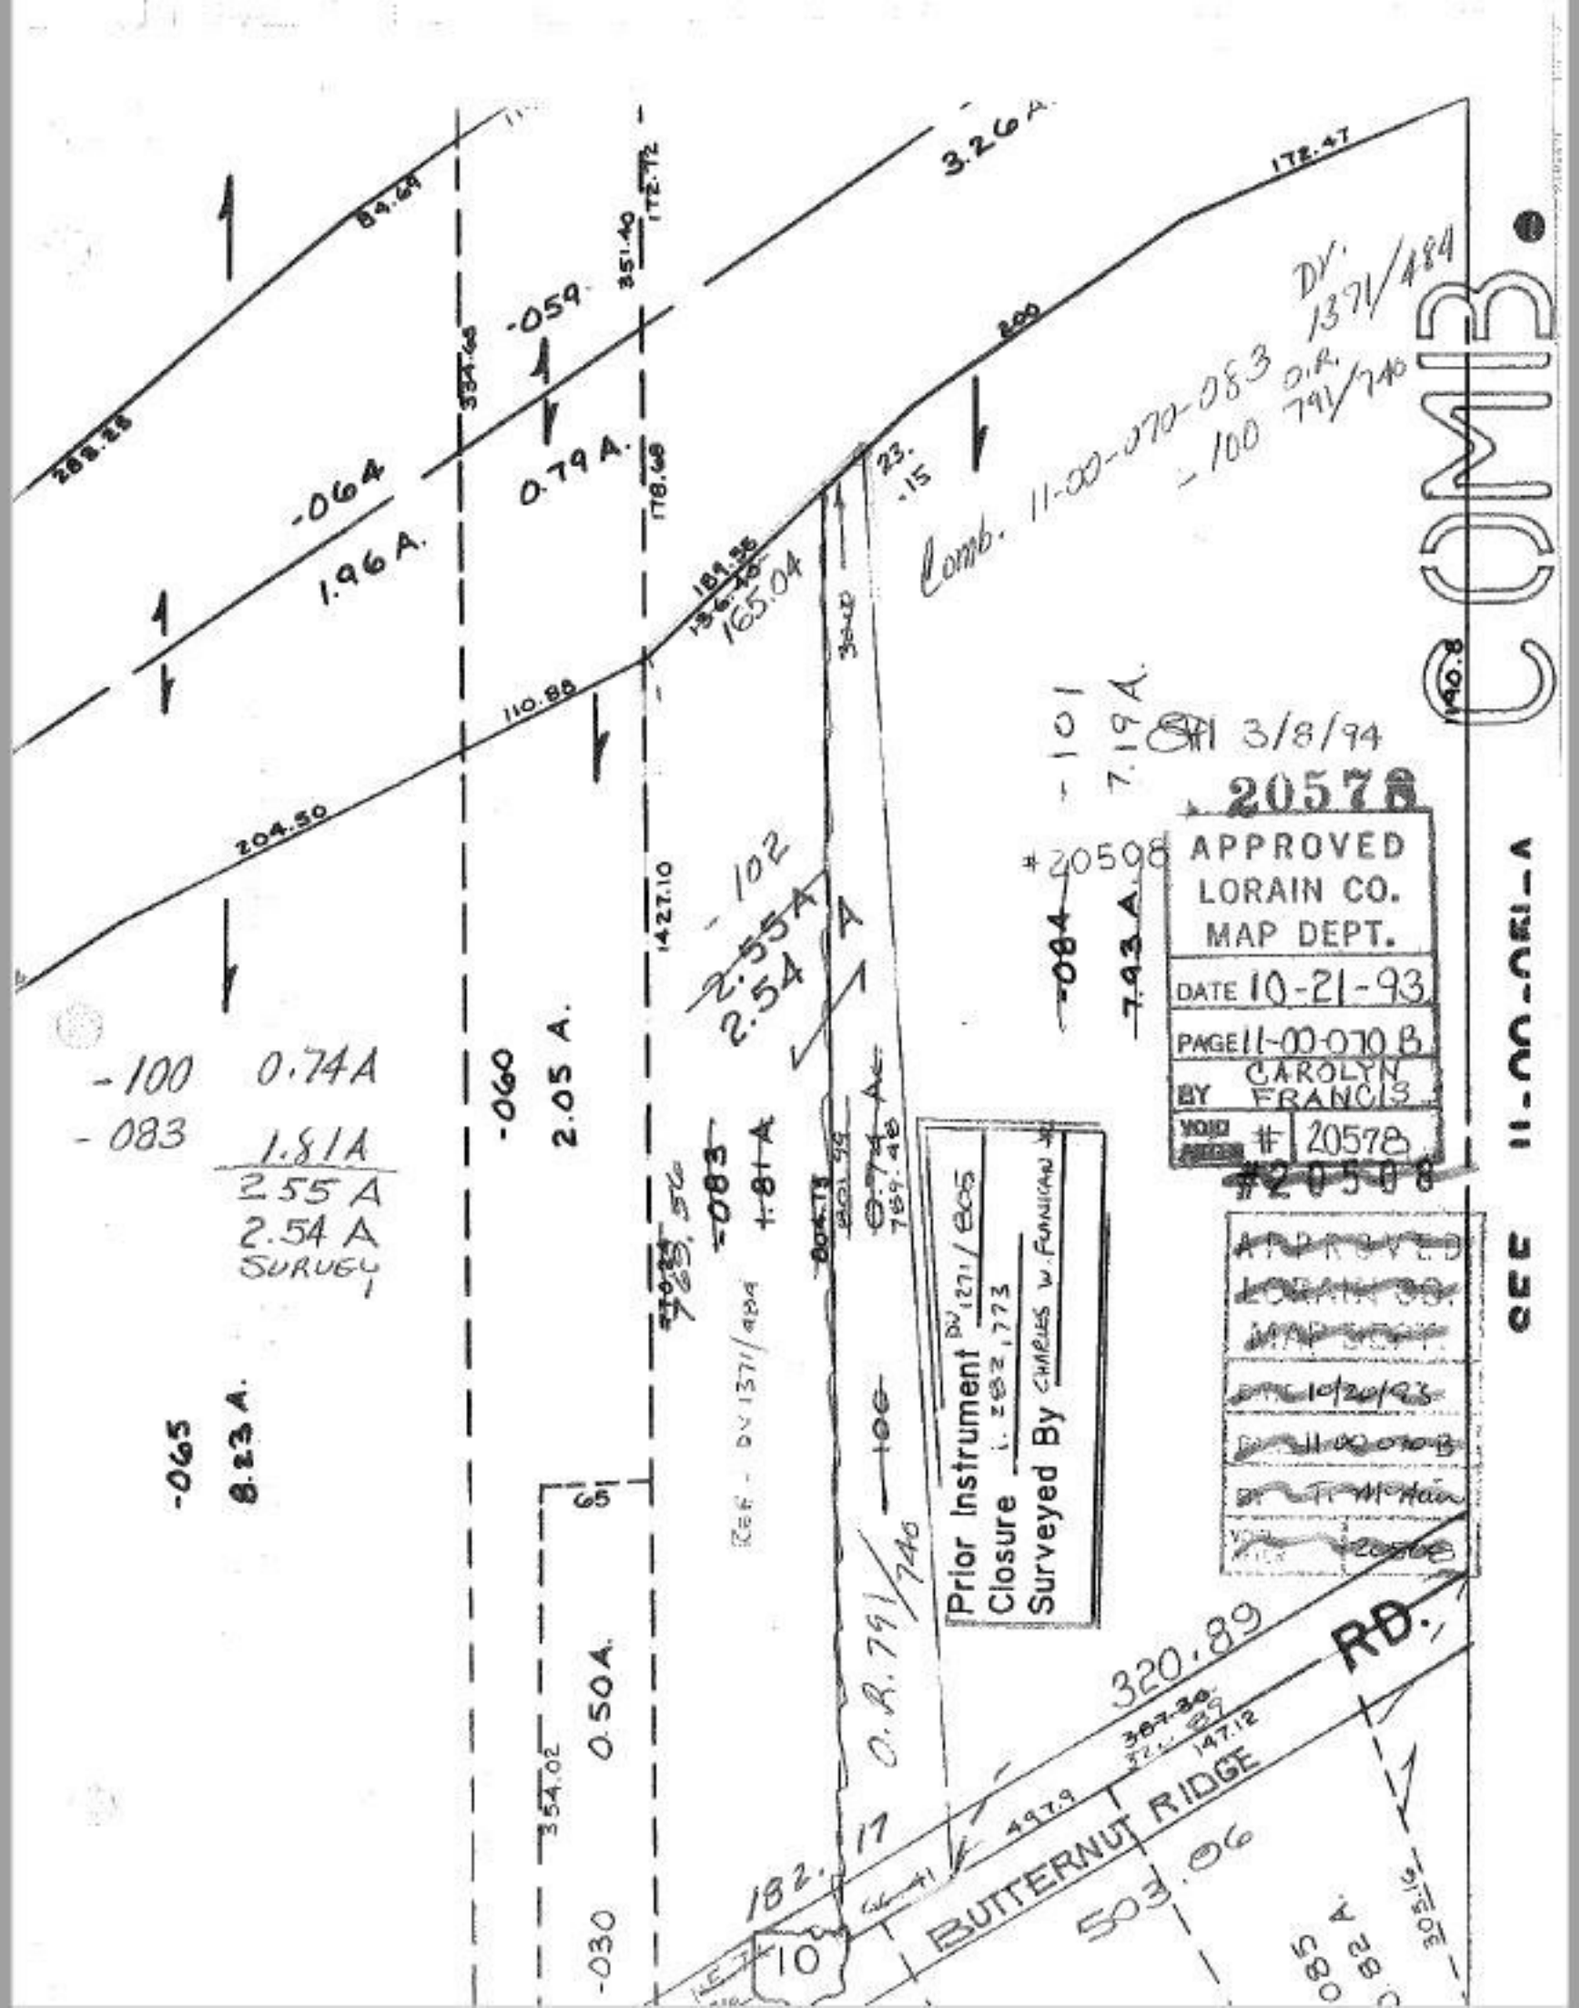
3.26 A.
-059
0.79 A.
-064
1.96 A.
-060
2.05 A.
-065
8.23 A.
0.50 A.
-030
-100 0.74 A
-083 1.81 A
2.55 A
2.54 A
SURVEY
-102
2.55 A
2.54 A
-101
7.19 A.
-084
7.43 A.
-083
1.81 A
Comb. 11-00-070-083
DV. 1371/484
-100 O.R. 791/740
O.R. 791/740
Ref - DV 1371/484
Prior Instrument DV 1371/805
Closure 1.2832,1773
Surveyed By CHARLES W. FUNNIGAN
APPROVED
LORAIN CO.
MAP DEPT.
DATE 10-21-93
PAGE 11-00-070 B
BY CAROLYN FRANCIS
VOID #20578
#20578
#20508
3/8/94
20578
#20508
APPROVED
LORAIN CO.
MAP DEPT.
10/20/93
11-00-070-B
BUTTERNUT RIDGE
RD.
320.89
503.06
182.17
10
354.02
172.47
200
190.8
COMB
11-00-070-A
SEE