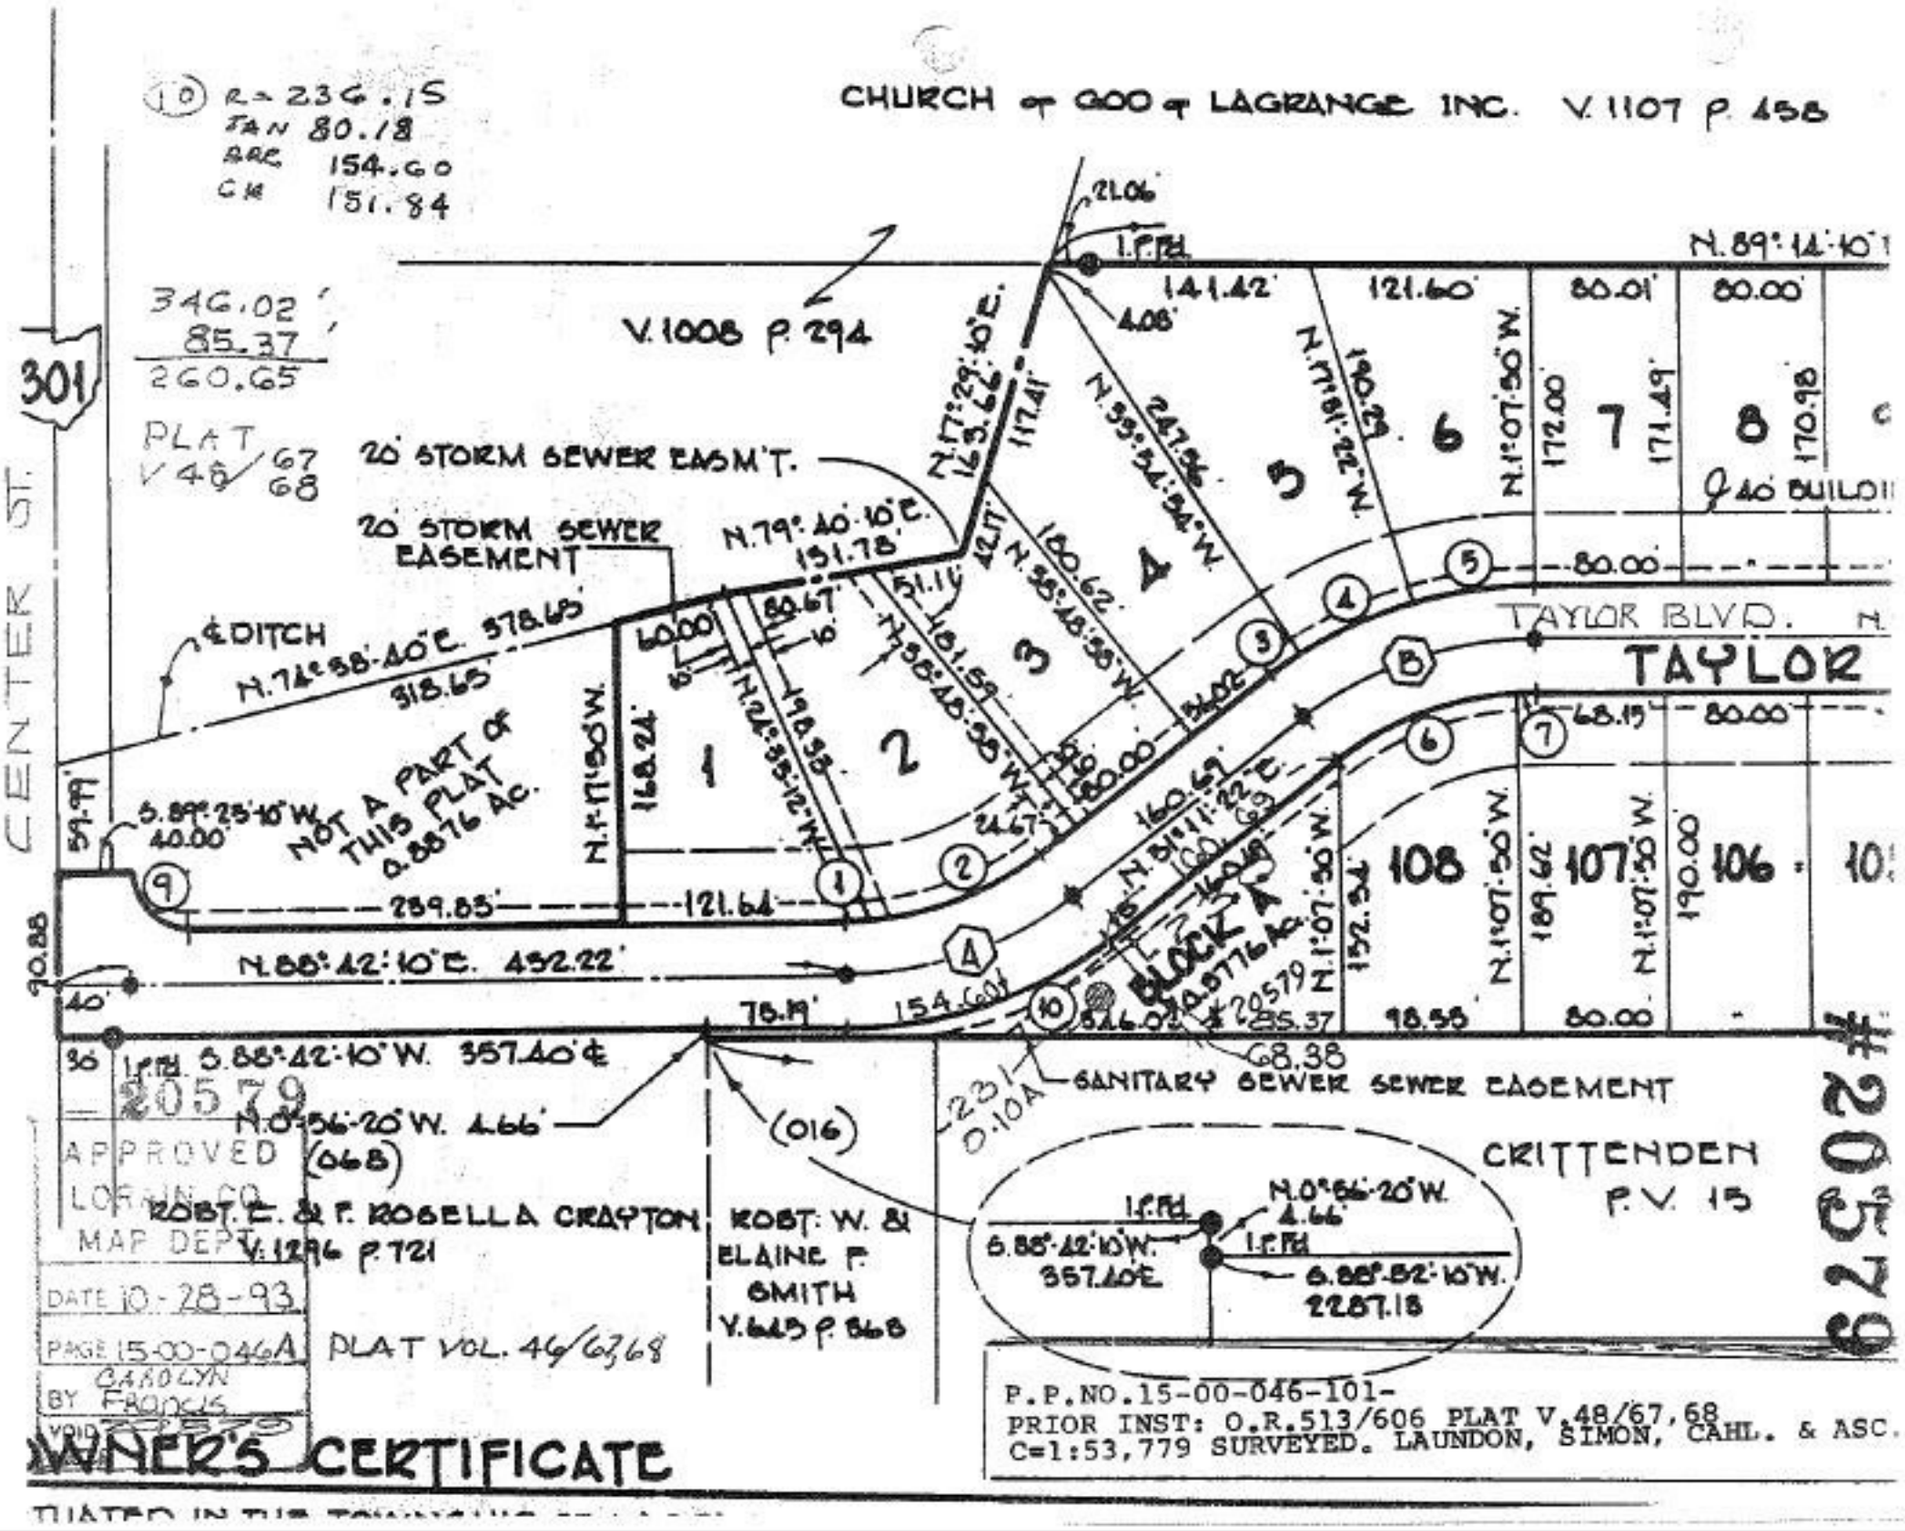
CHURCH of GOD of LAGRANGE INC. V. 1107 P. 458
R=236.15
TAN 80.18
ARC 154.60
CH 151.84
V. 1008 P. 294
N. 89°-14'-10"
21.06
I.F.PH.
141.42
121.60
80.01
80.00
4.08
N.17°-29'-10"E.
163.62
117.41
N.55°-54'-54"W.
247.96
N.1°-07'-50"W.
190.29
N.11°-31'-22"W.
172.00
171.49
170.98
346.02
85.37
260.65
PLAT V 48/67 68
20' STORM SEWER EASM'T.
20' STORM SEWER EASEMENT
N.79°-10'-10"E.
131.78
42.17'
100.62
51.11'
N.78°-48'-50"W.
181.59
80.67'
50.00'
24.02
80.00
TAYLOR BLVD.
TAYLOR
68.15
80.00
&DITCH
N.72°-38'-10"E. 578.65
318.65
59.99'
S.89°-25'-10"W.
40.00
NOT A PART OF THIS PLAT 0.8876 AC.
N.F.-11°-30'-W.
168.24'
N.24°-35'-12"W.
198.93
239.85'
121.64
160.62
N.31°-11'-22"E.
160.69
15'
160.48
N.1°-07'-50"W.
152.52
189.62
190.00
108
107
106
90.88
N.88°-42'-10"E. 432.22'
40'
78.19'
154.60'
BLOCK A
0.8776 Ac.
#20579
516.02'
85.37
98.55
80.00
68.38
231'
0.10A
SANITARY SEWER SEWER EASEMENT
CRITTENDEN
P.V. 15
I.F.PH.
N.0°-56'-20"W.
4.66'
S.88°-42'-10"W.
357.40'E.
S.88°-52'-10"W.
2287.18
S.88°-42'-10"W. 357.40'E
N.0°-56'-20"W. 4.66'
(016)
(068)
ROBT. E. & F. ROBELLA CRAYTON V. 1296 P. 721
ROBT. W. & ELAINE F. SMITH V. 665 P. 868
PLAT VOL. 46/67,68
APPROVED
LOFRAN CO.
MAP DEPT.
DATE 10-28-93
PAGE 15-00-046A
BY CAROLYN FROGGS
VOID
#20579
OWNER'S CERTIFICATE
P.P.NO.15-00-046-101-
PRIOR INST: O.R.513/606 PLAT V.48/67,68
C=1:53,779 SURVEYED. LAUNDON, SIMON, CAHL. & ASC.
6250#