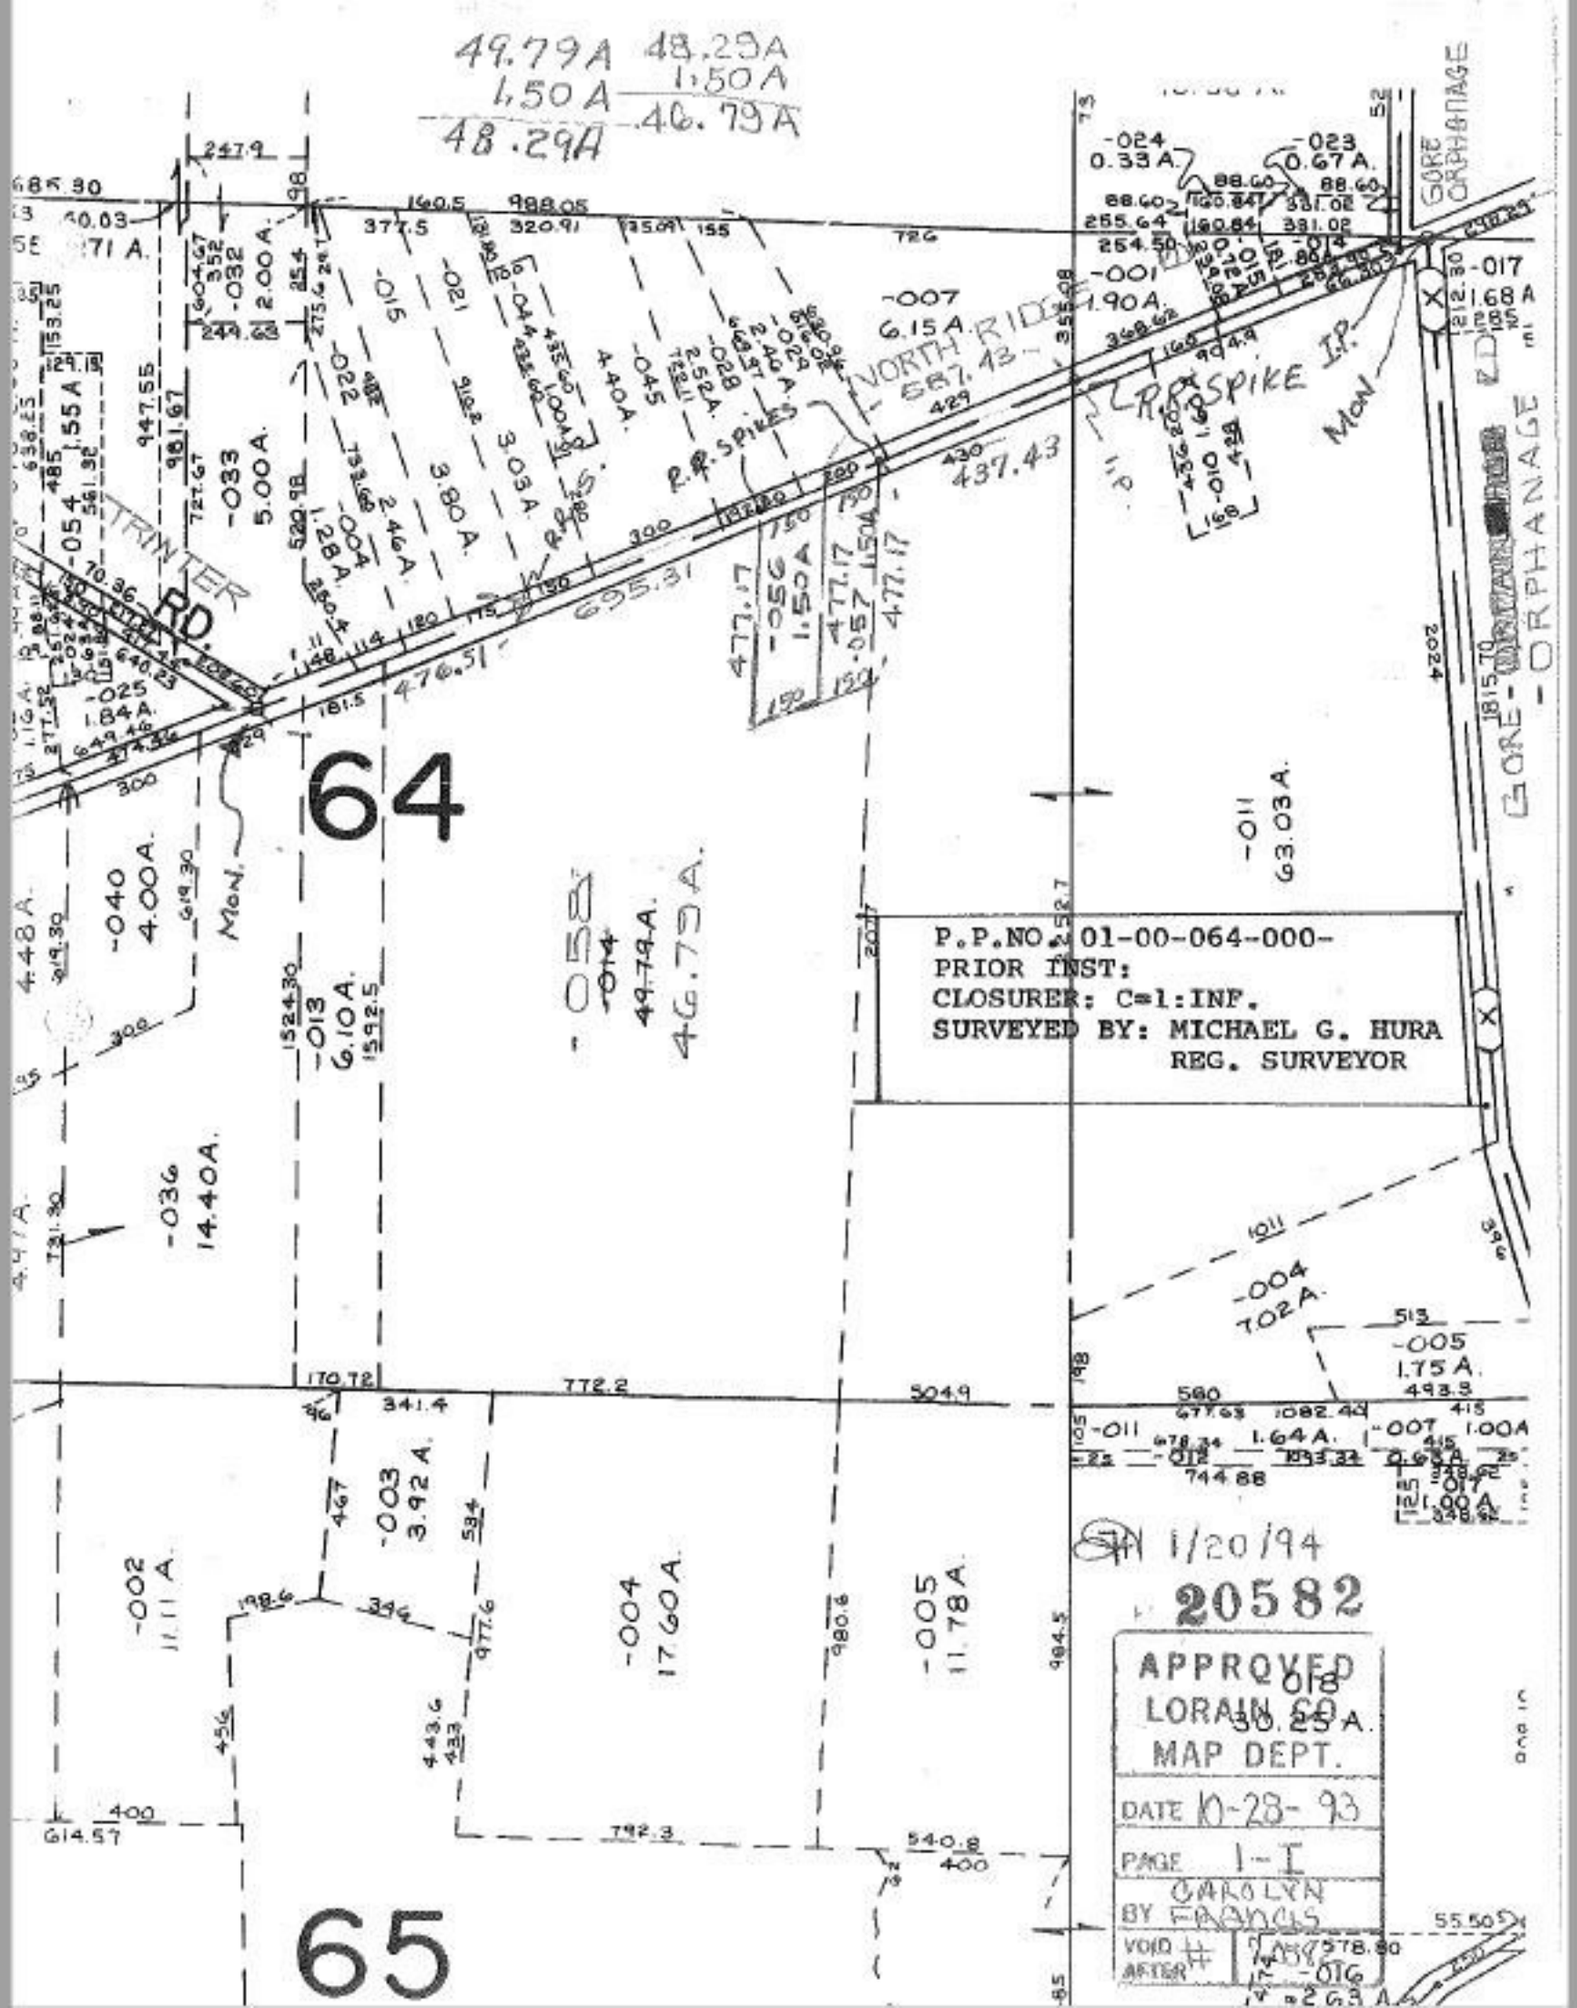
49.79A 48.29A
1.50A 1.50A
48.29A 46.79A
64
65
P.P.NO. 01-00-064-000-
PRIOR INST:
CLOSURER: C=1:INF.
SURVEYED BY: MICHAEL G. HURA
REG. SURVEYOR
NORTH RIDGE
TRINTER RD.
GORE ORPHANAGE
R.R. SPIKES
MON.
-007 6.15 A.
-033 5.00 A.
-040 4.00 A.
-036 14.40 A.
-013 6.10 A.
-002 11.11 A.
-003 3.92 A.
-004 17.60 A.
-005 11.78 A.
-011 63.03 A.
-004 7.02 A.
-005 1.75 A.
1/20/94
20582
APPROVED
LORAIN CO.
MAP DEPT.
DATE 10-28-93
PAGE 1-I
CAROLYN
BY FRANCIS
VOID AFTER #