20584

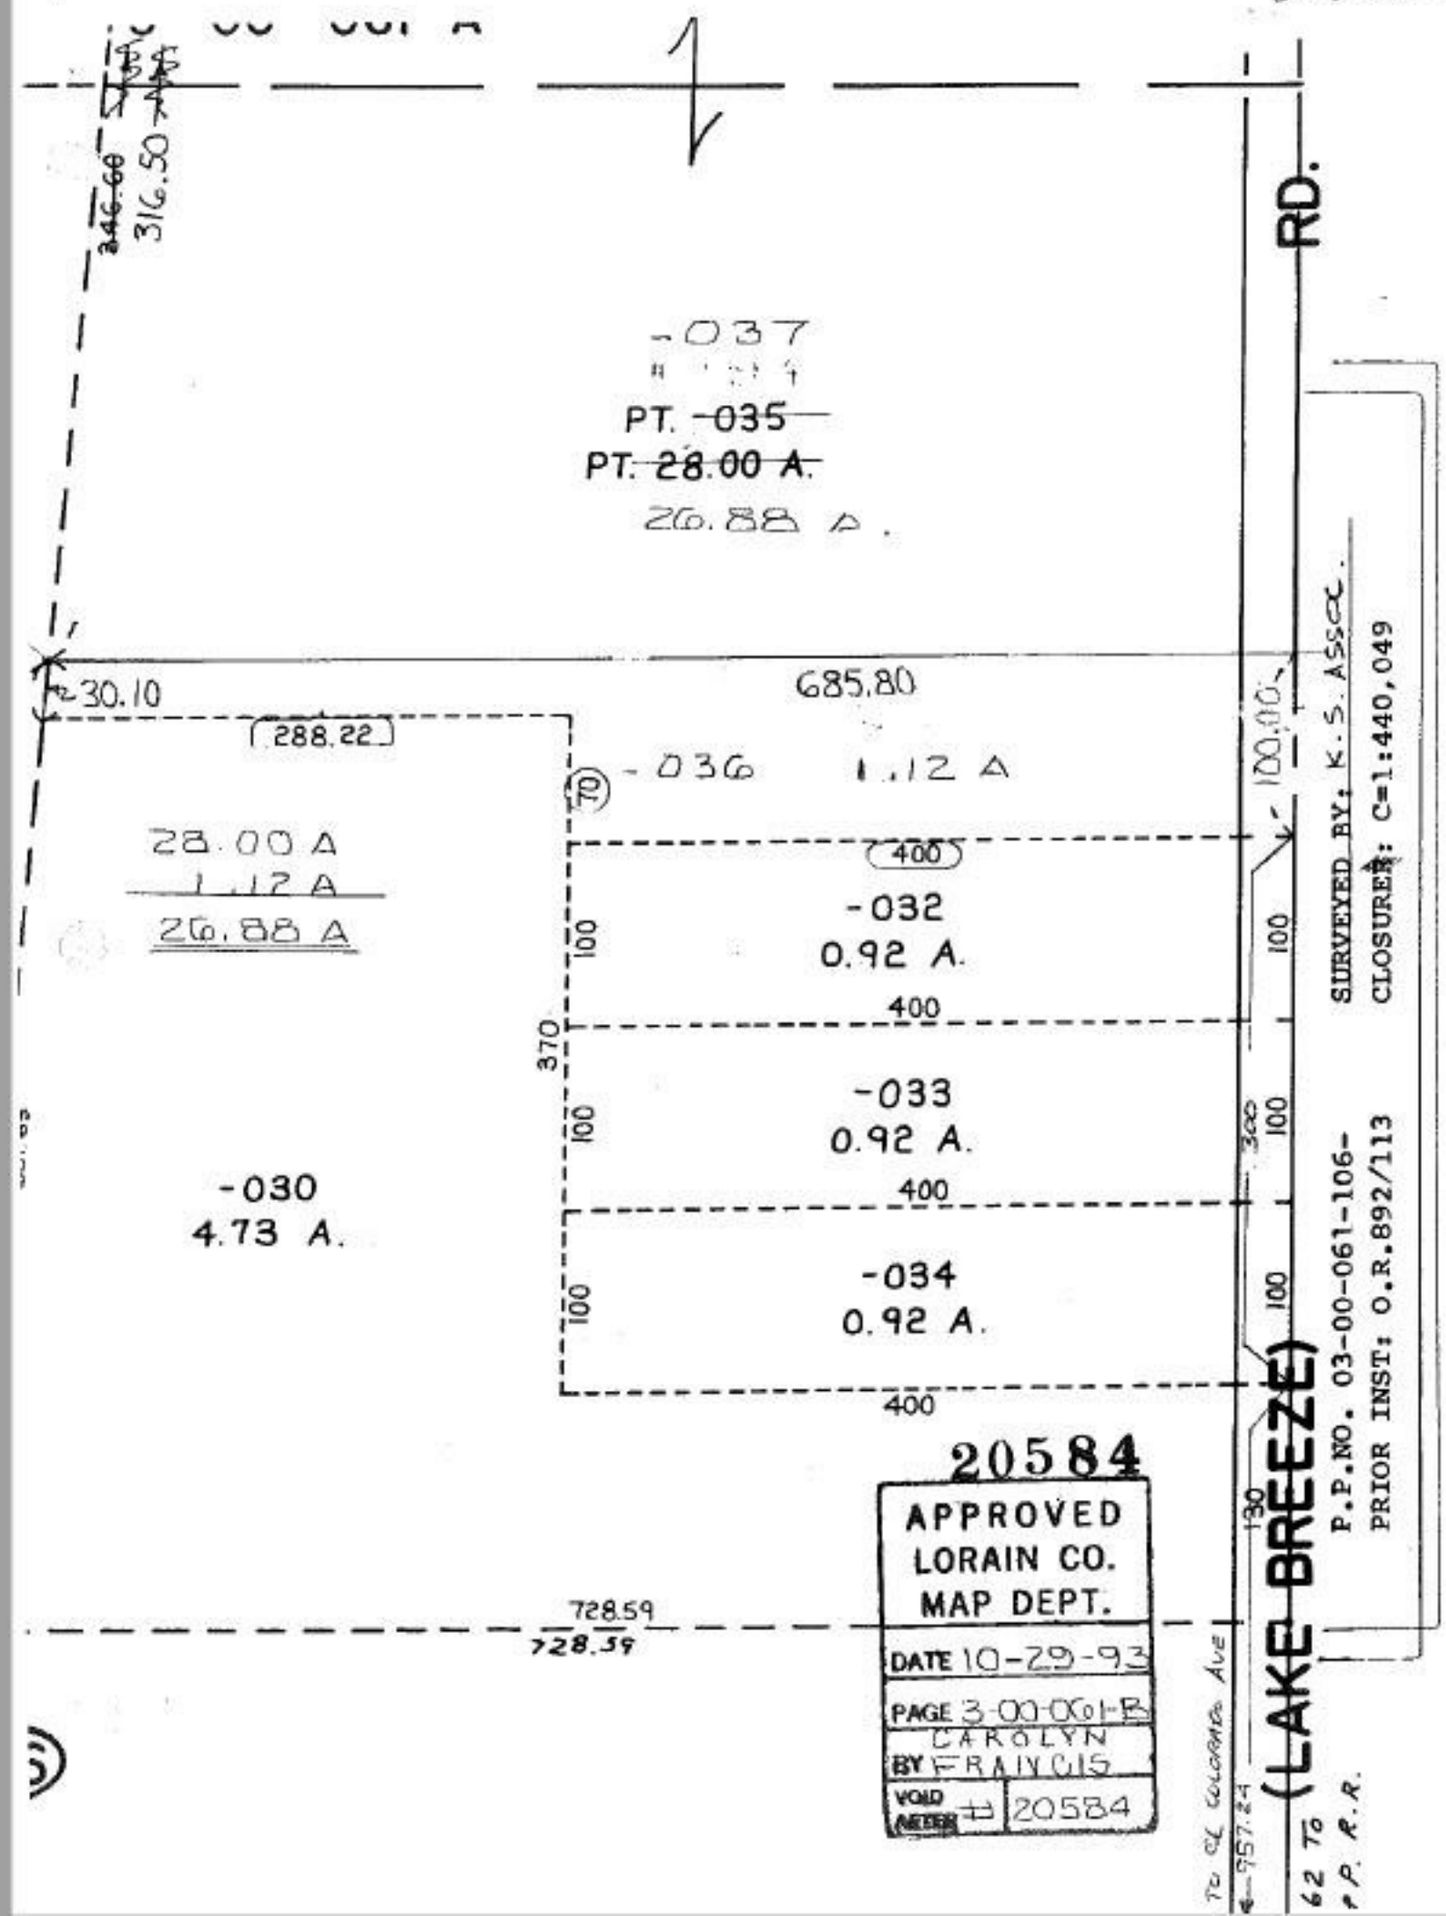

20584

APPROVED
LORAIN CO.
MAP DEPT.

DATE 10-29-93
PAGE 3-00-061-B
BY CAROLYN FRANCIS
VOID AFTER # 20584