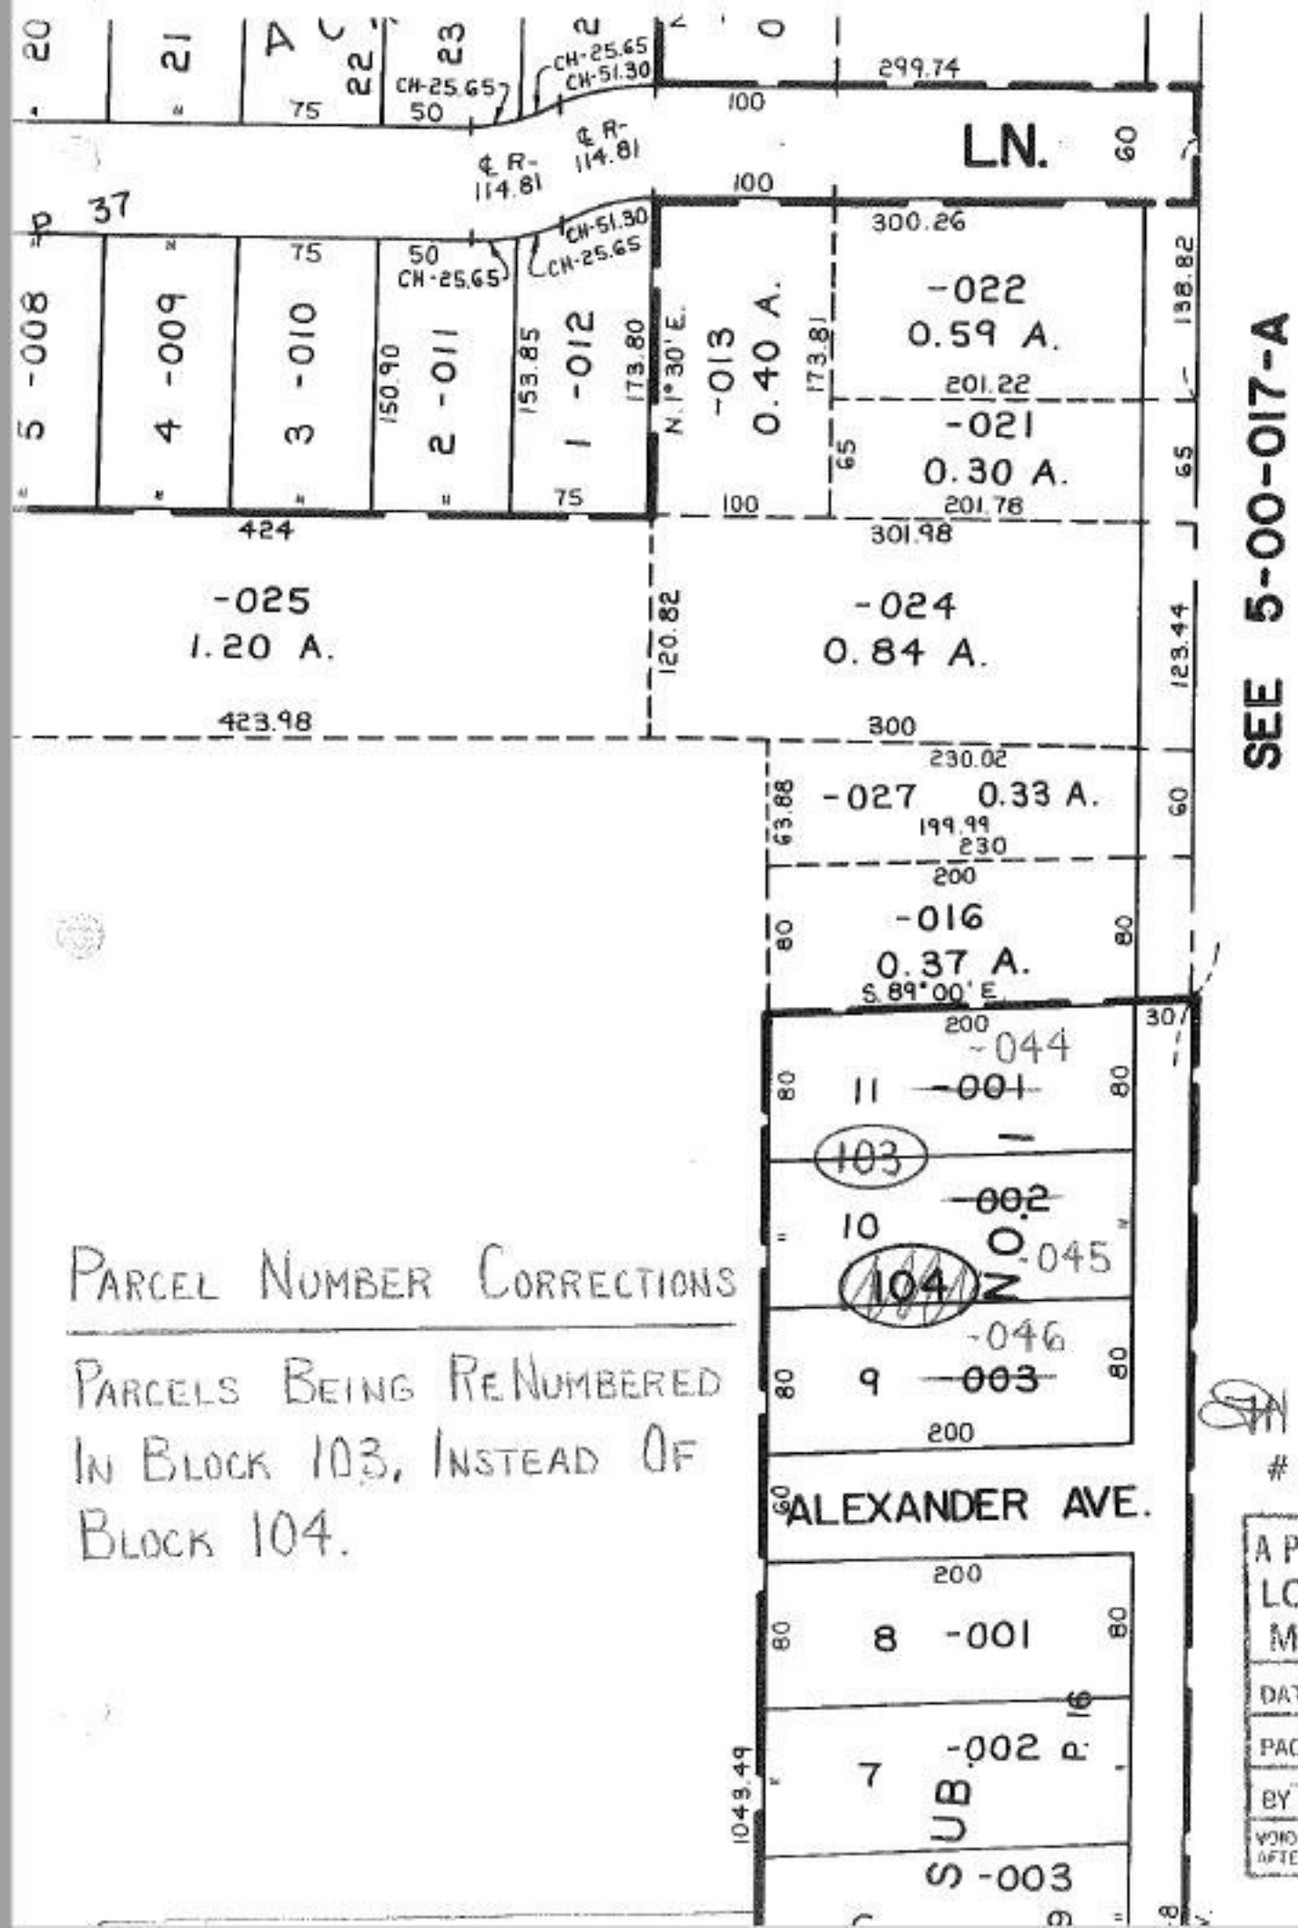

PARCEL NUMBER CORRECTIONS

PARCELS BEING RENUMBERED IN BLOCK 103, INSTEAD OF BLOCK 104.

SN 6/23/94
#20588-0

APPROVED
LORAIN CO.
MAP DEPT.
DATE 1/14/94
PAGE 5-00-004-B
BY T. HOLLIS
VOID AFTER 20588-0