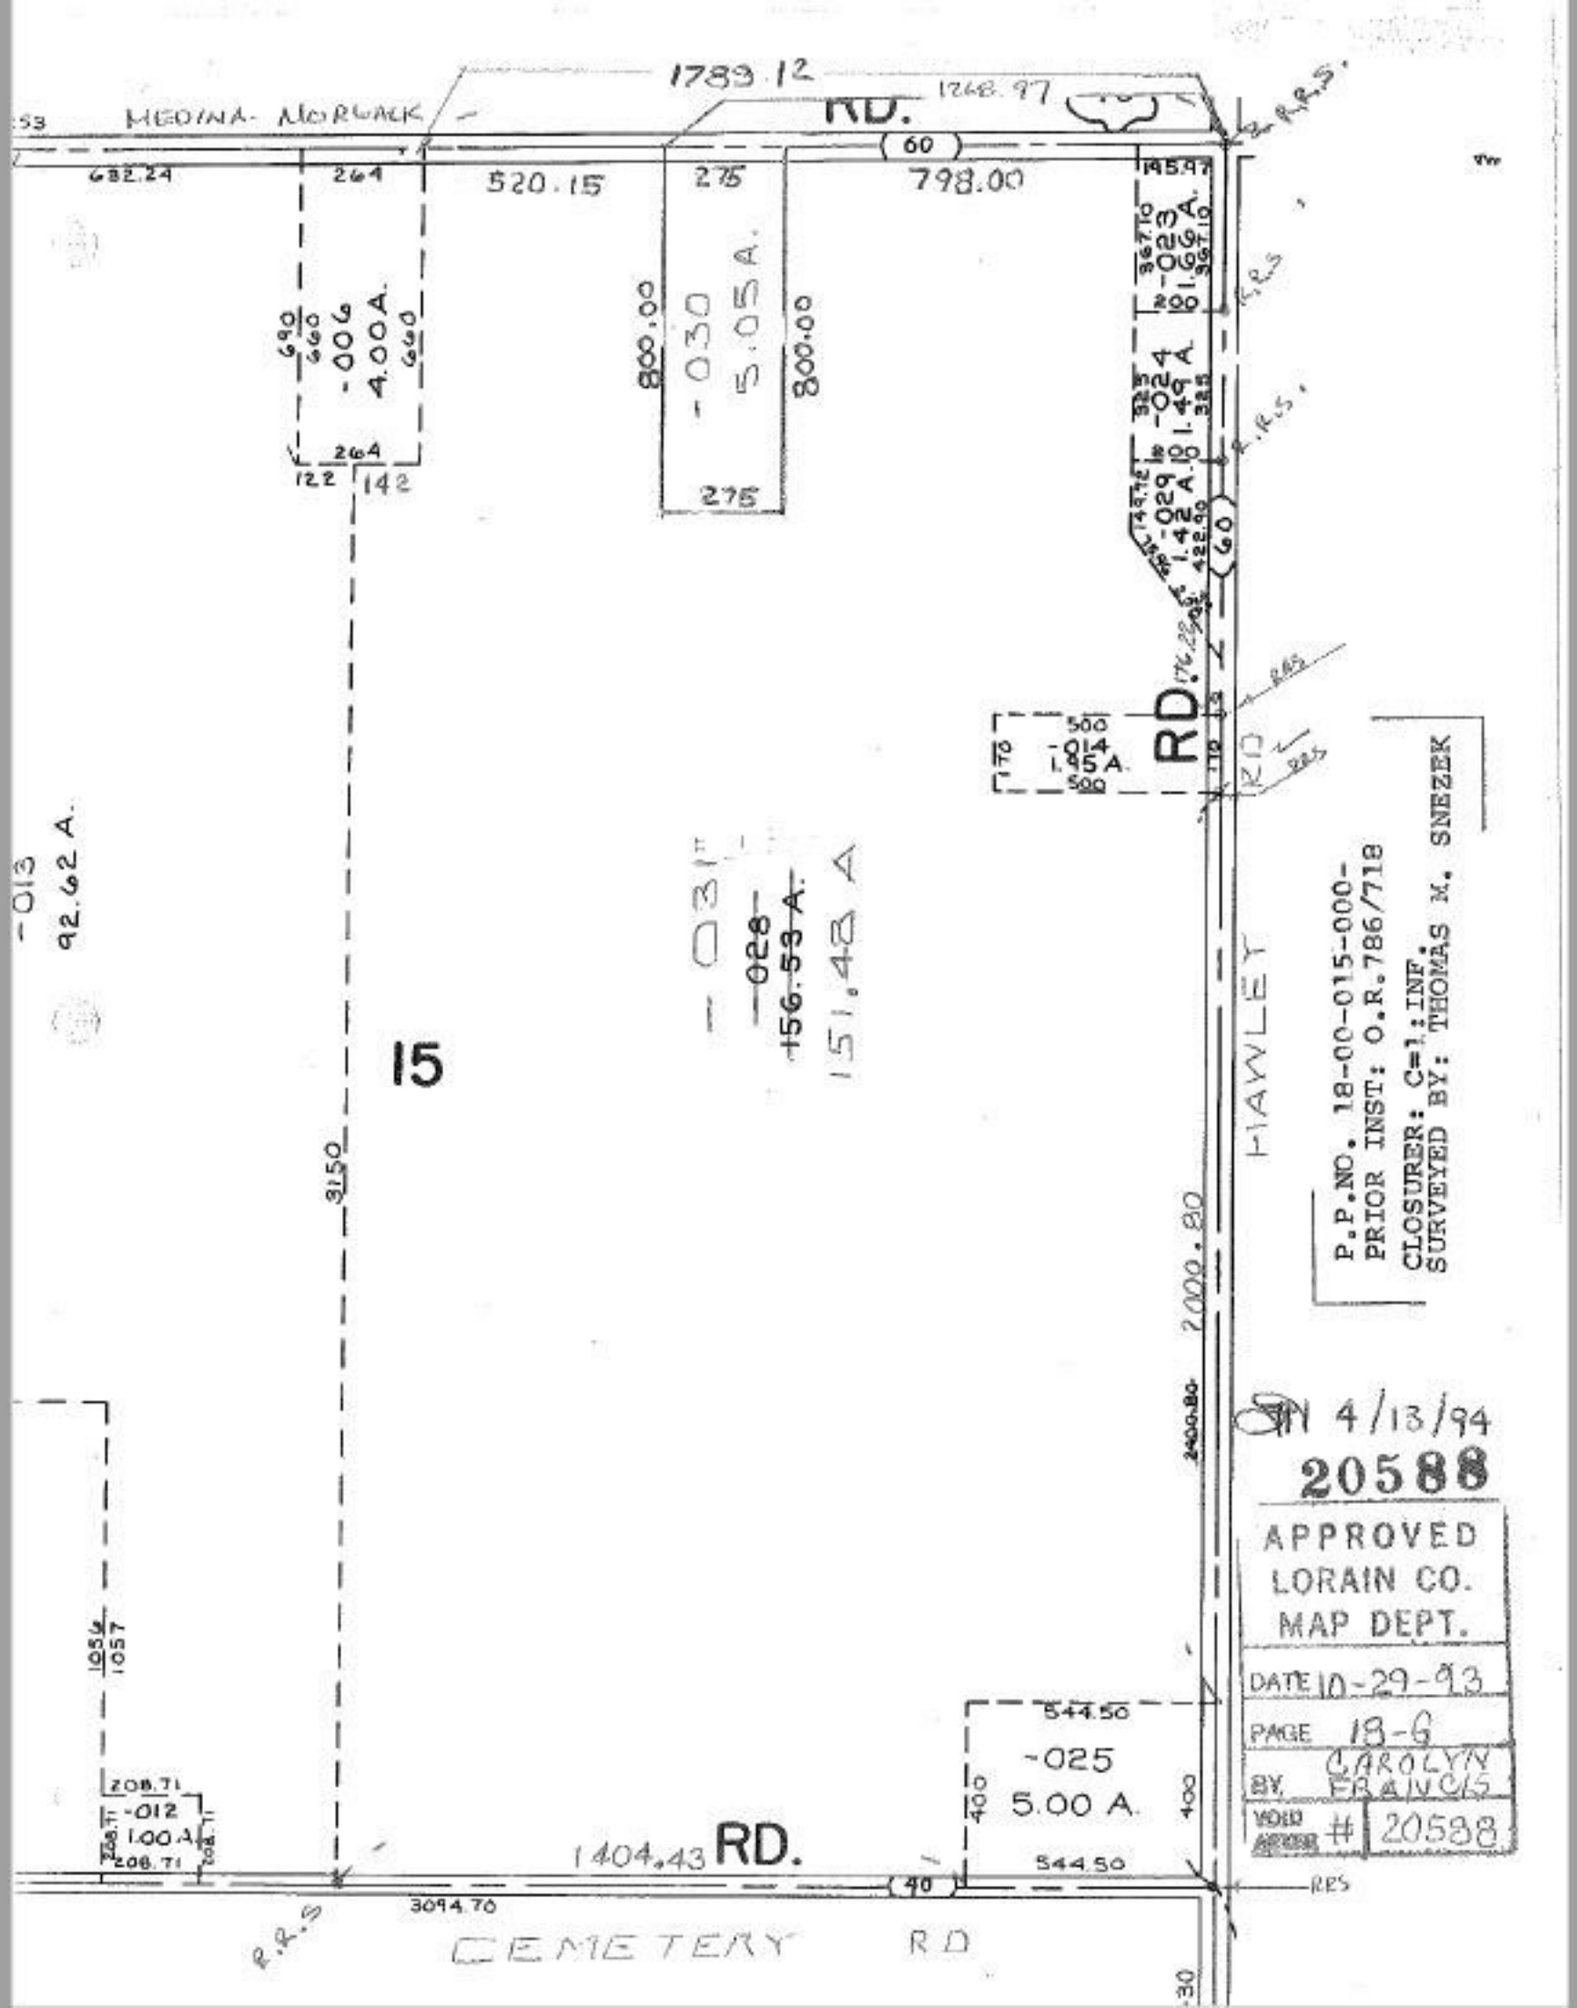

P.P.NO. 18-00-015-000-
PRIOR INST: O.R.786/718
CLOSURER: C=1:INF.
SURVEYED BY: THOMAS M. SNEZEK

4/13/94

20588

APPROVED
LORAIN CO.
MAP DEPT.

DATE 10-29-93
PAGE 18-6
BY CAROLYN FRANCIS
VOID AFTER # 20588