

BROWNHELM STATION

2059

APPROVED
 LORAIN CO.
 MAP DEPT.

DATE: 2/17/69


BY: [Signature]

Map Made by [Signature]

-007
 70.60 F. - Dup.
 68.546 F. Deed
 Atty William H Williams

2059

-007
335.7

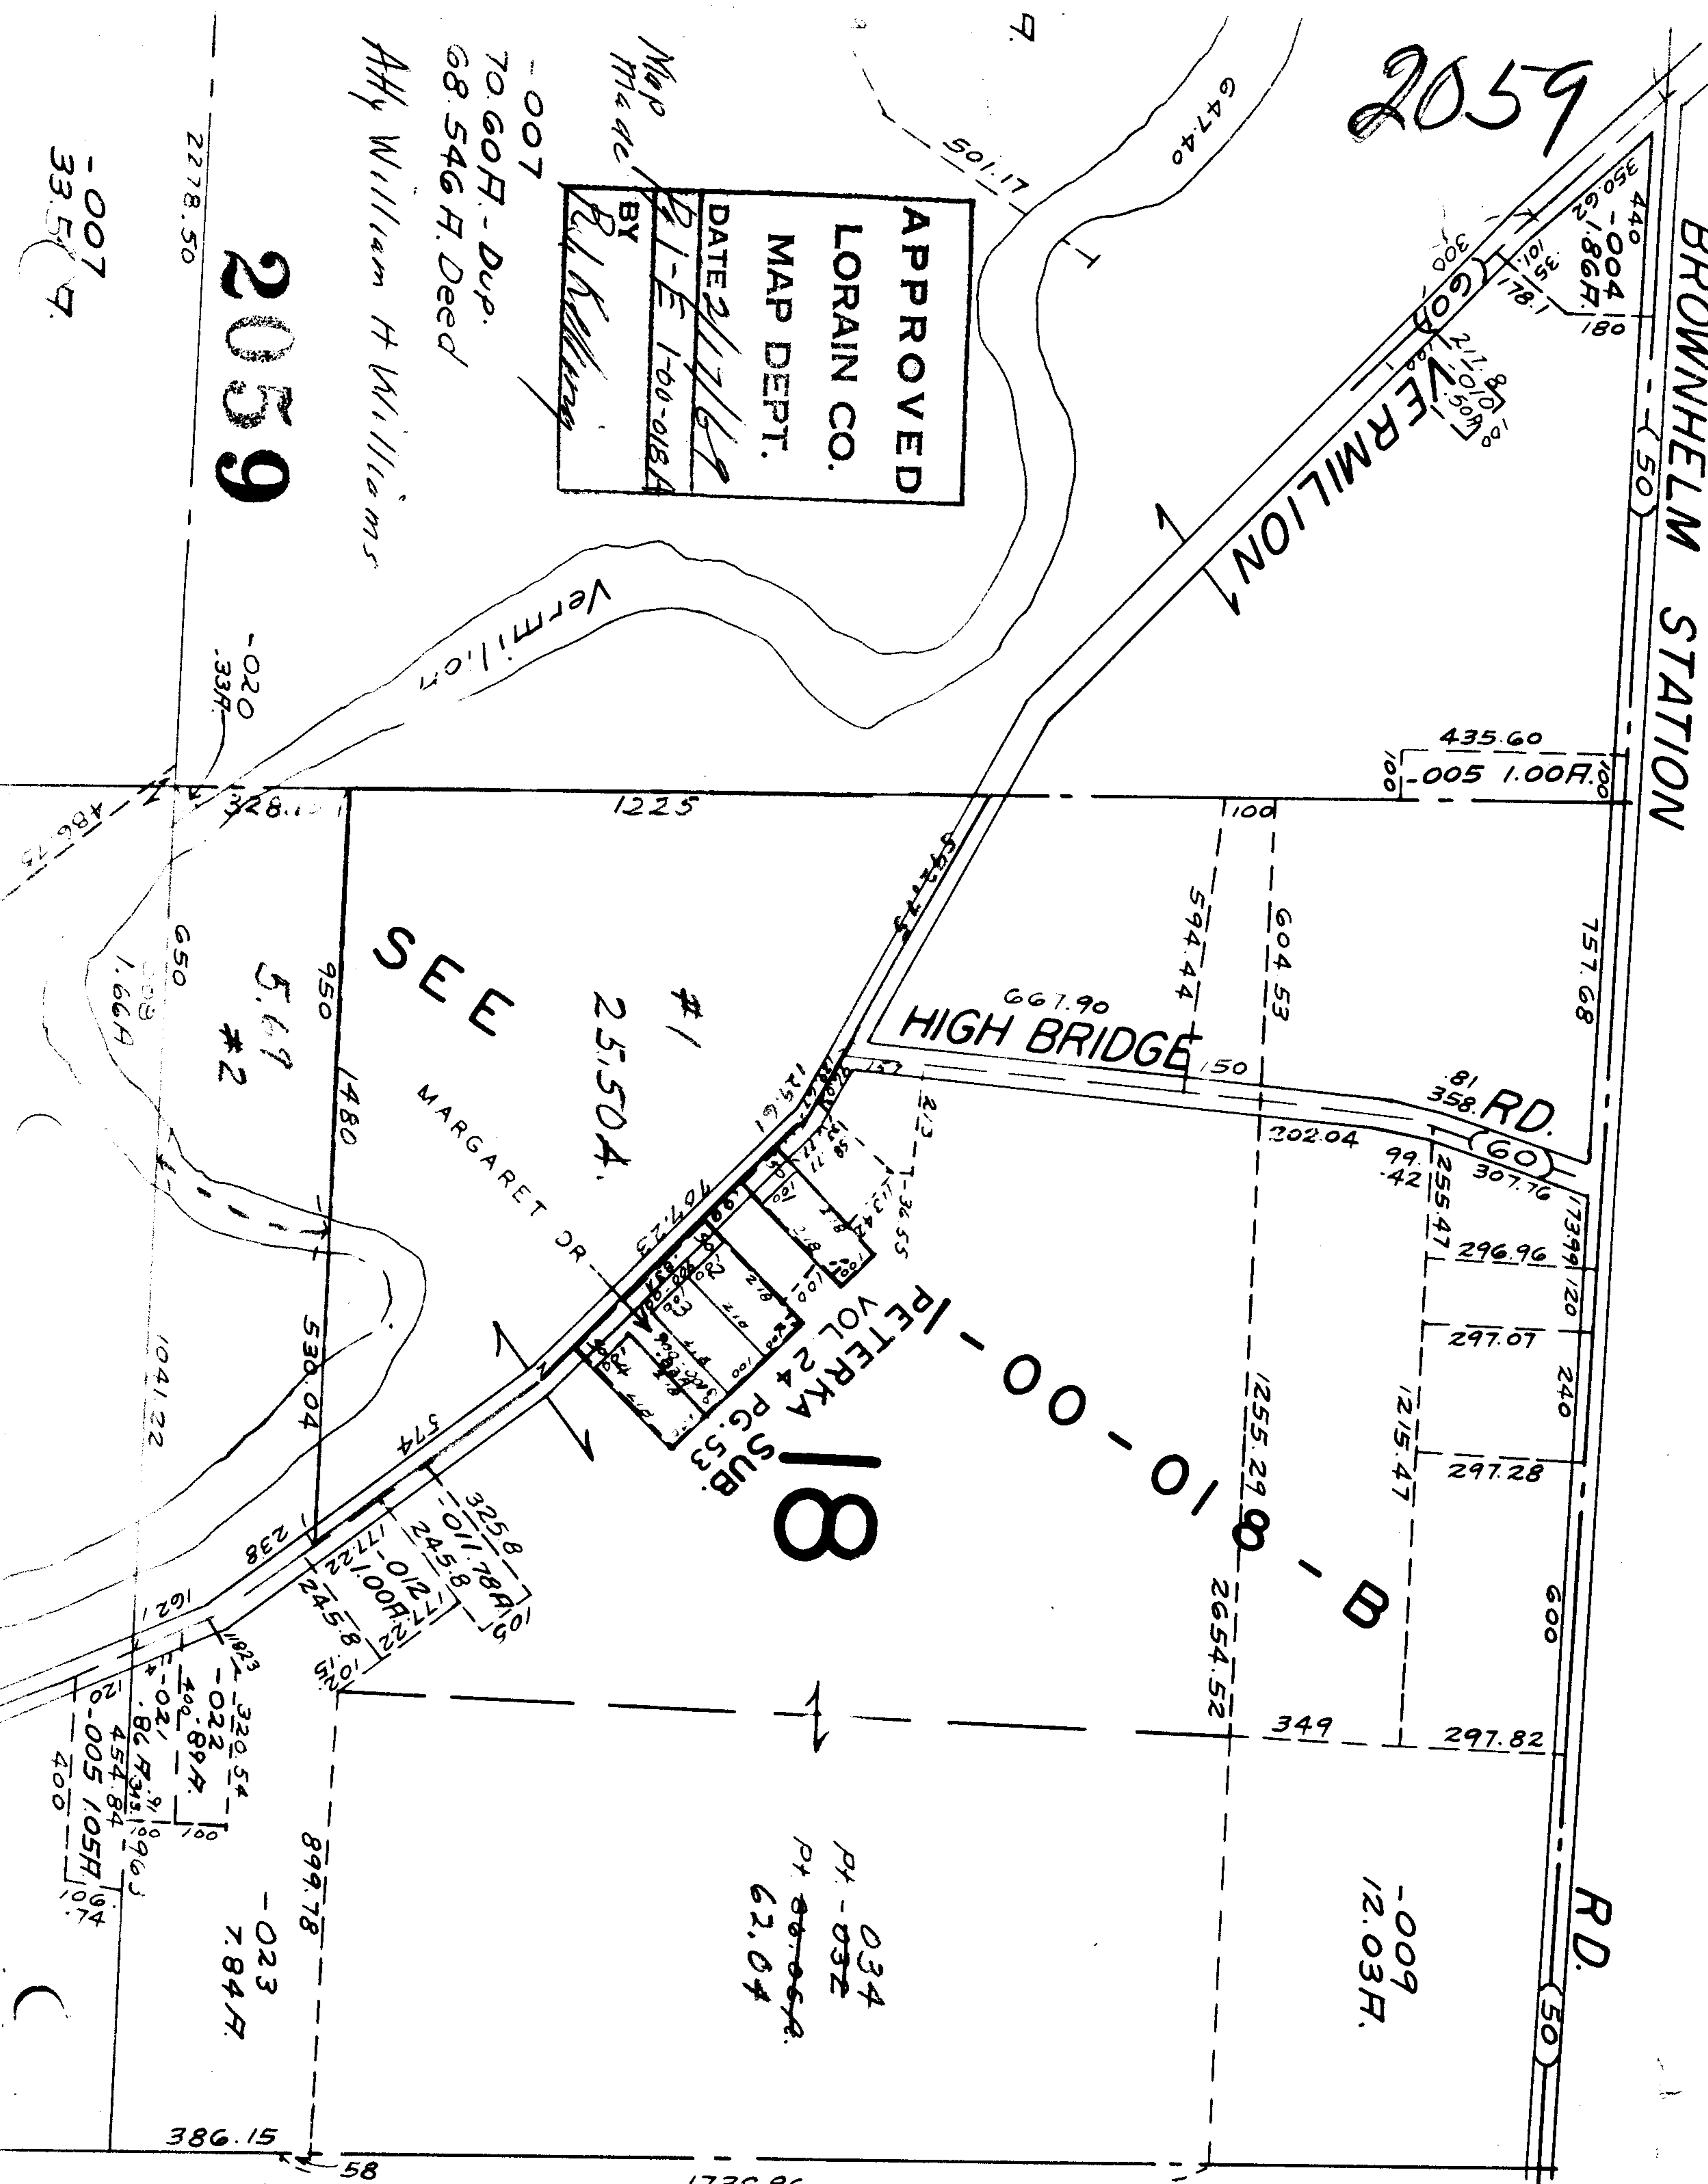

HIGH BRIDGE

S E W

MARGARET DR.

RD. 60

18

034
 Pt - 032
 Pt 88-06A
 62.04

-009
12.03 F.

-023
7.84 F.

386.15

1732.96

RD. 50