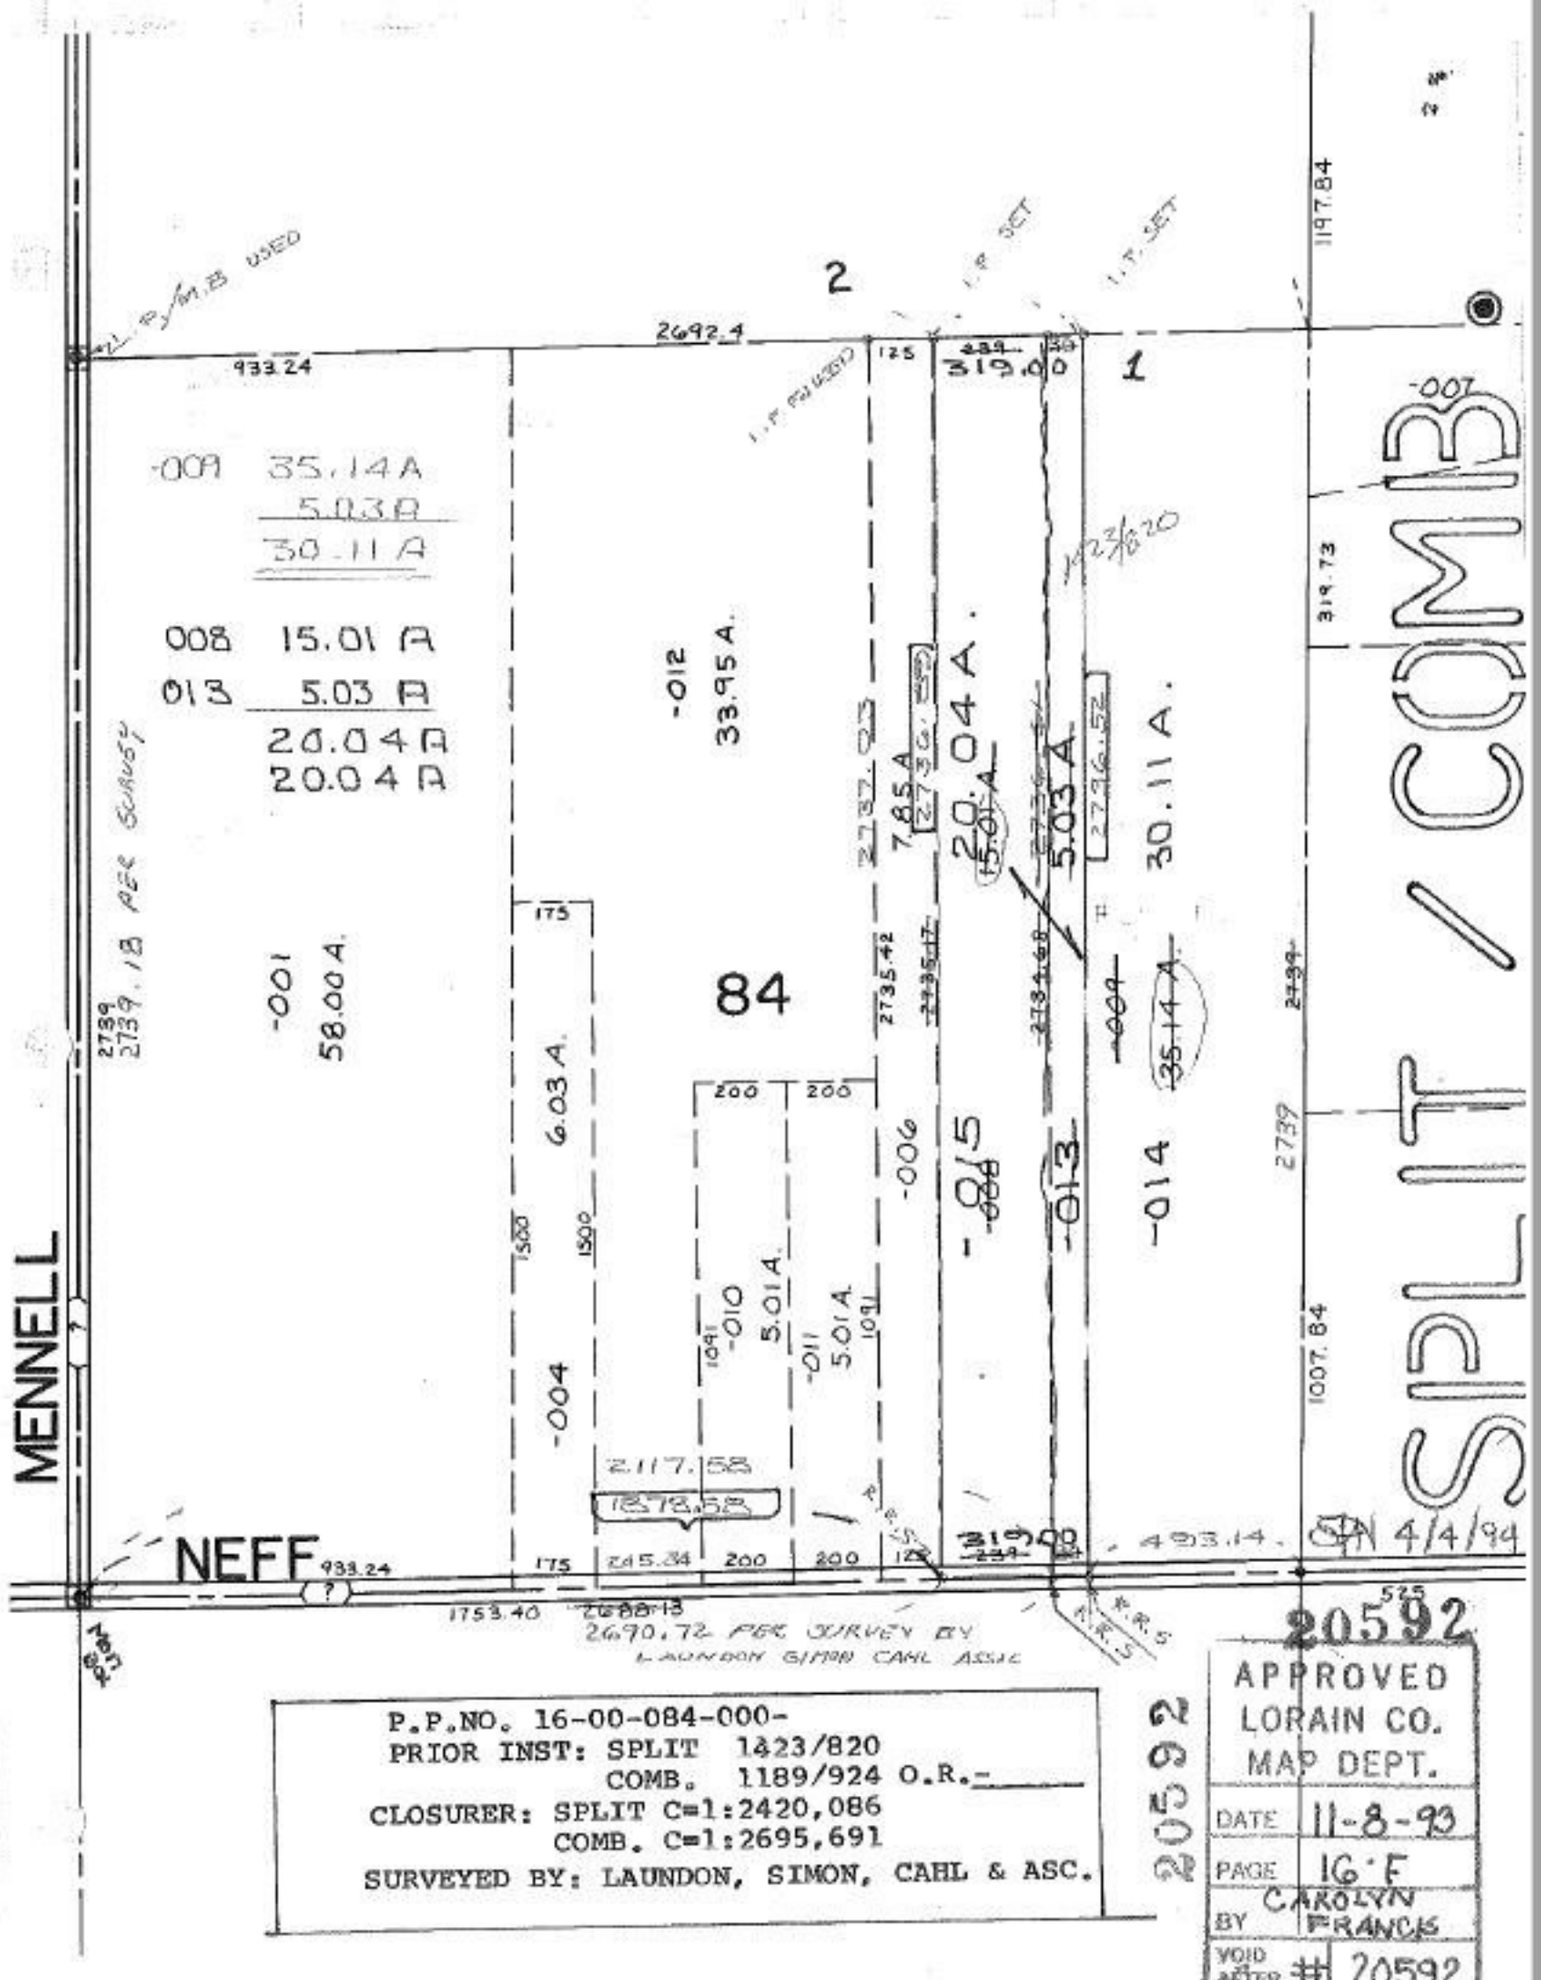

P.P.NO. 16-00-084-000-
PRIOR INST: SPLIT 1423/820
COMB. 1189/924 O.R.-
CLOSURER: SPLIT C=1:2420,086
COMB. C=1:2695,691
SURVEYED BY: LAUNDON, SIMON, CAHL & ASC.

20592

APPROVED
LORAIN CO.
MAP DEPT.
DATE 11-8-93
PAGE 16 F
BY CAROLYN FRANCIS
VOID AFTER # 20592