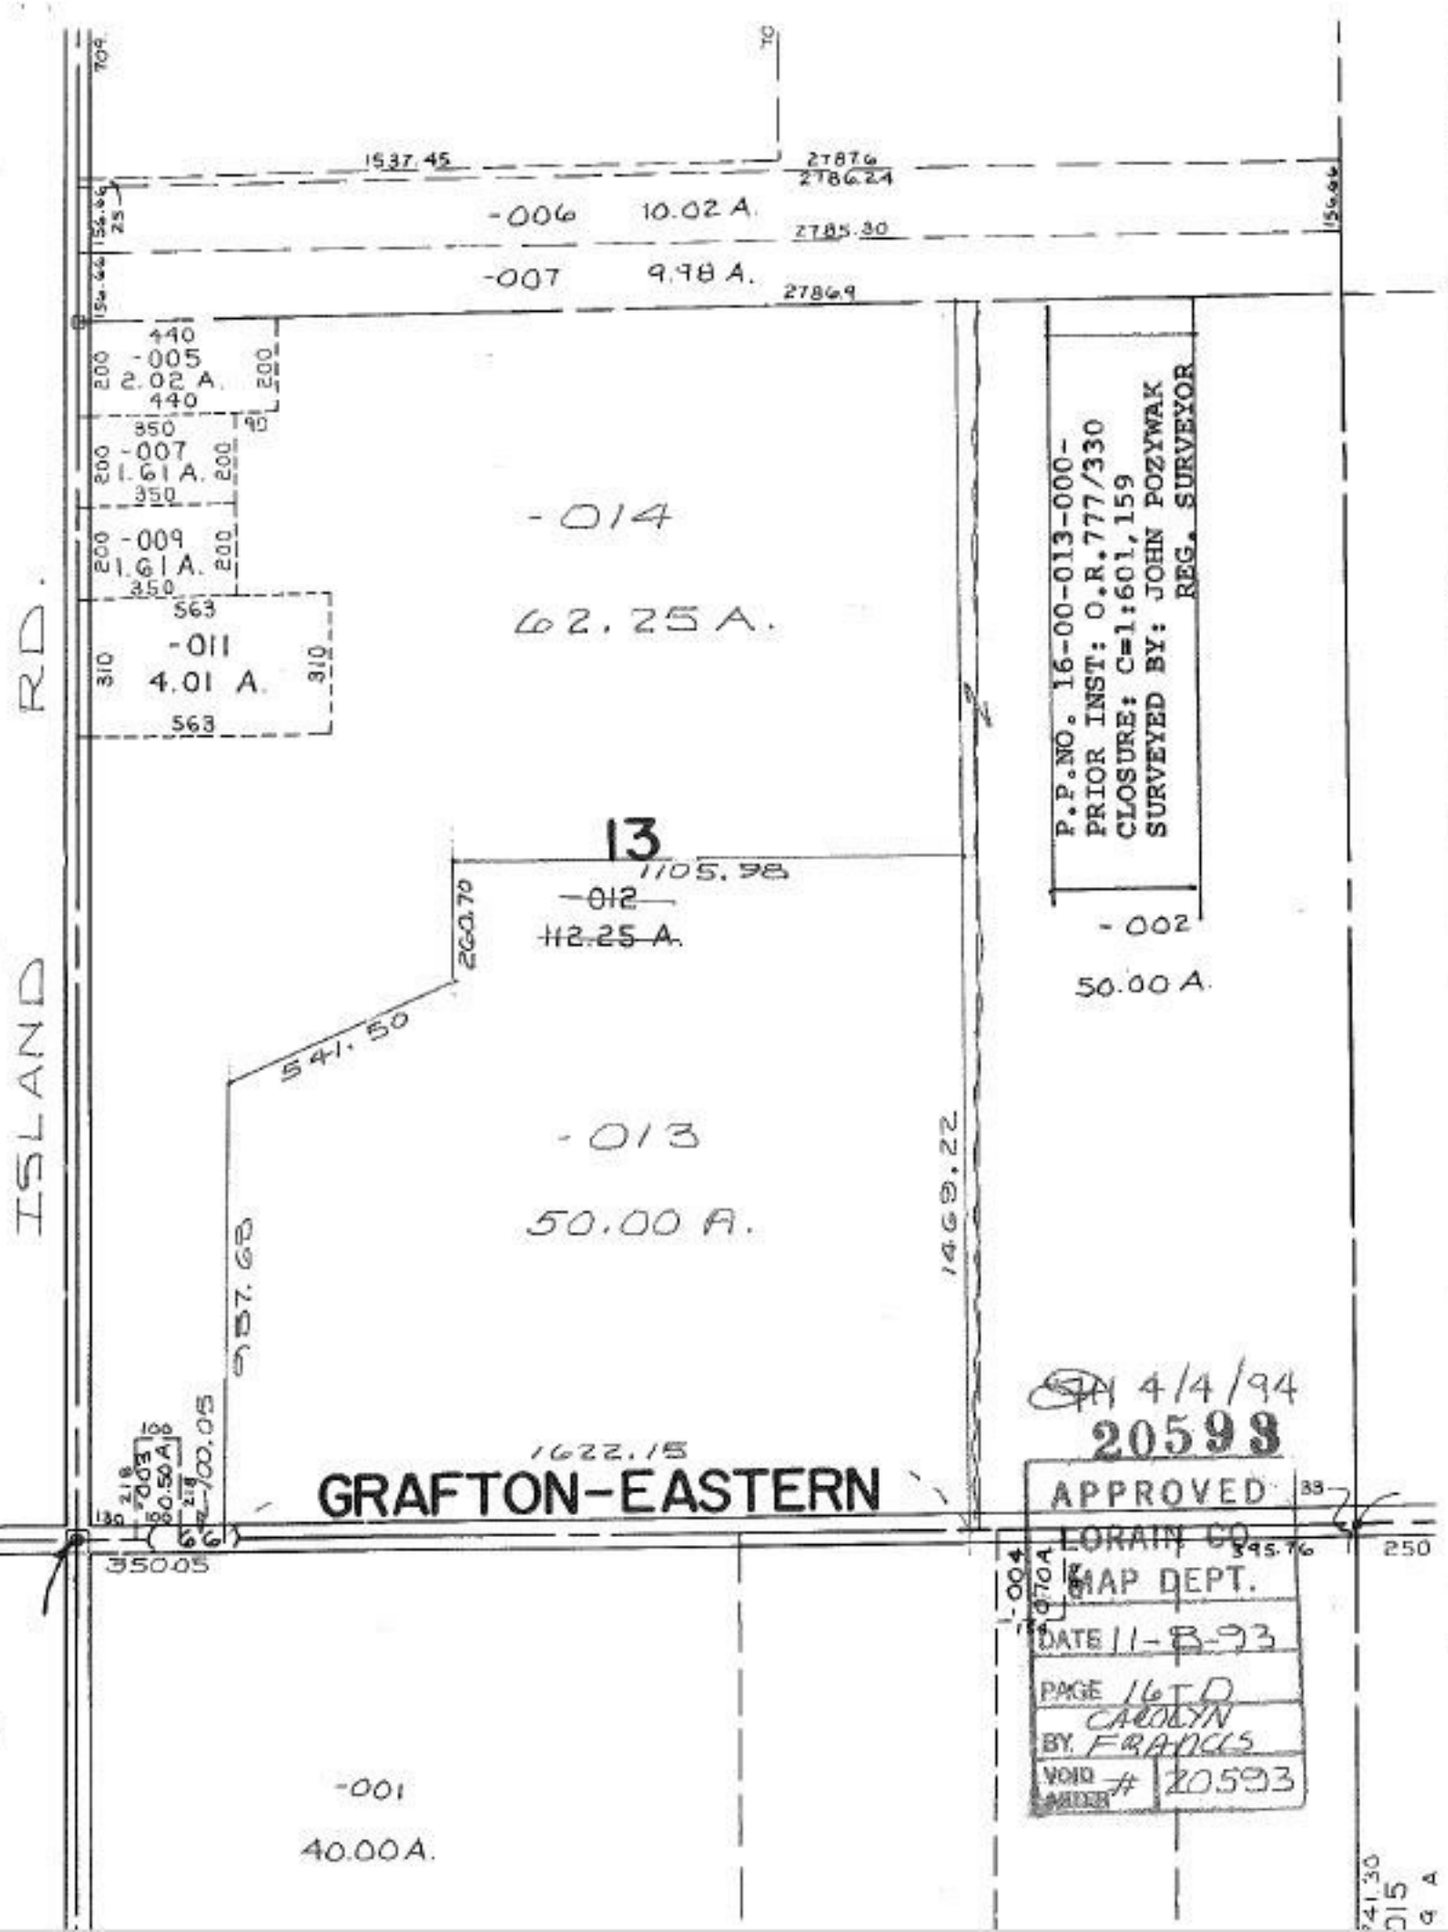

1537.45
2787.6
2786.24
-006 10.02 A.
2785.30
-007 9.98 A.
2786.9
440
-005
2.02 A.
440
350
-007
1.61 A.
350
-009
1.61 A.
350
563
-011
4.01 A.
563
-014
62.25 A.
P.P.NO. 16-00-013-000-
PRIOR INST: O.R.777/330
CLOSURE: C=1:601,159
SURVEYED BY: JOHN POZYWAK
REG. SURVEYOR
13
1105.98
-012
112.25 A.
260.70
-002
50.00 A.
541.50
-013
50.00 A.
1469.22
957.68
ISLAND RD.
4/4/94
20593
1622.15
GRAFTON-EASTERN
350.05
395.76
250
APPROVED
LORAIN CO.
MAP DEPT.
DATE 11-8-93
PAGE 16-D
BY CAROLYN FRANCIS
VOID ORDER # 20593
-001
40.00 A.