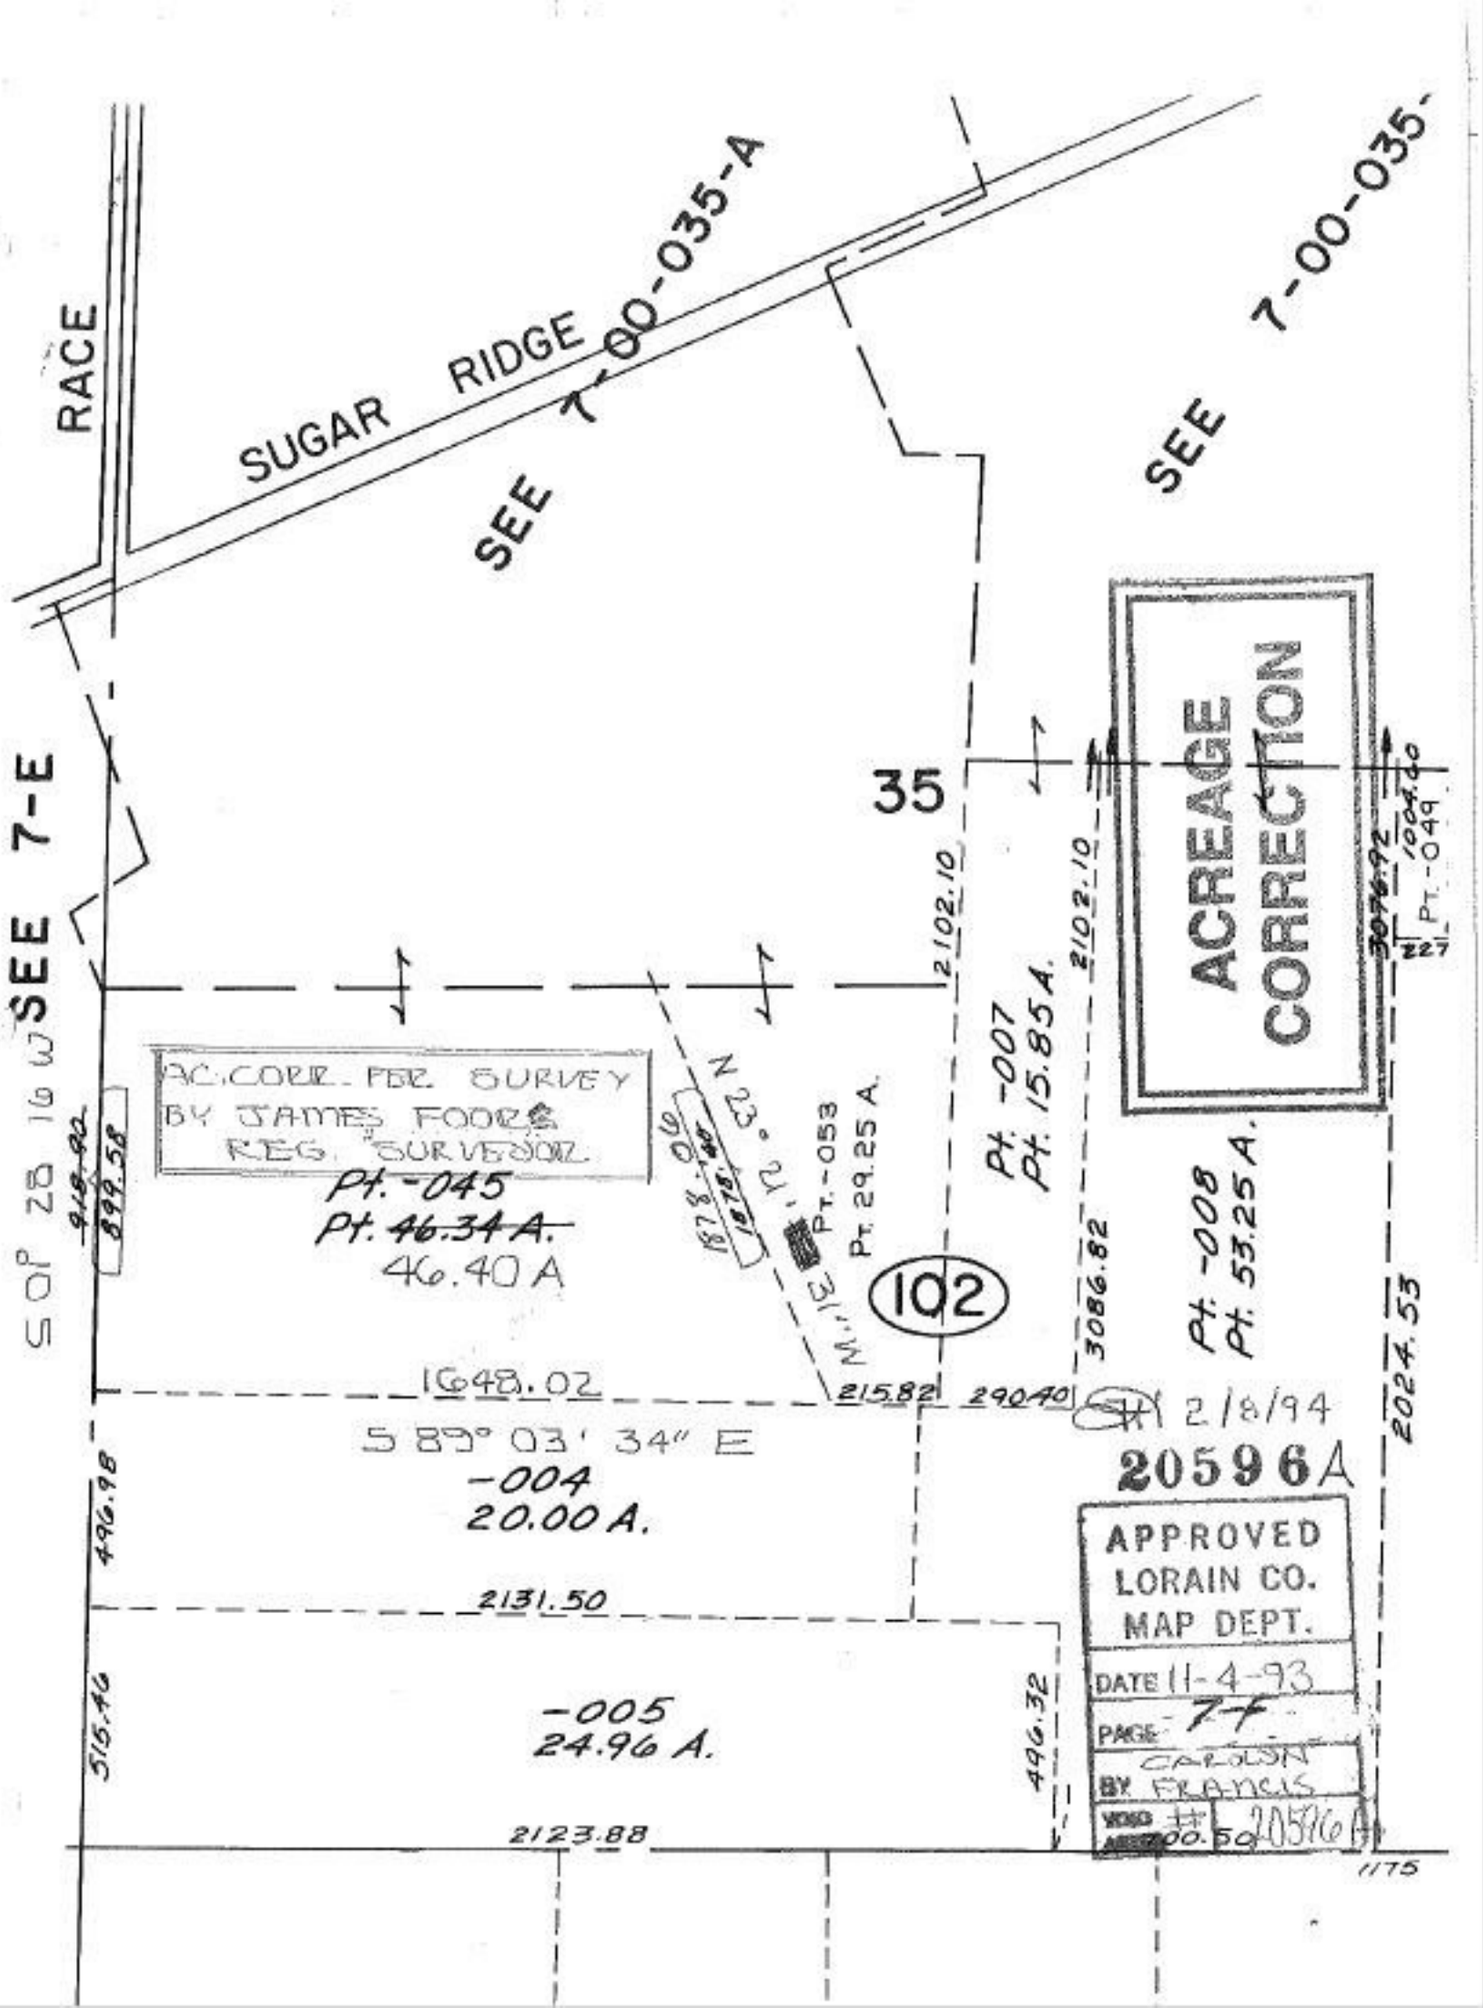
RACE
SUGAR RIDGE
SEE 7-00-035-A
SEE 7-00-035-
SEE 7-E
35
102
AC. CORR. PER SURVEY BY JAMES FOOR REG. SURVEYOR
Pt.-045
Pt. 46.34 A.
46.40 A
Pt.-053
Pt. 29.25 A.
Pt. -007
Pt. 15.854.
Pt. -008
Pt. 53.25 A.
ACREAGE CORRECTION
Pt.-049
S 0° 28' 16" W
N 23° 21' 31" W
S 89° 03' 34" E
-004
20.00 A.
-005
24.96 A.
2102.10
3086.82
2024.53
1648.02
2131.50
2123.88
496.98
496.32
315.46
215.82
290.40
1175
2/8/94
20596A
APPROVED
LORAIN CO.
MAP DEPT.
DATE 11-4-93
PAGE 7-F
BY CAROLYN FRANCIS
VOID # 20596A
00.50