20596

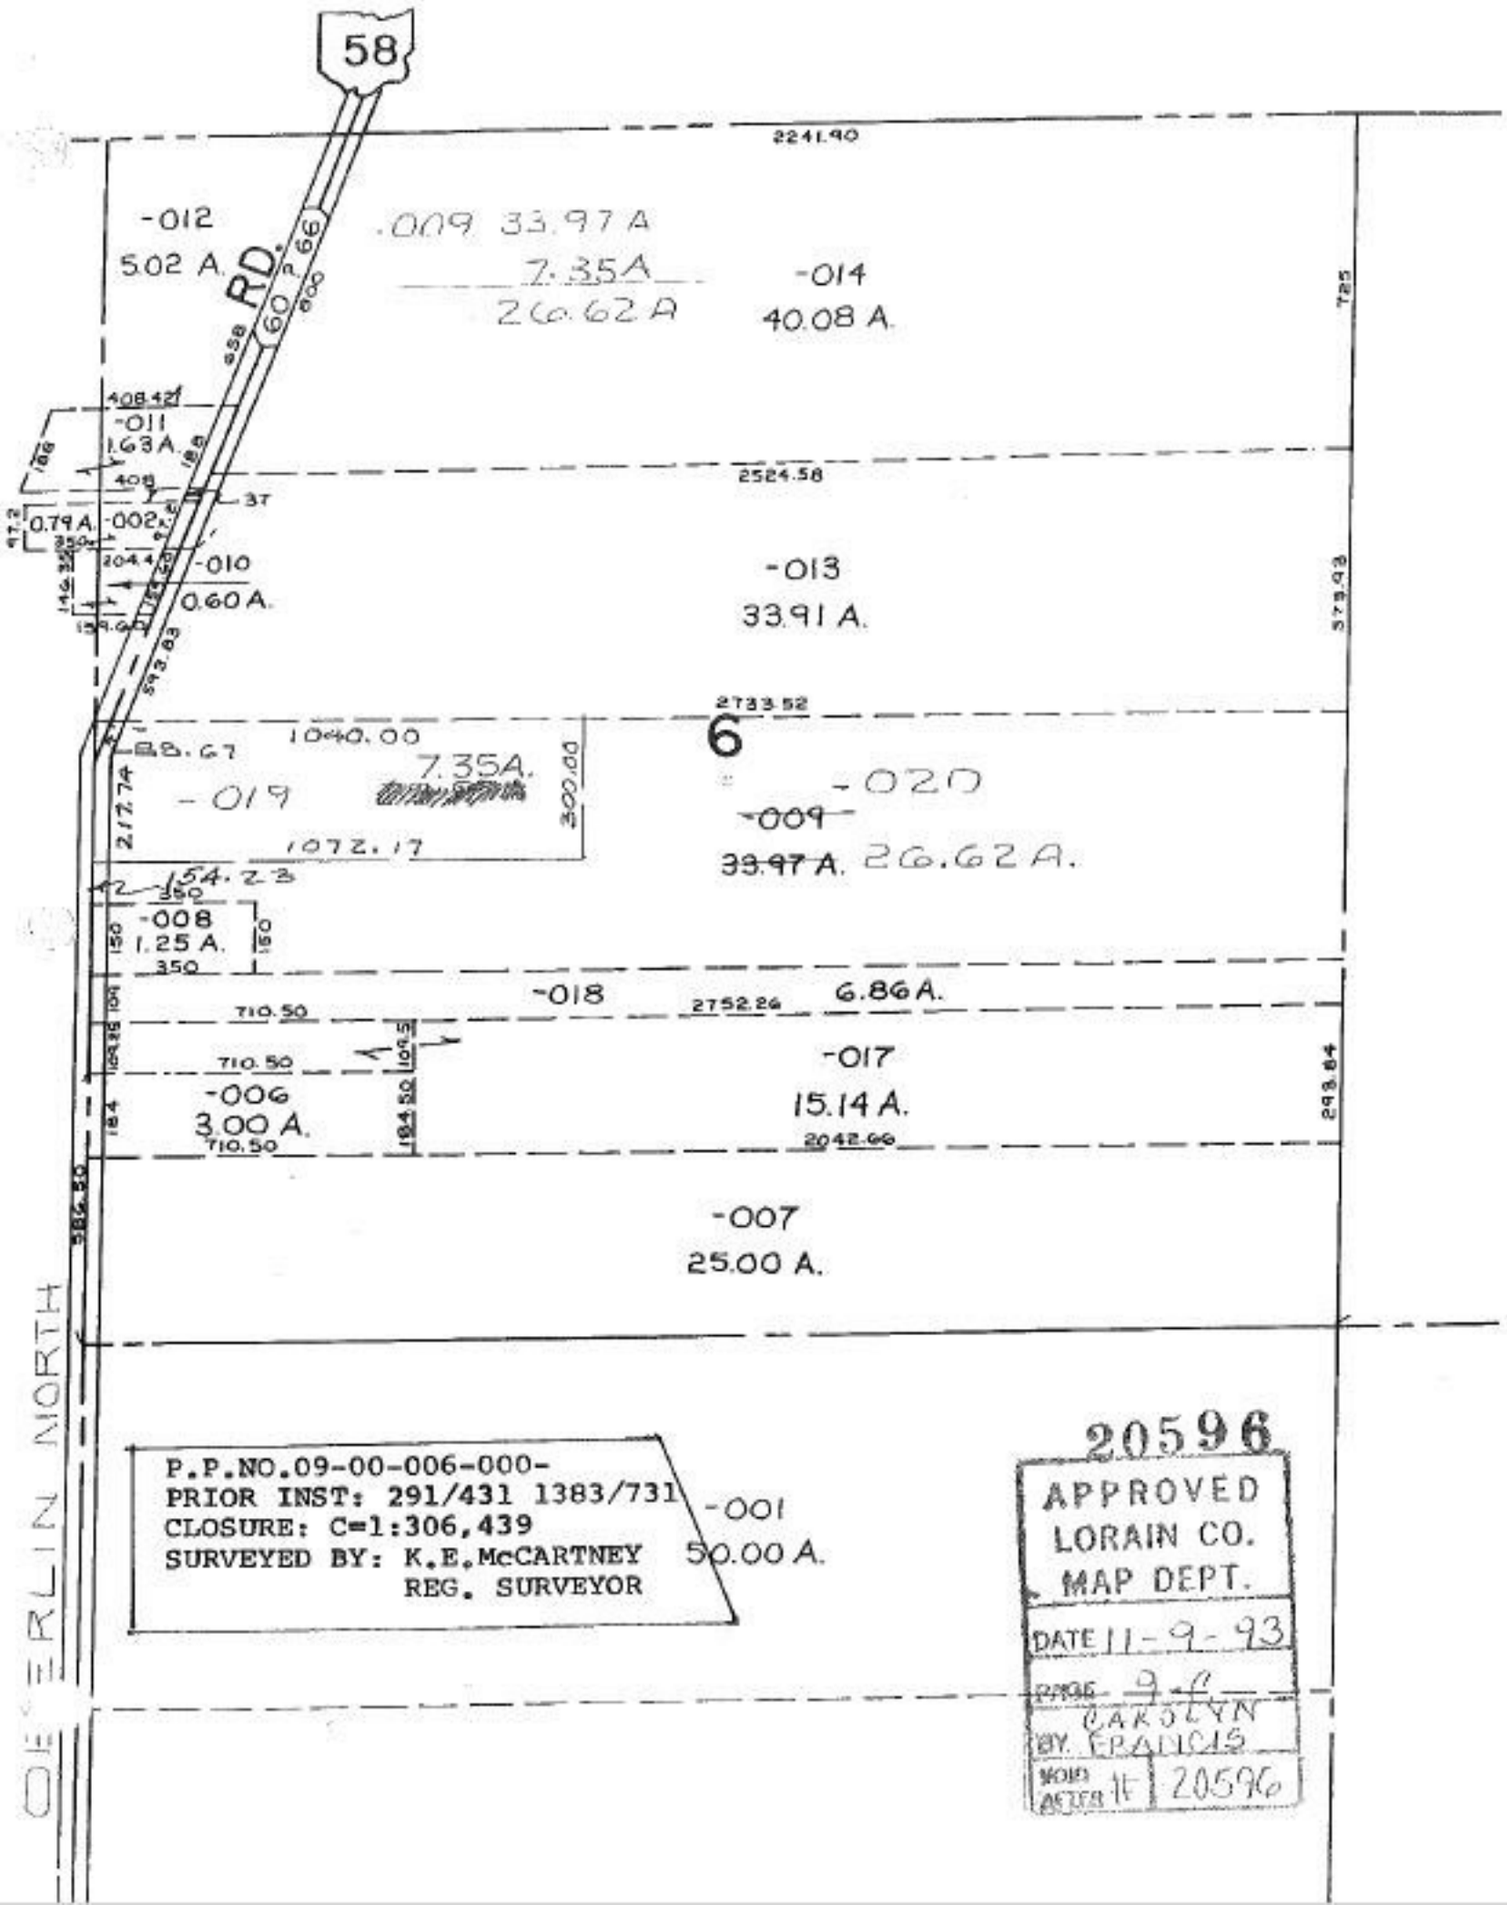
58
RD.
60
66
558
600
2241.90
-012
5.02 A.
.009 33.97 A
7.35A
26.62 A
-014
40.08 A.
725
408.42
-011
1.63 A.
186
408
37
2524.58
0.79 A.
-002
-010
0.60 A.
593.83
-013
33.91 A.
379.93
2733.52
6
1040.00
88.67
7.35A.
-019
212.74
300.00
1072.17
-020
-009
33.97 A.
26.62 A.
154.23
350
-008
1.25 A.
150
350
-018
2752.24
6.86 A.
710.50
710.50
-017
15.14 A.
-006
3.00 A.
710.50
184.50
2042.66
293.64
386.50
-007
25.00 A.
OBERLIN NORTH
P.P.NO.09-00-006-000-
PRIOR INST: 291/431 1383/731
CLOSURE: C=1:306,439
SURVEYED BY: K.E.McCARTNEY
REG. SURVEYOR
-001
50.00 A.
20596
APPROVED
LORAIN CO.
MAP DEPT.
DATE 11-9-93
CAROLYN
BY FRANCIS
MOVED AFTER 11
20596