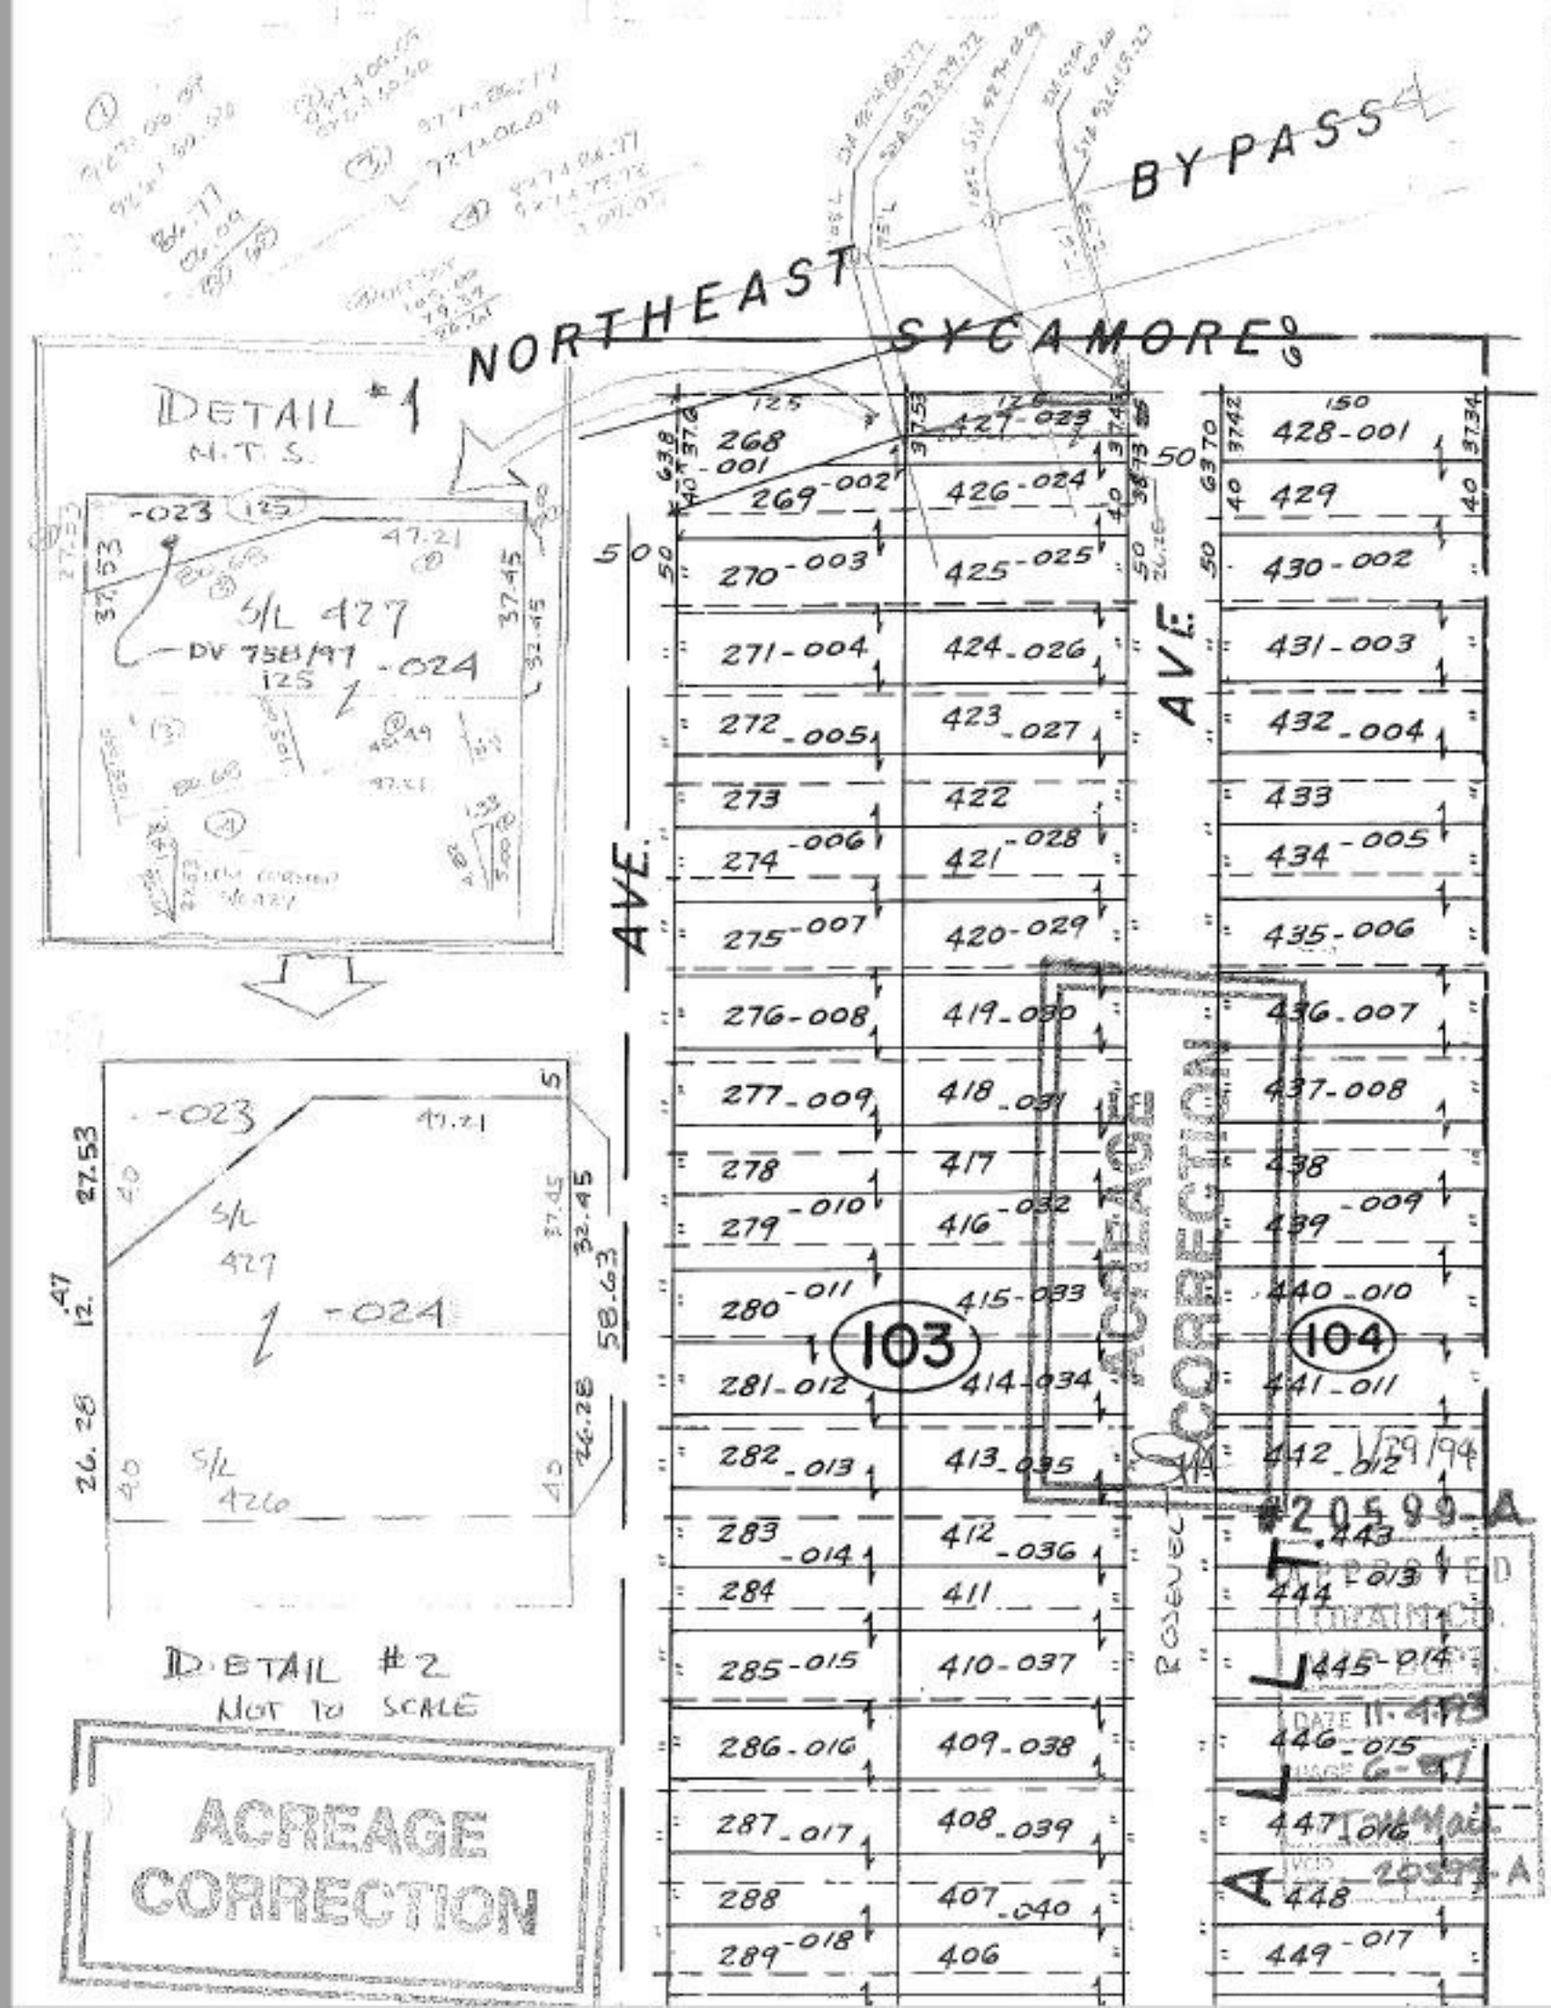
NORTHEAST BYPASS
SYCAMORE
DETAIL #1
N.T.S.
S/L 427
DV 758/97
-023
-024
125
47.21
37.53
37.45
32.45
DETAIL #2
NOT TO SCALE
S/L 427
S/L 426
27.53
26.28
58.63
AVE.
103
104
ROSEVELT
ACREAGE CORRECTION
ACREAGE CORRECTION
1/29/94
#20599-A
APPROVED
LORAIN CO.
DATE 11-4-93
PAGE 6-97
VOID 20599-A