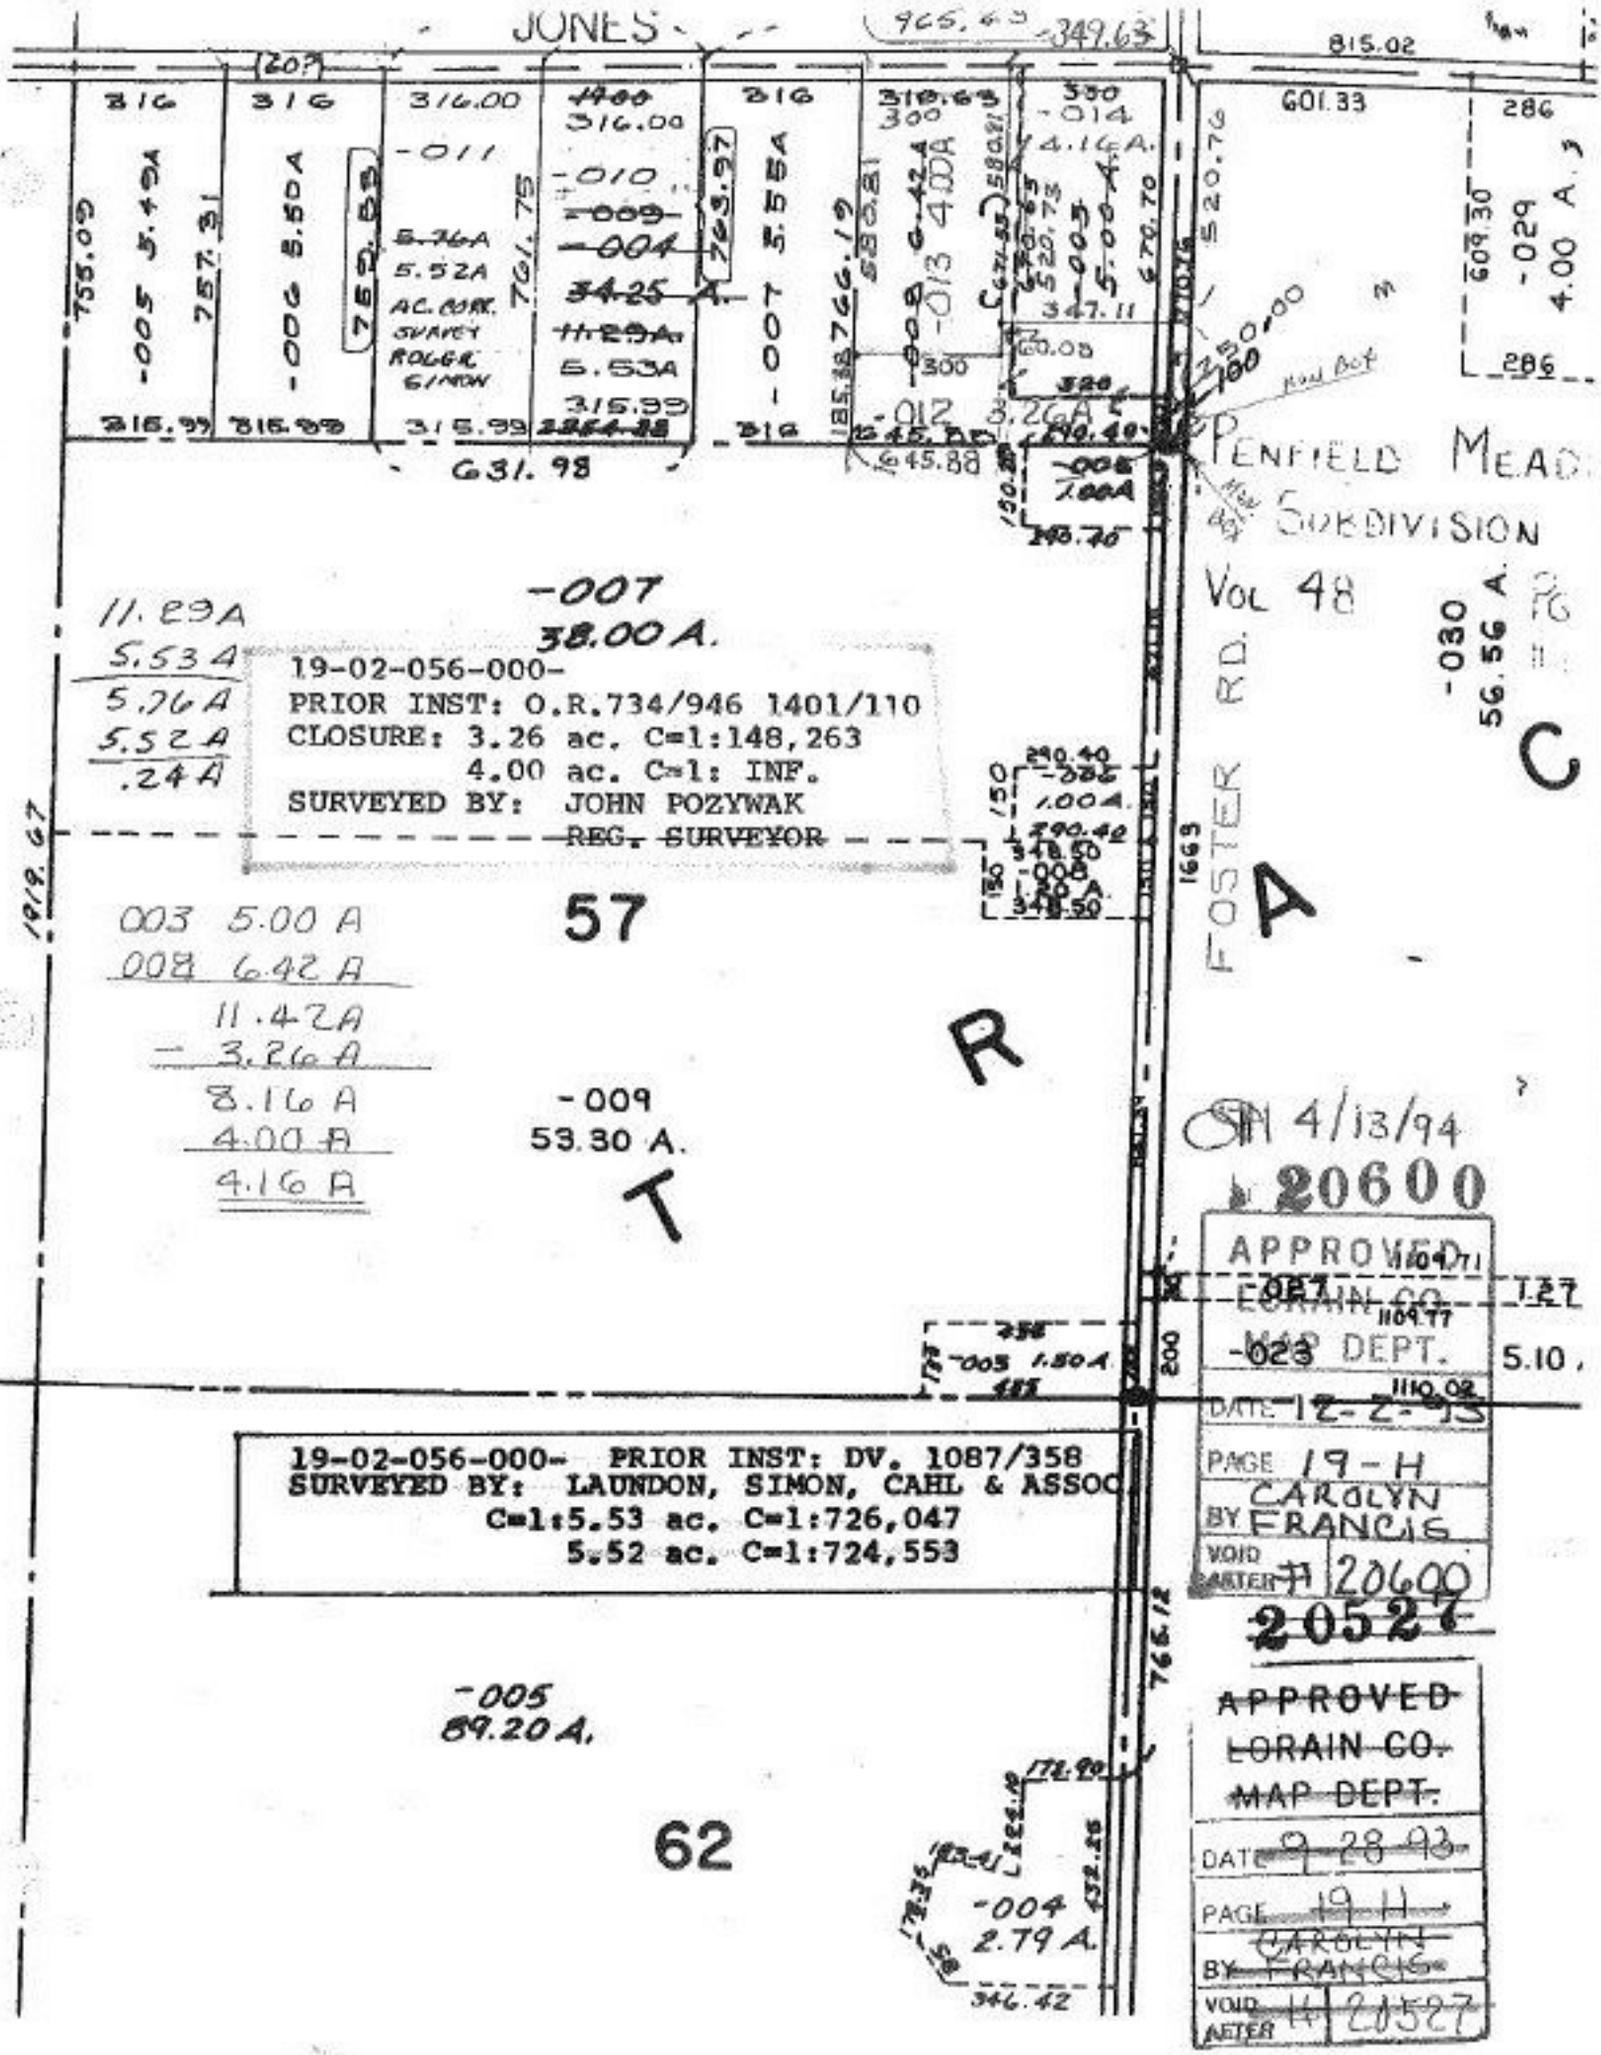
JONES
965.63
349.63
815.02
601.33
286
316
316.00
-011
5.76A
5.52A
AC. CORR. SURVEY ROGER SIMON
-010
-009
-004
34.25 A.
11.29A
5.53A
315.99
-005 5.49A
-006 5.50A
-007 5.55A
-013 4.00A
-014
4.16A.
-012 3.26A
-029 4.00 A.
-030 56.56 A.
631.98
645.88
PENFIELD MEAD. SUBDIVISION
VOL 48
FOSTER RD.
-007
38.00 A.
11.29A
5.53A
5.76A
5.52A
.24A
19-02-056-000-
PRIOR INST: O.R.734/946 1401/110
CLOSURE: 3.26 ac. C=1:148,263
4.00 ac. C=1: INF.
SURVEYED BY: JOHN POZYWAK
REG. SURVEYOR
57
003 5.00 A
008 6.42 A
11.42A
- 3.26 A
8.16 A
4.00 A
4.16 A
-009
53.30 A.
T R A C
1919.67
-003 1.50A
19-02-056-000- PRIOR INST: DV. 1087/358
SURVEYED BY: LAUNDON, SIMON, CAHL & ASSOC
C=1:5.53 ac. C=1:726,047
5.52 ac. C=1:724,553
-005
89.20 A.
62
-004
2.79 A.
346.42
766.12
1663
1.27
5.10
SM 4/13/94
20600
APPROVED
LORAIN CO.
MAP DEPT.
DATE 12-2-93
PAGE 19-H
BY CAROLYN FRANCIS
VOID AFTER # 20600
20527
APPROVED
LORAIN CO.
MAP DEPT.
DATE 9-28-93
PAGE 19-H
BY CAROLYN FRANCIS
VOID AFTER # 20527