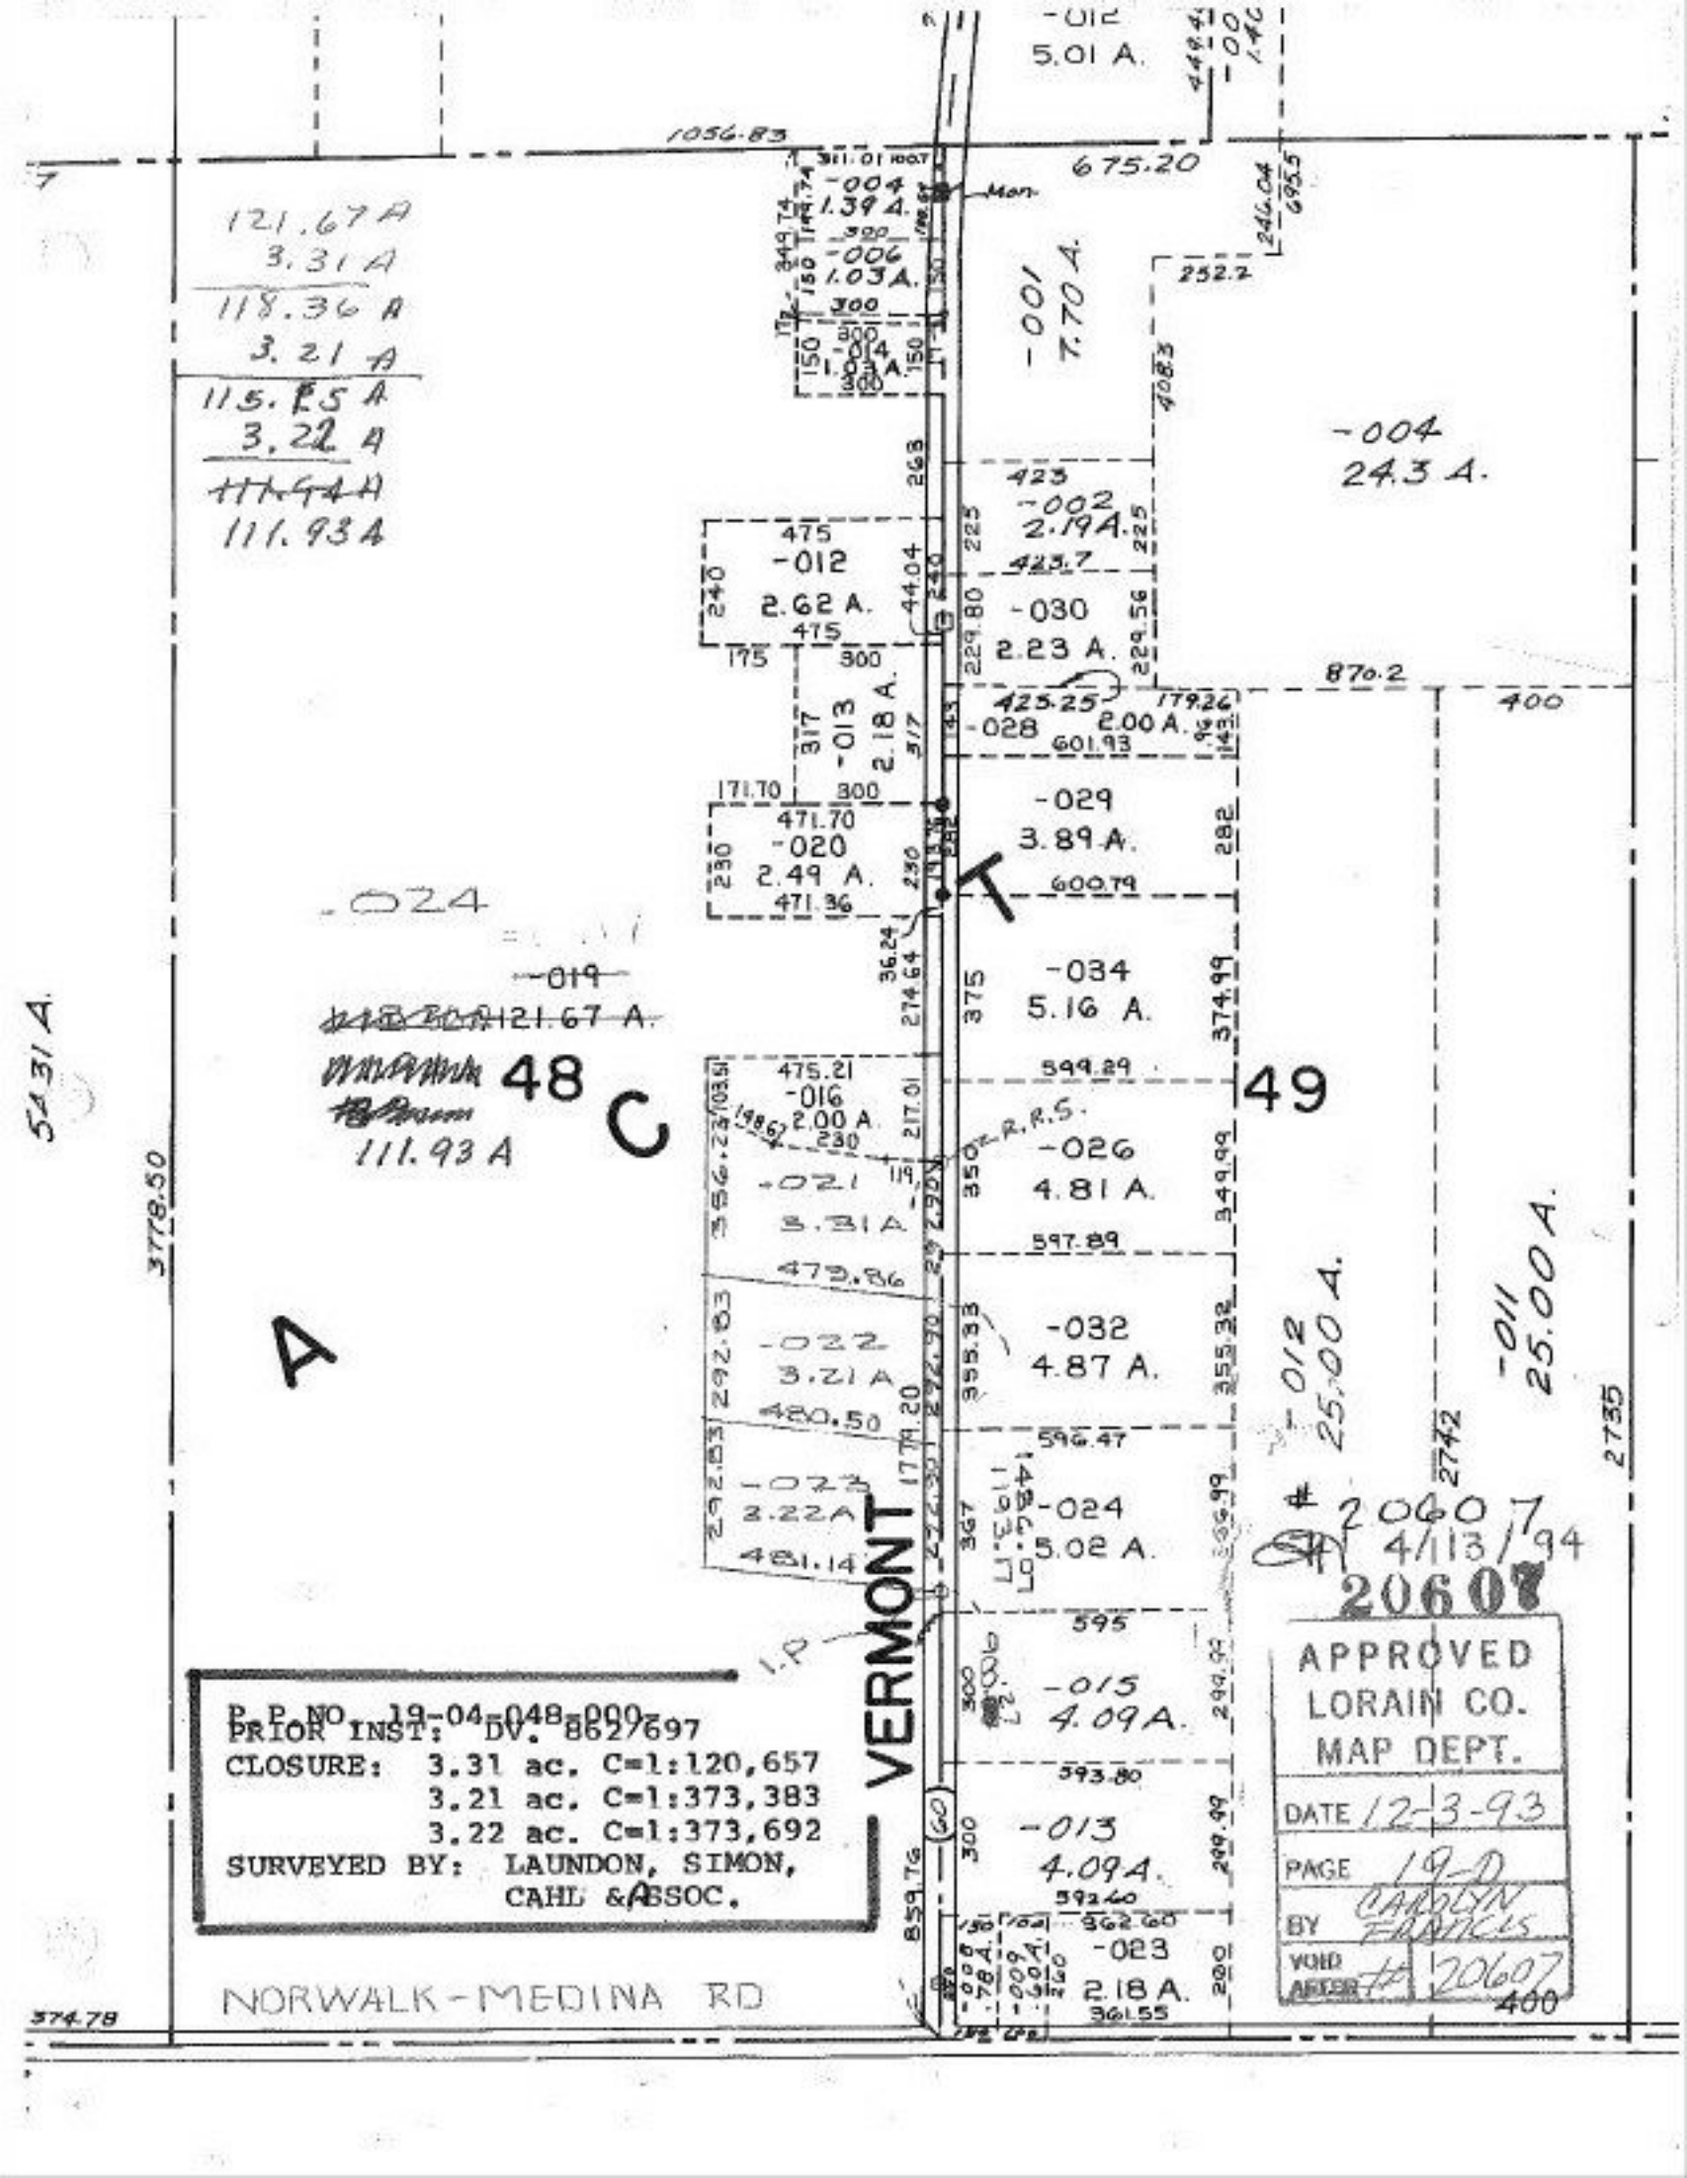
-012
5.01 A.
1056.83
675.20
121.67 A
3.31 A
118.36 A
3.21 A
115.15 A
3.22 A
111.93 A
-004
1.39 A.
-006
1.03 A.
-001
7.70 A.
-004
24.3 A.
-002
2.19 A.
-012
2.62 A.
-030
2.23 A.
-013
2.18 A.
-028
2.00 A.
-029
3.89 A.
-020
2.49 A.
-024
-019
121.67 A.
48
C
111.93 A
-034
5.16 A.
49
-016
2.00 A
-026
4.81 A.
-021
3.31 A
-032
4.87 A.
-022
3.21 A
-023
3.22 A
-024
5.02 A.
-015
4.09 A.
-013
4.09 A.
-023
2.18 A.
A
VERMONT
NORWALK-MEDINA RD
5431 A.
3778.50
2735
-012
25.00 A.
-011
25.00 A.
P.P. NO. 19-04-048-000-
PRIOR INST: DV. 862/697
CLOSURE: 3.31 ac. C=1:120,657
3.21 ac. C=1:373,383
3.22 ac. C=1:373,692
SURVEYED BY: LAUNDON, SIMON, CAHL & ASSOC.
20607
4/13/94
20607
APPROVED
LORAIN CO.
MAP DEPT.
DATE 12-3-93
PAGE 19-D
BY CARLON FRANCIS
VOID AFTER # 20607