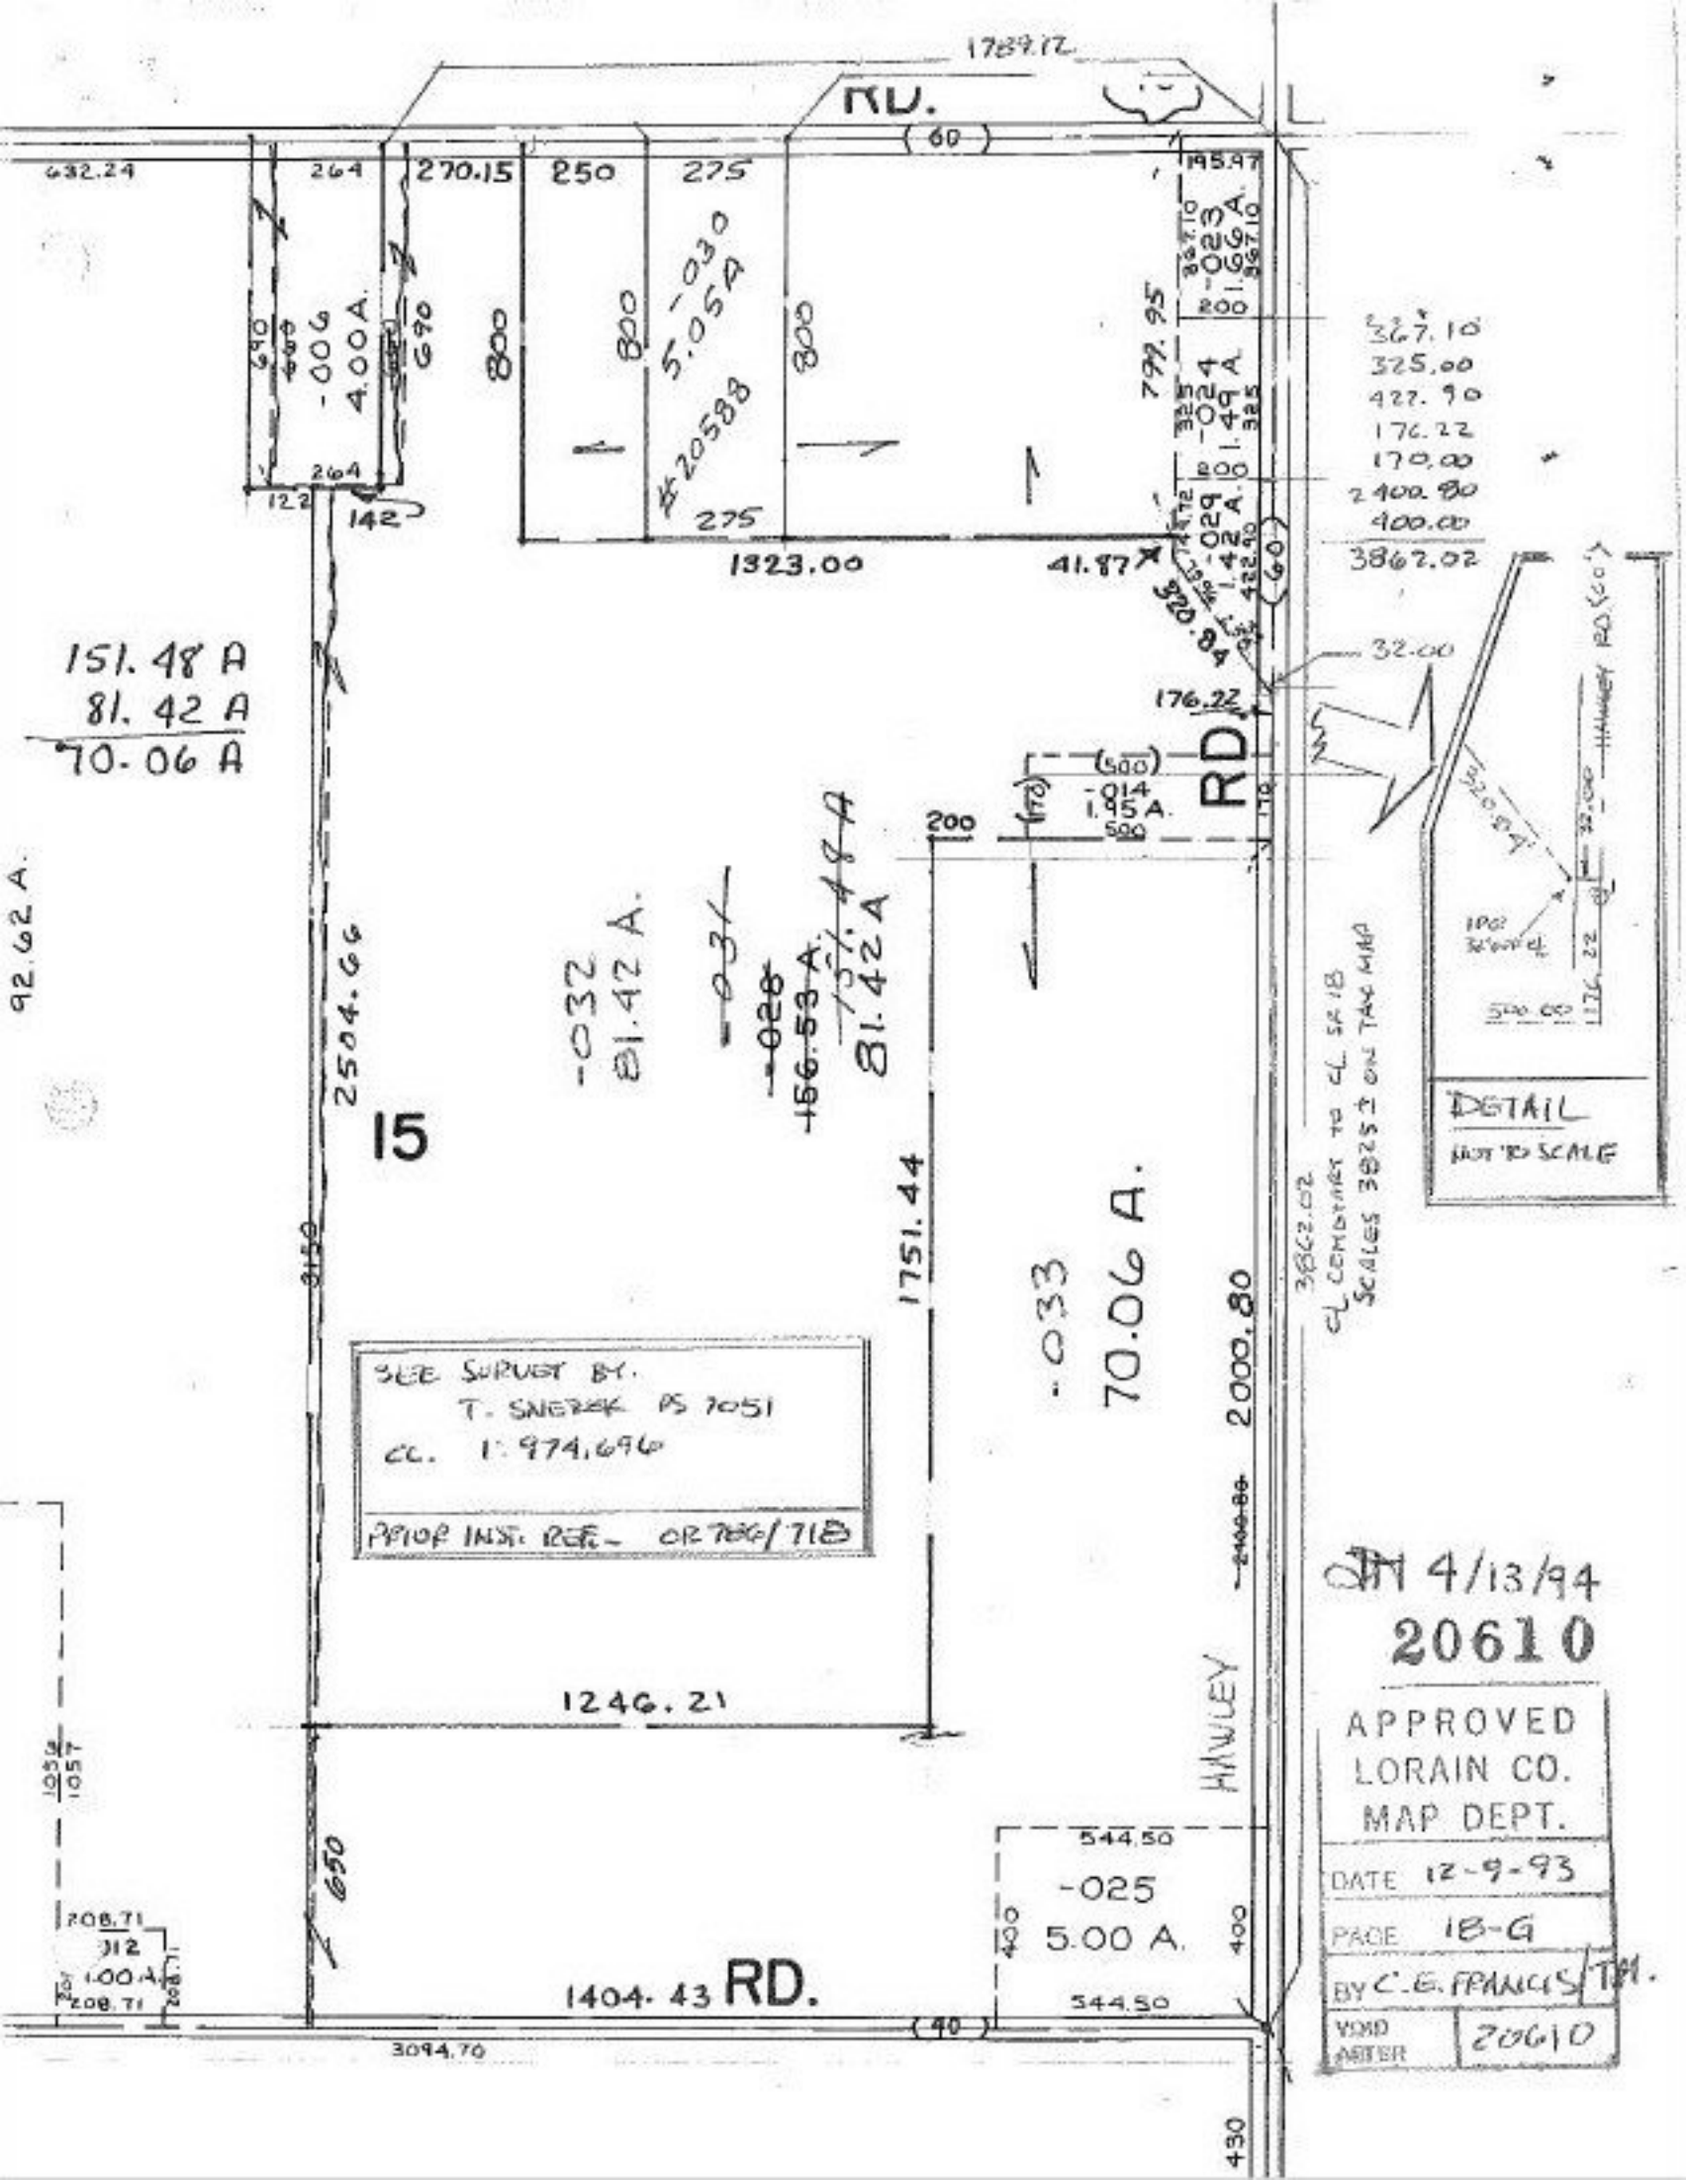

1789.12
RD.
(60)
632.24
264
270.15
250
275
195.97
-006
4.00 A.
690
800
-030
5.05 A
#20588
799.95
-023
1.66 A.
-024
1.49 A.
-029
1.42 A.
200
367.10
325.00
427.90
176.22
170.00
2400.80
400.00
3862.02
122
142
1323.00
41.87
320.84
32.00
176.22
151.48 A
81.42 A
70.06 A
(500)
-014
1.95 A.
500
RD
200
92.62 A.
2504.66
-032
81.42 A.
-031
-028
156.53 A.
151.48 A
81.42 A
15
1751.44
-033
70.06 A.
2000.80
3862.02
CL CEMETARY TO CL SR 18
SCALES 3825± ON TAX MAP
DETAIL
NOT TO SCALE
SEE SURVEY BY.
T. SNEZEK PS 7051
CL. 1:974,696
PRIOR INST. REF. - OR 786/718
1246.21
HAWLEY
650
544.50
-025
5.00 A.
400
208.71
312
1.00 A.
1404.43 RD.
(40)
3094.70
430
4/13/94
20610
APPROVED
LORAIN CO.
MAP DEPT.
DATE 12-9-93
PAGE 18-G
BY C.E. FRANCIS TM.
VOID AFTER 20610