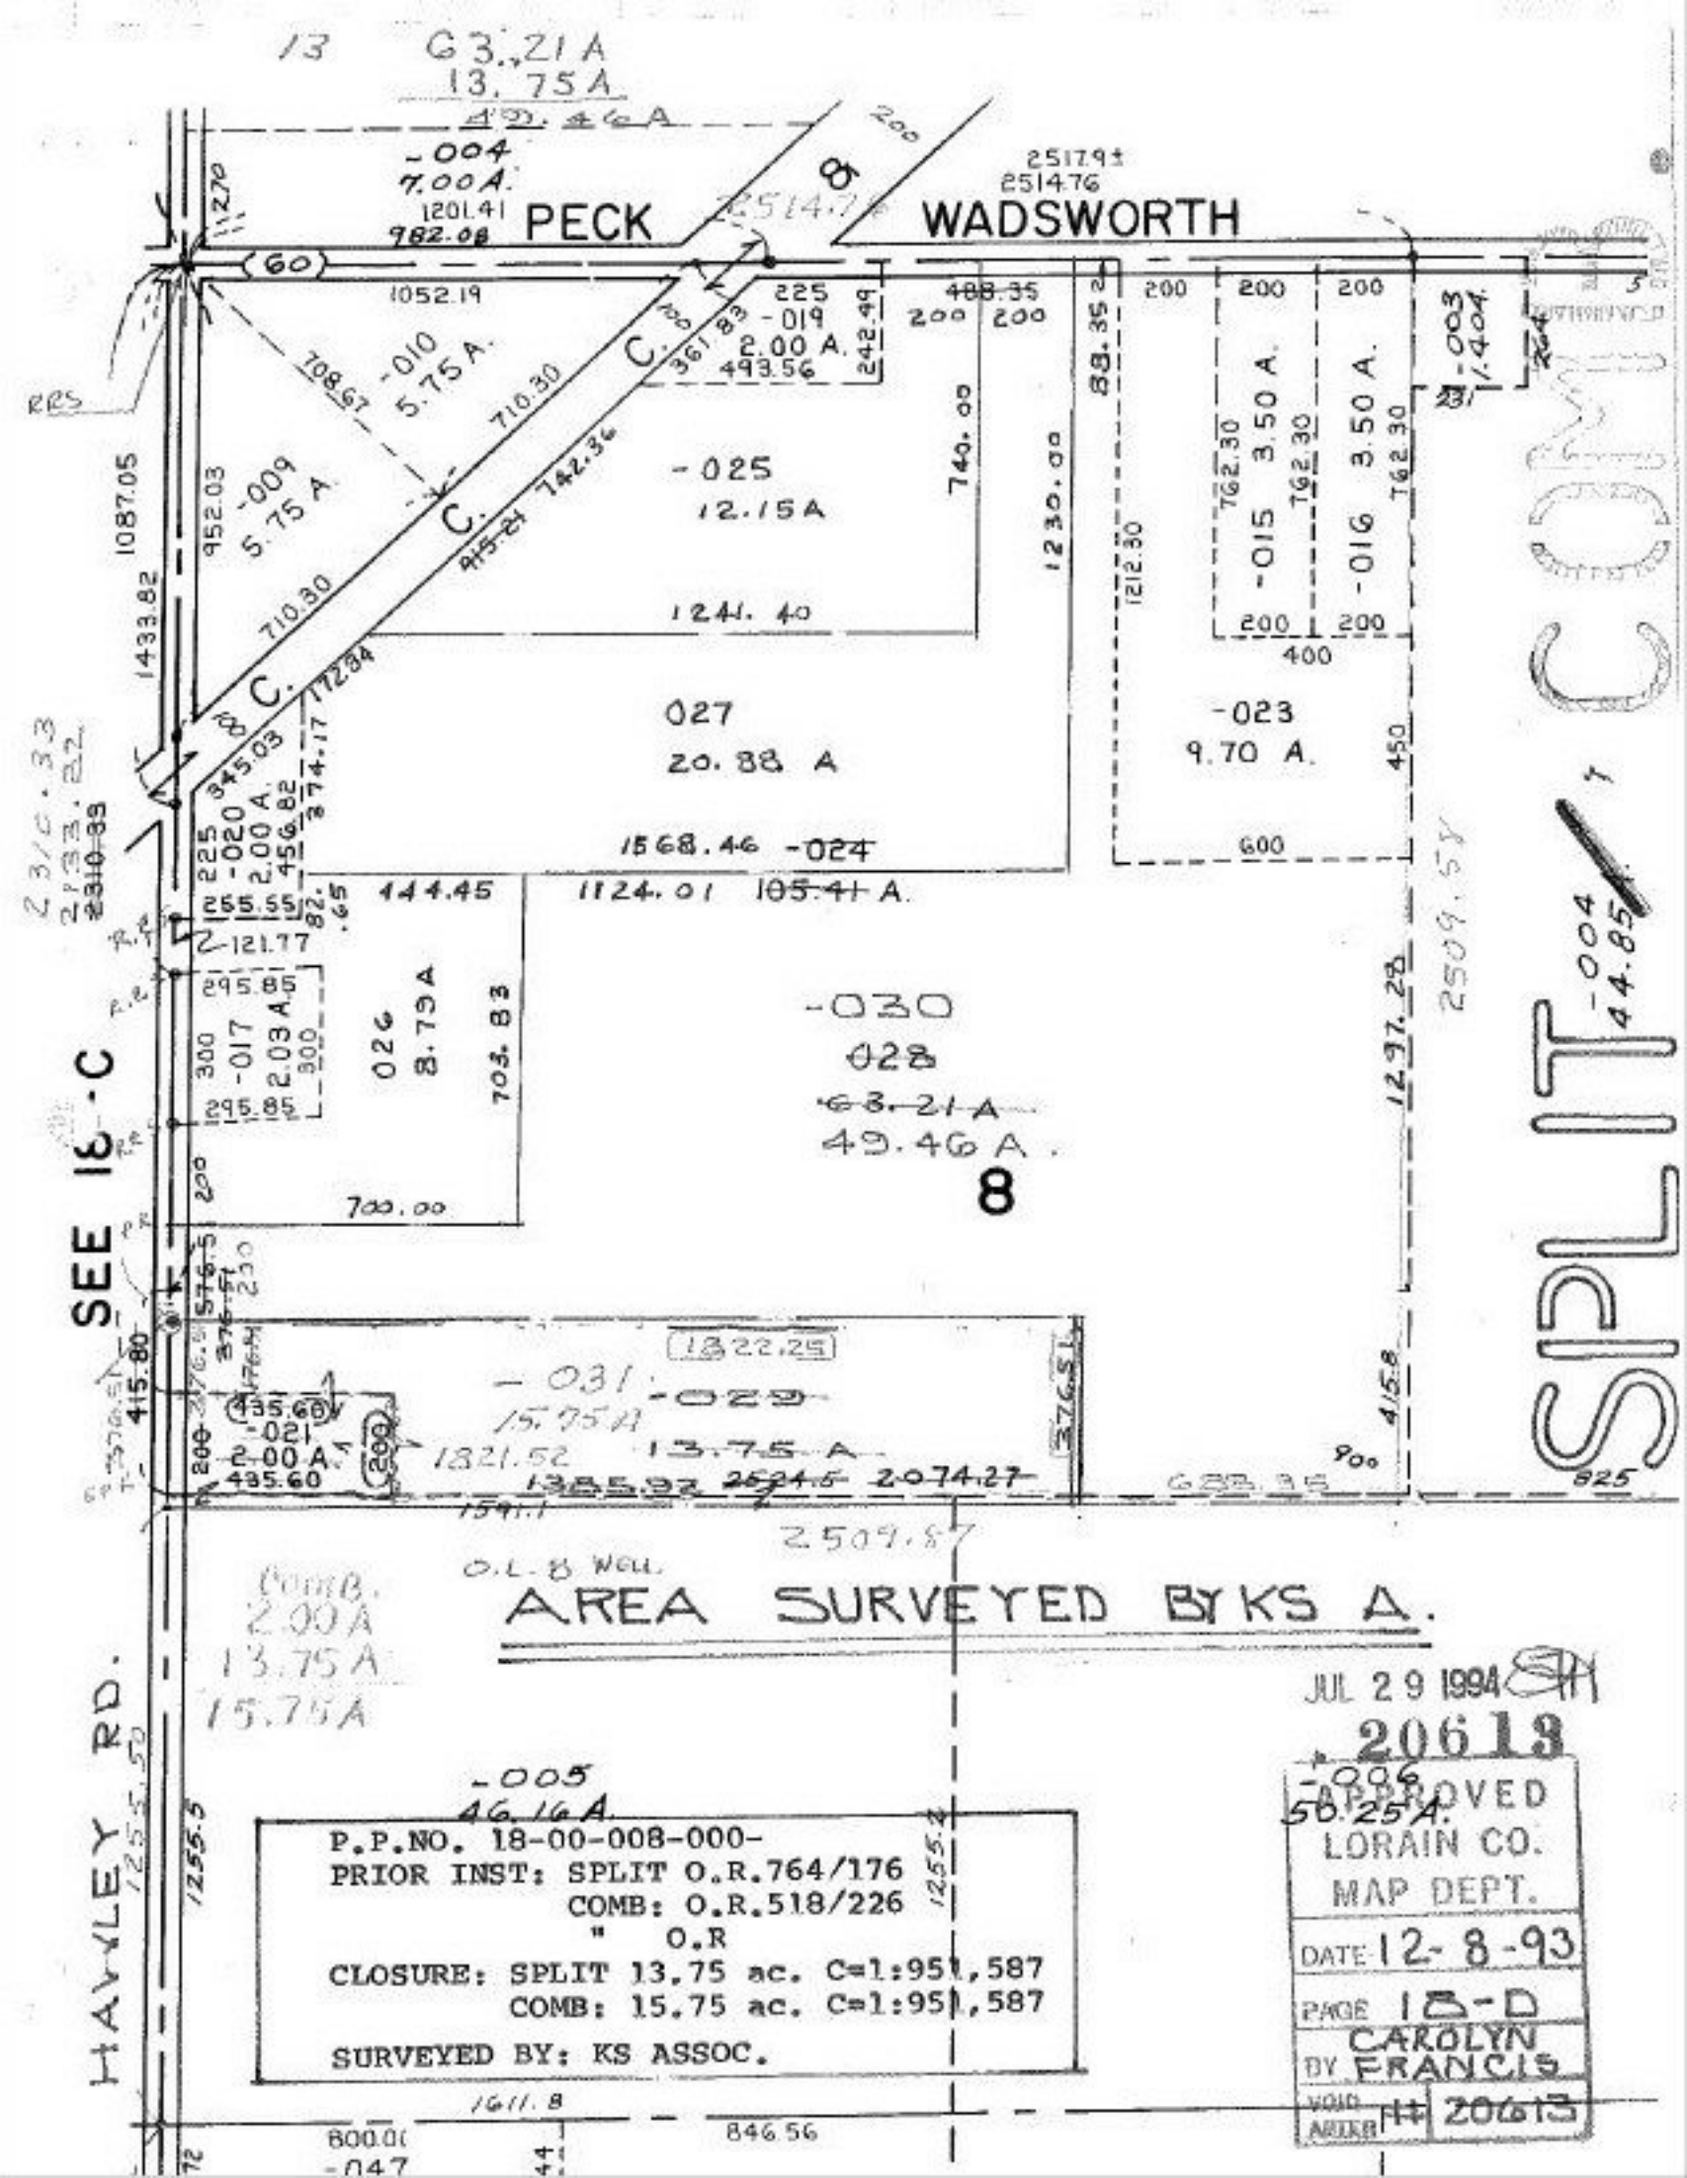
PECK
WADSWORTH
SPLIT
SEE 18-C
HAVILEY RD.
AREA SURVEYED BY KS A.
P.P.NO. 18-00-008-000-
PRIOR INST: SPLIT O.R.764/176
COMB: O.R.518/226
" O.R
CLOSURE: SPLIT 13.75 ac. C=1:951,587
COMB: 15.75 ac. C=1:951,587
SURVEYED BY: KS ASSOC.
JUL 29 1994
20613
APPROVED
LORAIN CO.
MAP DEPT.
DATE 12-8-93
PAGE 18-D
BY CAROLYN FRANCIS
VOID AFTER 20613