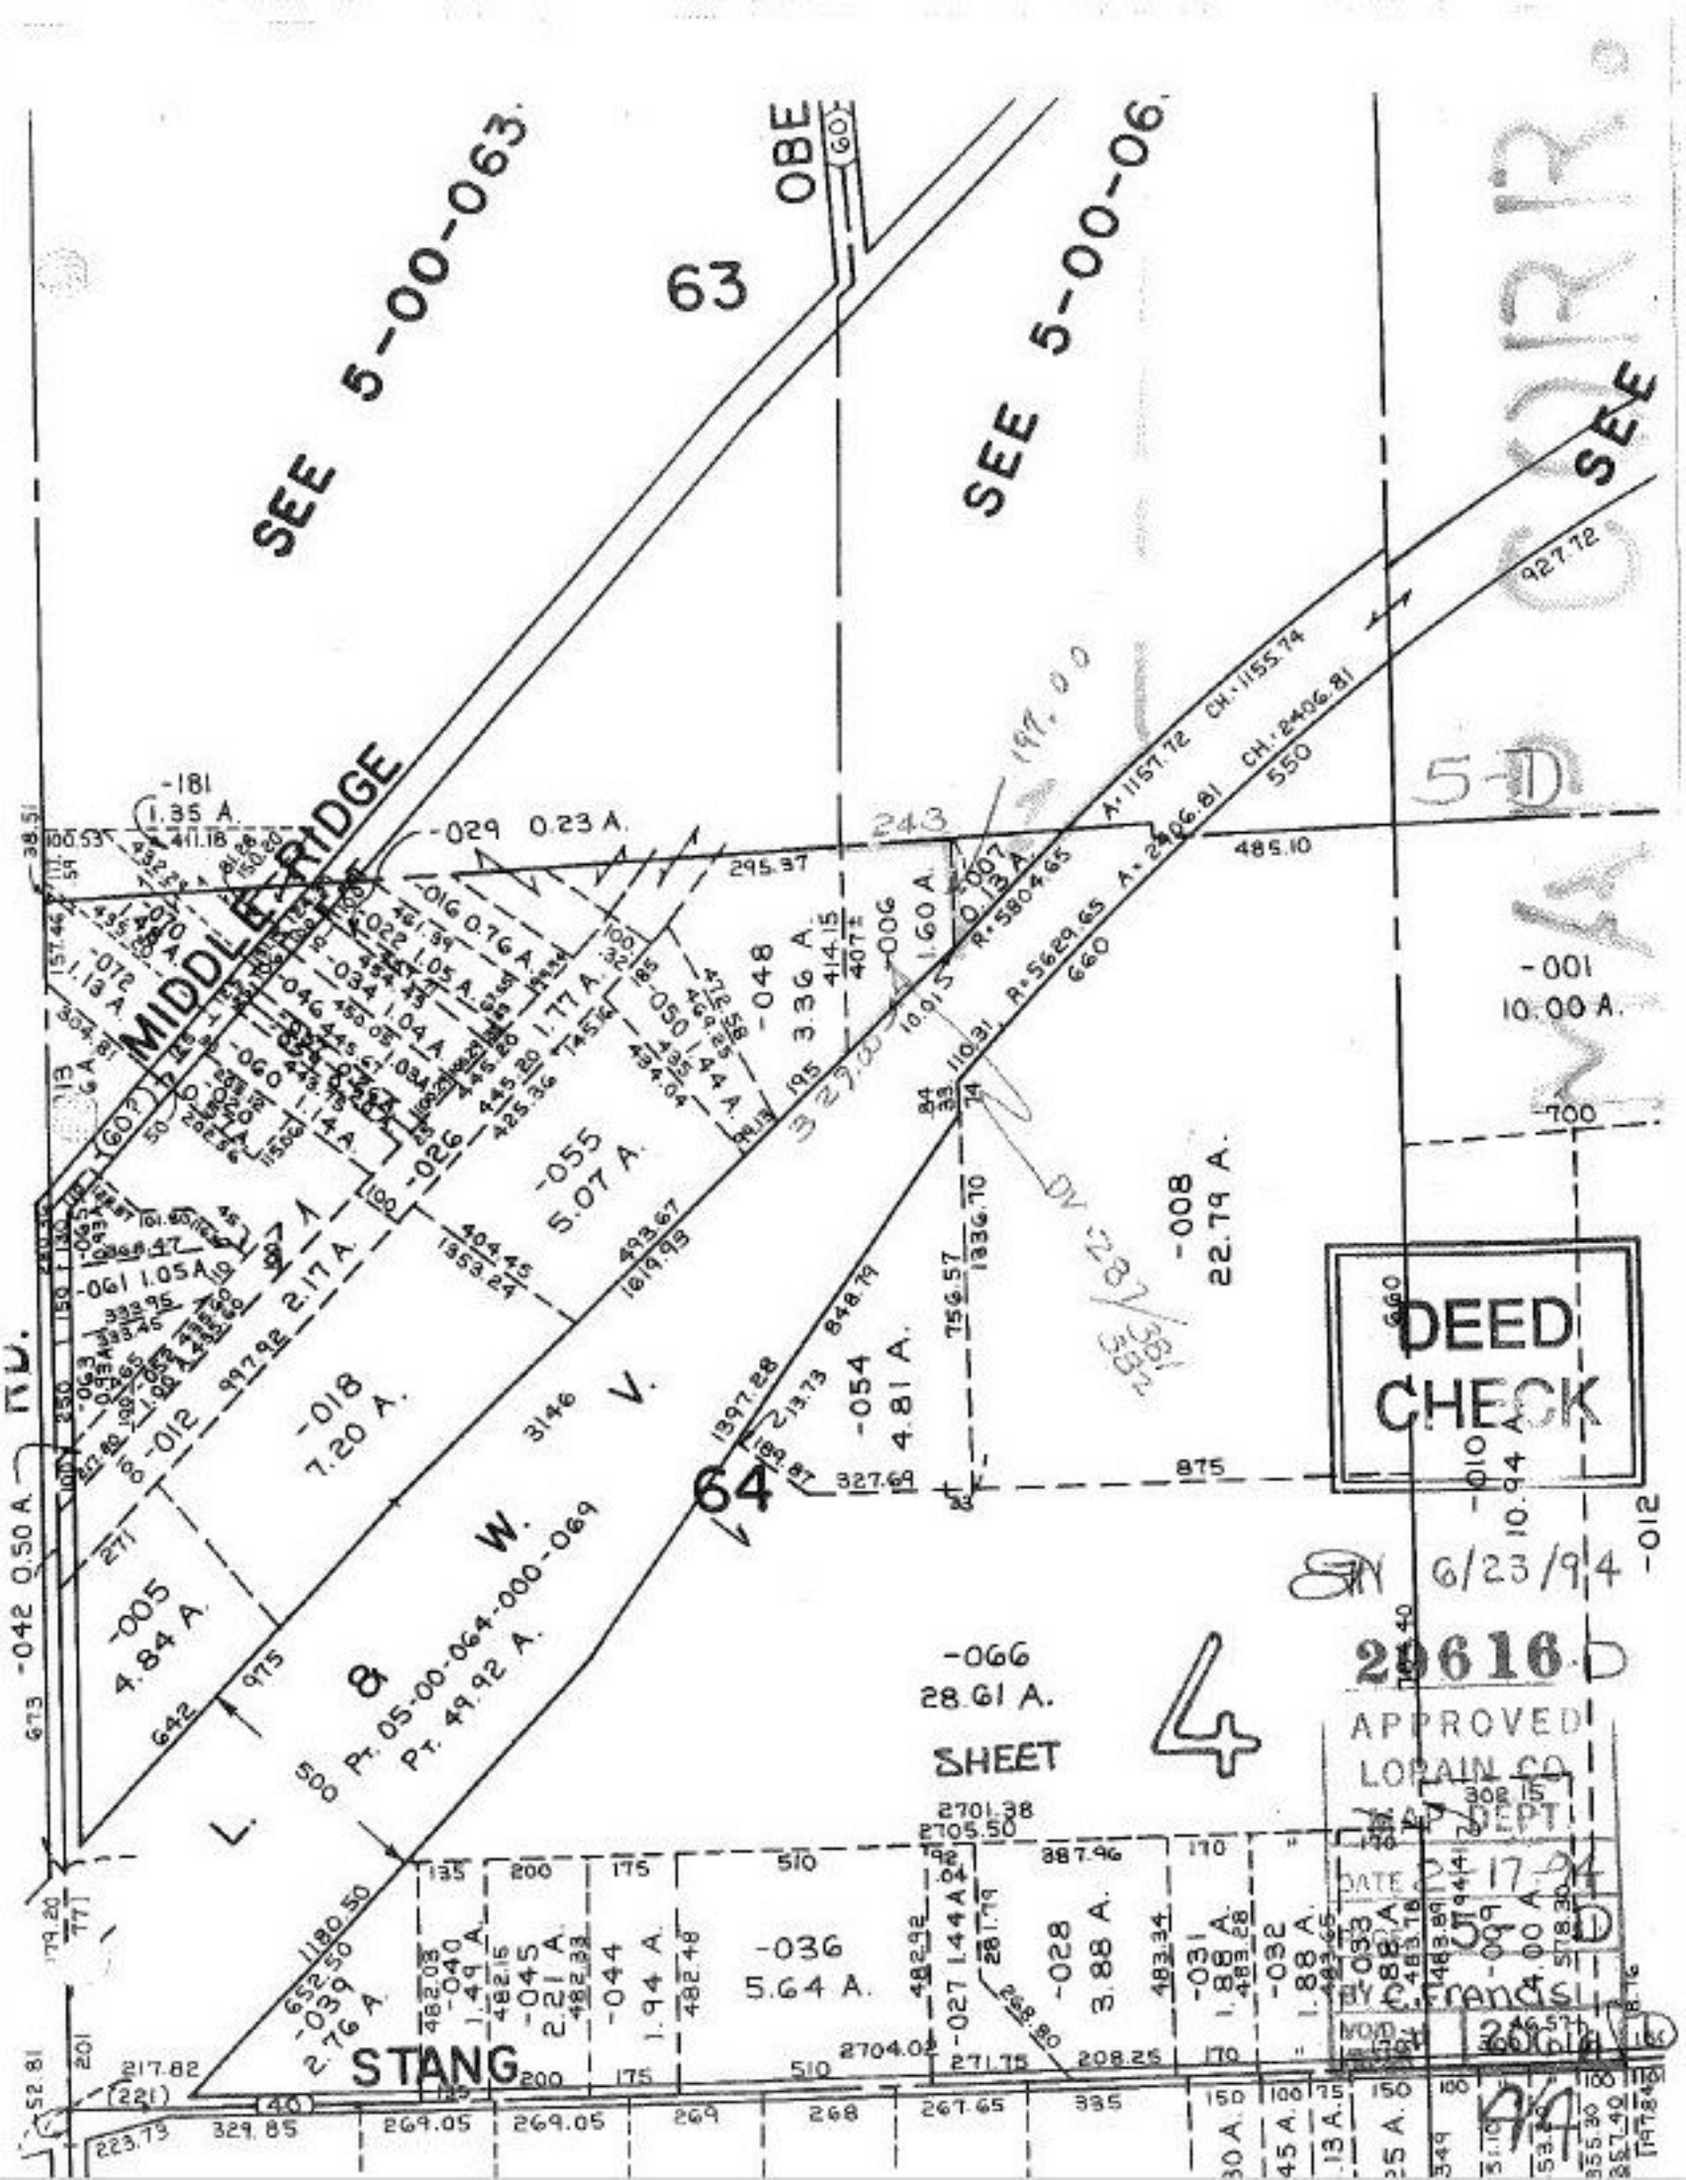

SEE 5-00-063
63
OBE
SEE 5-00-06
SEE
MIDDLE RIDGE
-181
1.35 A.
-029 0.23 A.
-016 0.76 A.
-022 1.05 A.
-034 1.04 A.
-046
-060
-026
-055
5.07 A.
-048
3.36 A.
-006
1.60 A.
-007
0.13 A.
-001
10.00 A.
-008
22.79 A.
-054
4.81 A.
-018
7.20 A.
-012
-005
4.84 A.
-042 0.50 A.
64
L. & W. V.
Pt. 05-00-064-000-069
Pt. 49.92 A.
-066
28.61 A.
SHEET
4
-036
5.64 A.
-028
3.88 A.
-031
1.88 A.
-032
1.88 A.
-039
2.76 A.
STANG
DEED CHECK
6/23/94
29616
APPROVED
LORAIN CO.
MAP DEPT.
DATE 2-17-94
BY C. Francis
5-D