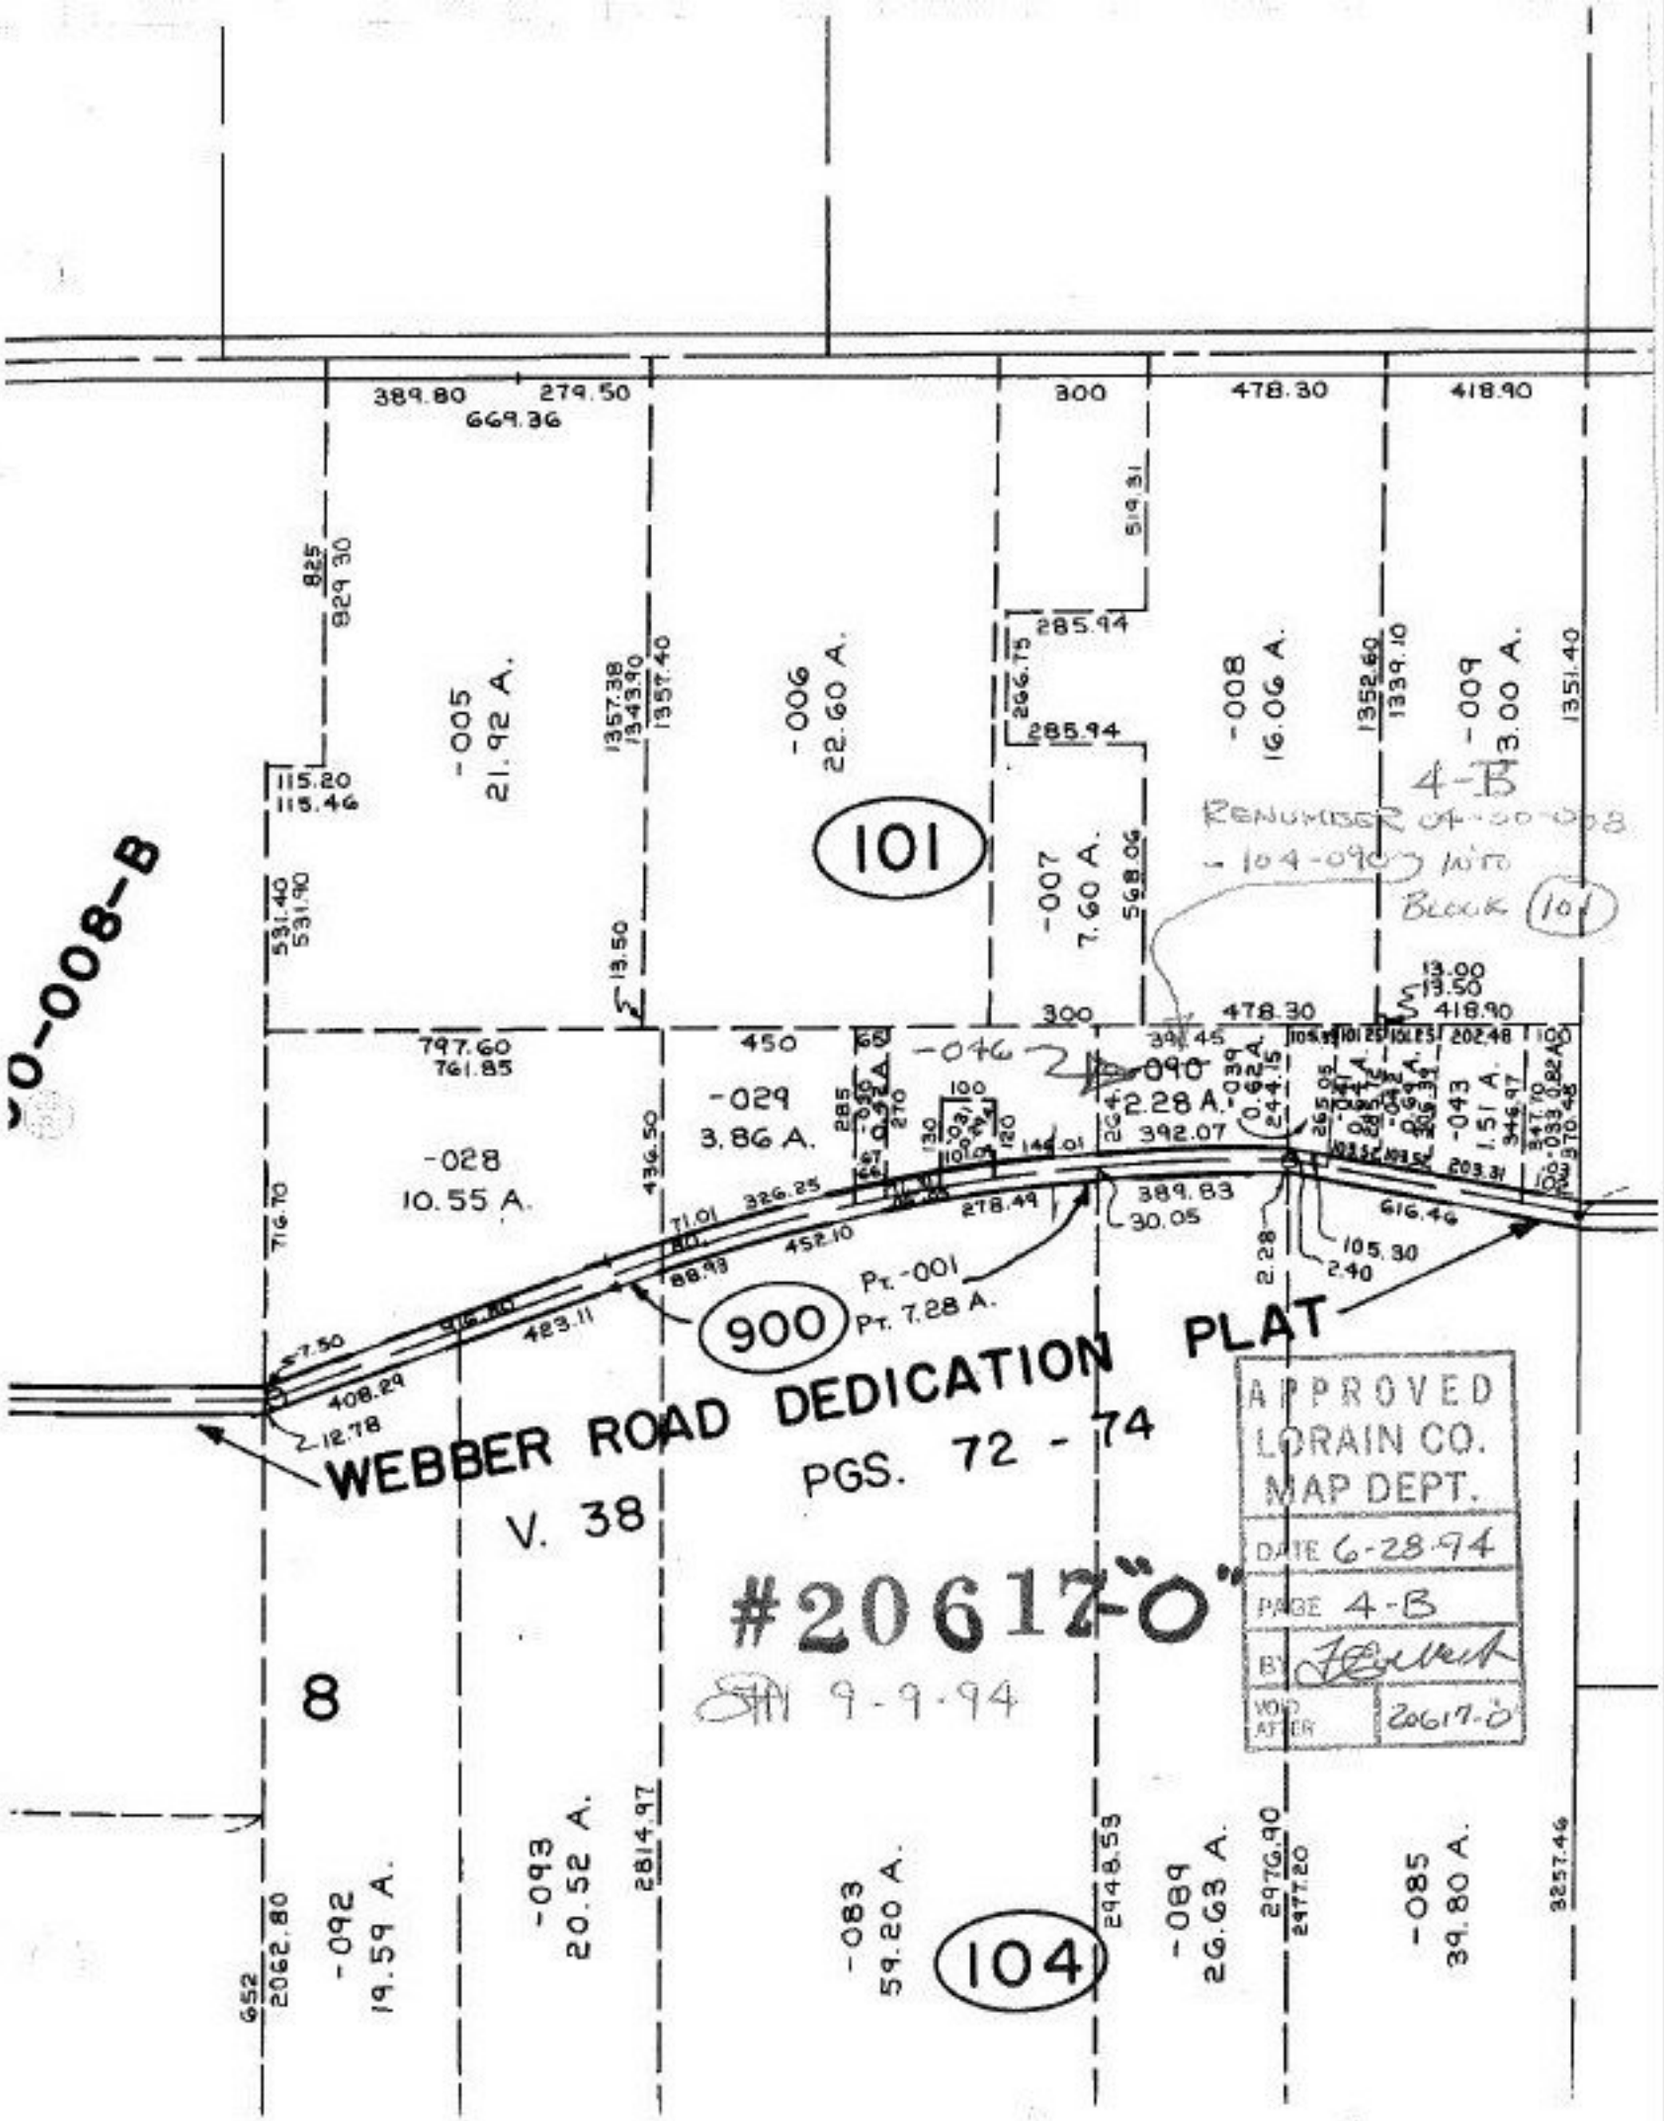
389.80
279.50
669.36
300
478.30
418.90
825
829.30
519.31
285.94
266.75
285.94
-005
21.92 A.
1357.38
1343.90
1357.40
-006
22.60 A.
-008
16.06 A.
1352.60
1339.10
-009
3.00 A.
1351.40
115.20
115.46
531.40
531.90
13.50
101
-007
7.60 A.
568.06
4-B
RENUMBER 04-00-008
- 104-090 INTO
BLOCK (101)
13.00
13.50
418.90
300
478.30
797.60
761.85
450
-046
-090
2.28 A.
392.07
-039
0.62 A.
244.15
-043
1.51 A.
346.97
-029
3.86 A.
-028
10.55 A.
436.50
716.70
326.25
71.01
452.10
278.49
389.83
30.05
616.46
105.30
2.40
2.28
Pt. -001
Pt. 7.28 A.
900
423.11
408.29
2-12.78
WEBBER ROAD DEDICATION PLAT
PGS. 72 - 74
V. 38
APPROVED
LORAIN CO.
MAP DEPT.
DATE 6-28-94
PAGE 4-B
BY
VOID AFTER 20617-0
#20617-0"
9-9-94
8
-092
19.59 A.
2062.80
-093
20.52 A.
2814.97
-083
59.20 A.
2948.59
104
-089
26.63 A.
2976.90
2977.20
-085
39.80 A.
3257.46