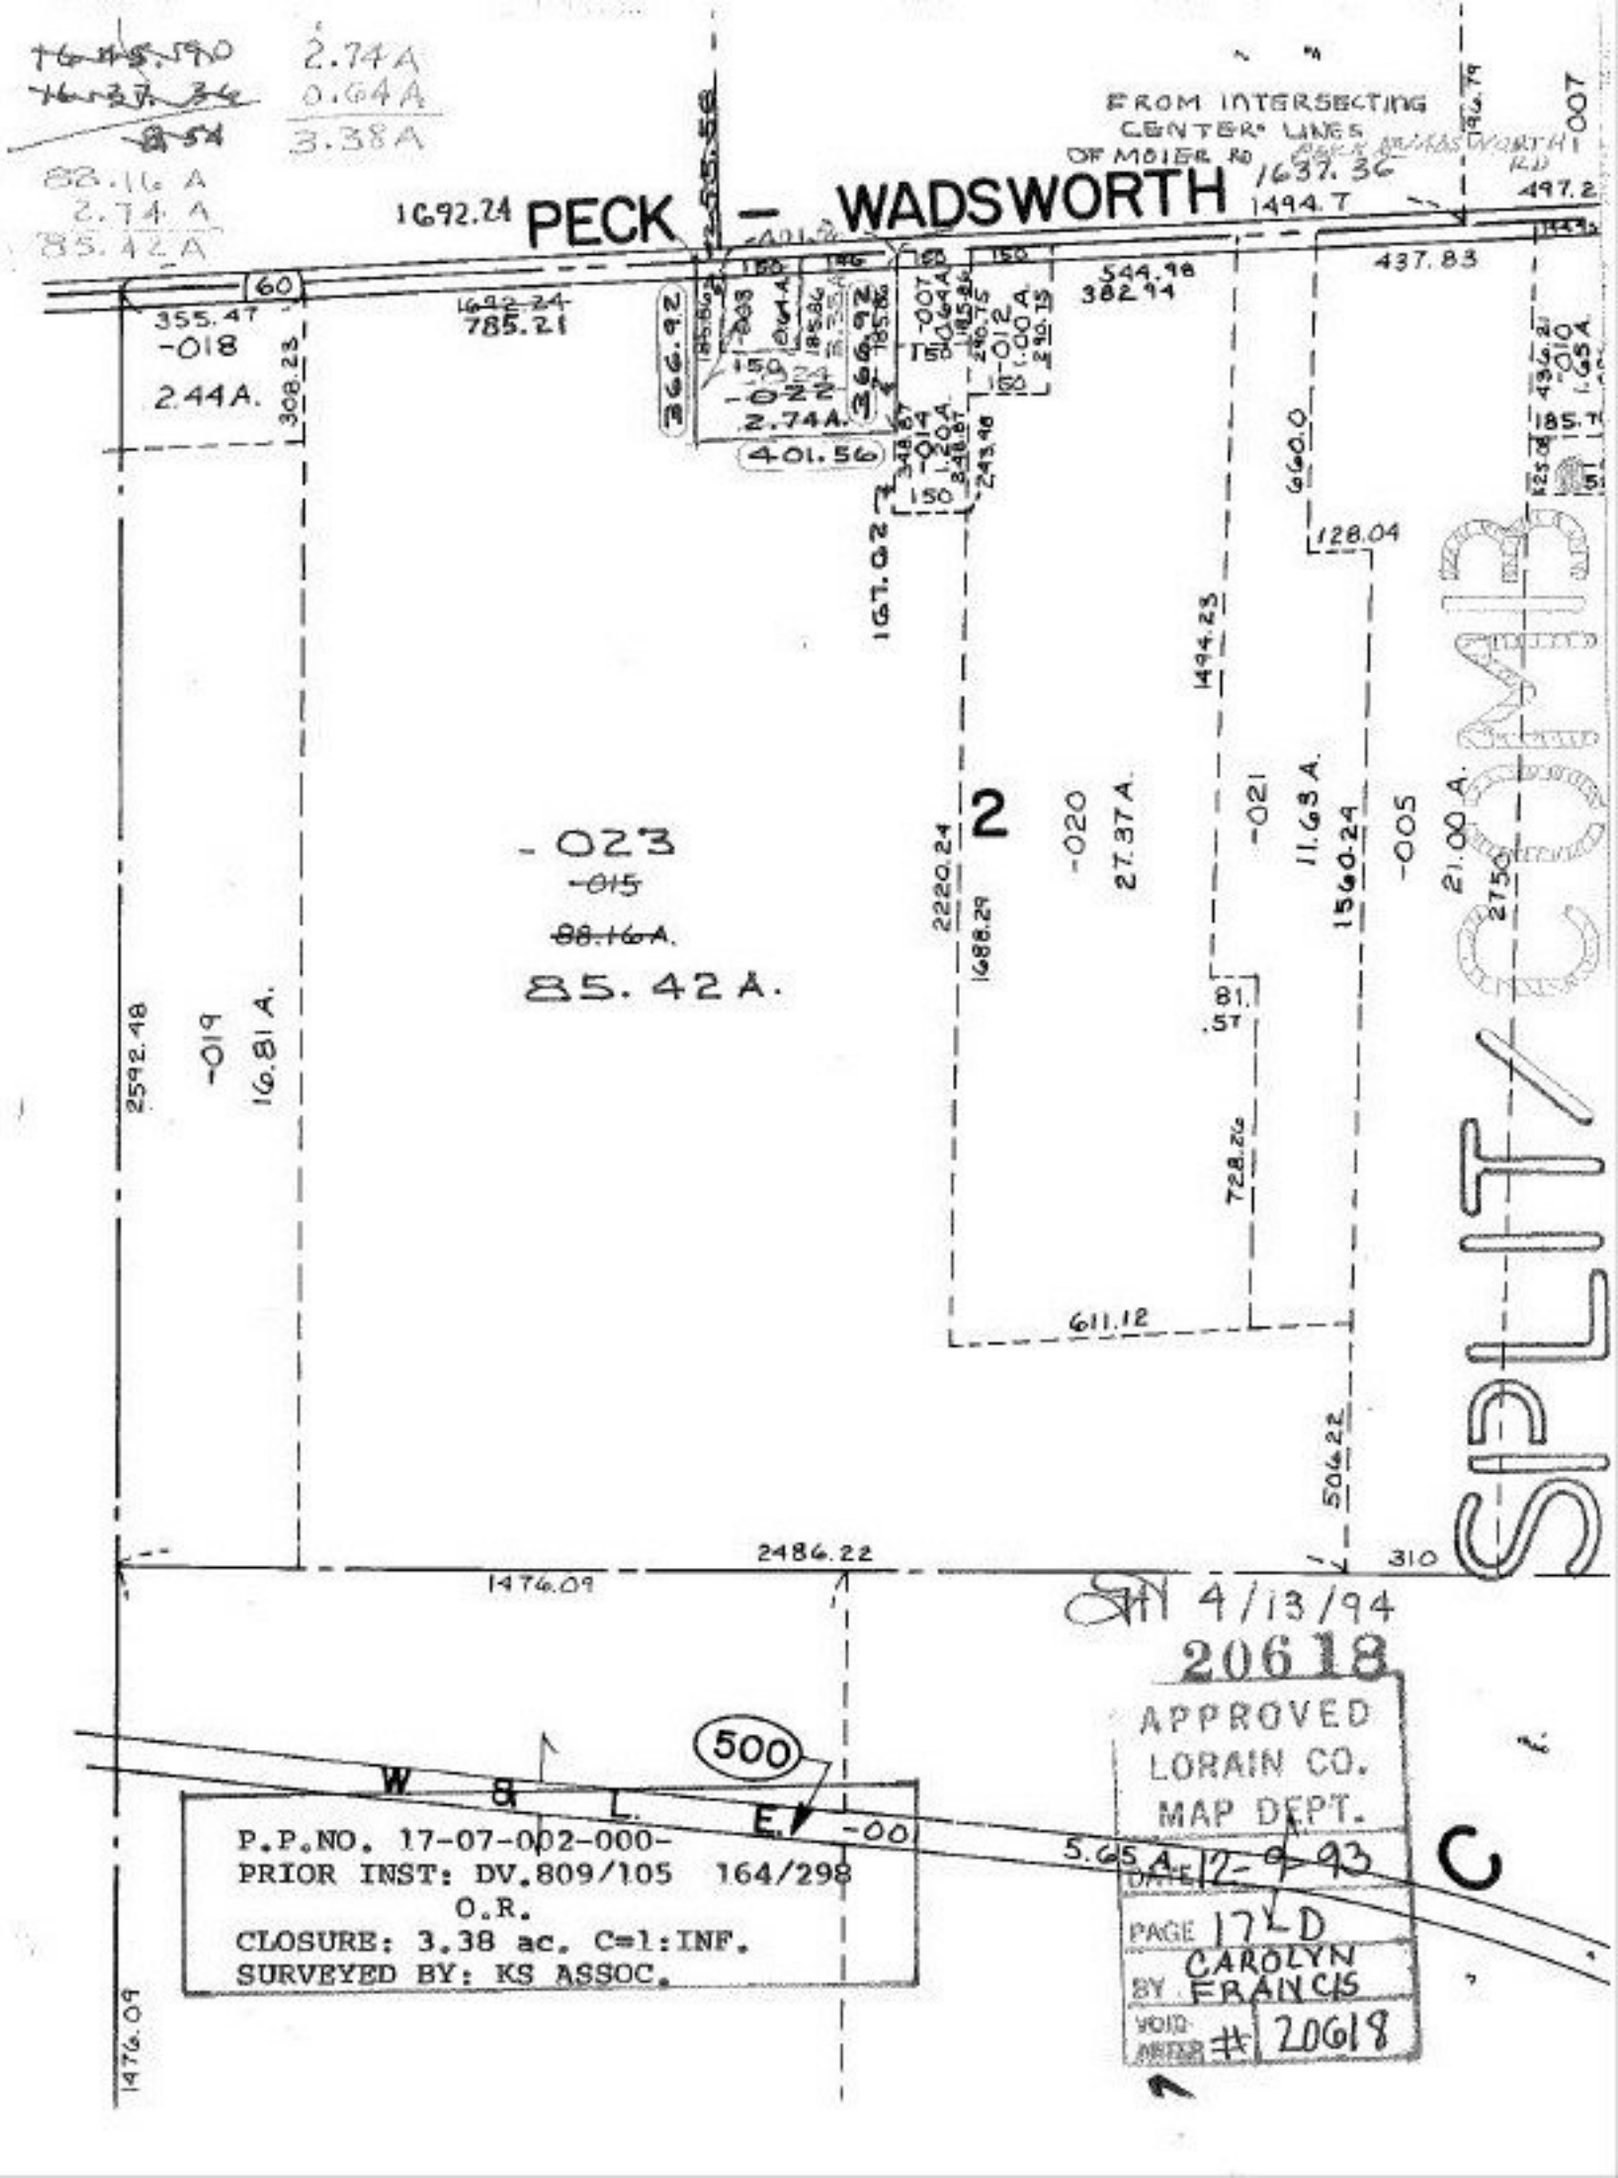

2.74A
0.64A
3.38A
88.16 A
2.74 A
85.42 A
FROM INTERSECTING CENTER LINES OF MOIER RD
PECK - WADSWORTH
1692.24
1637.36
1494.7
497.2
437.83
544.98
382.94
60
355.47
-018
2.44A.
308.23
785.21
366.92
-022
2.74A.
401.56
167.02
660.0
128.04
1494.23
-023
-015
88.16A.
85.42A.
2
-020
27.37A.
-021
11.63A.
1560.24
-005
21.00A.
2220.24
1688.29
2592.48
-019
16.81A.
81.57
728.26
611.12
506.22
2486.22
1476.09
310
SPLIT/COMB
4/13/94
20618
APPROVED
LORAIN CO.
MAP DEPT.
DATE 12-9-93
PAGE 17-D
BY CAROLYN FRANCIS
VOID AFTER # 20618
500
W & L E
-001
5.65A.
C
P.P.NO. 17-07-002-000-
PRIOR INST: DV.809/105 164/298
O.R.
CLOSURE: 3.38 ac. C=1:INF.
SURVEYED BY: KS ASSOC.