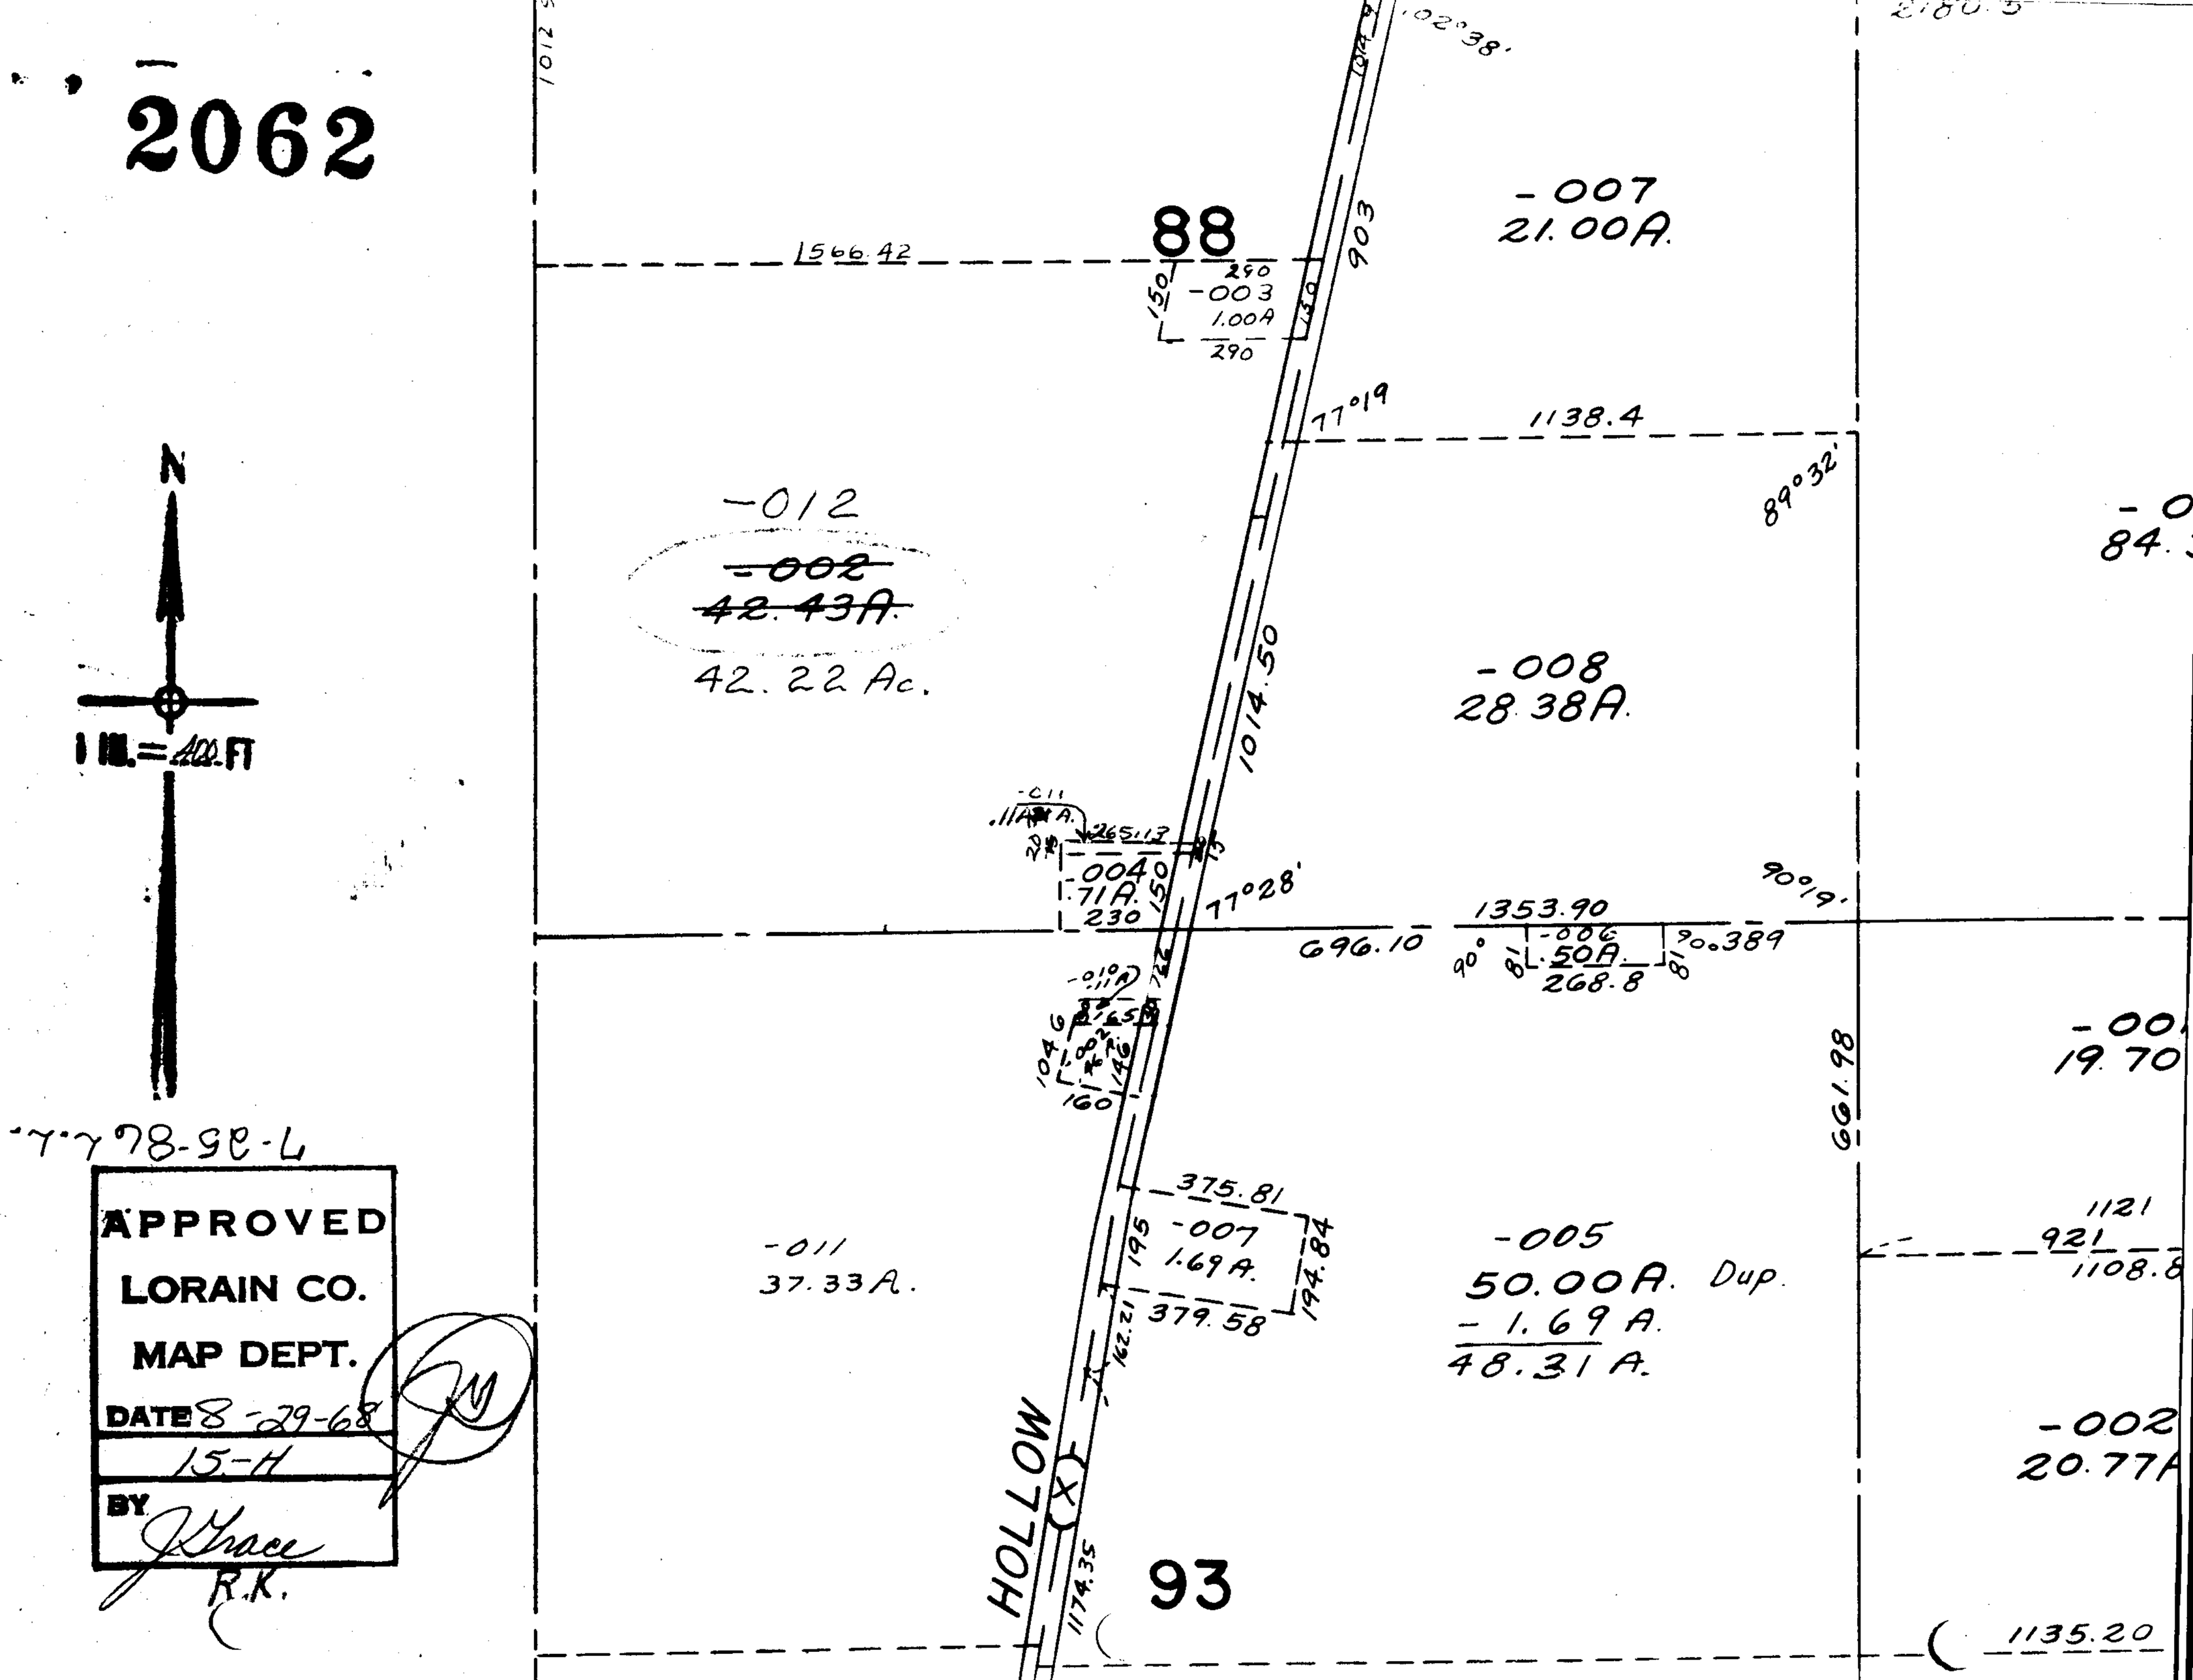
2062
N
1 IN.=400 FT
7-25-86 L.L.
APPROVED
LORAIN CO.
MAP DEPT.
DATE 8-29-68
15-H
BY J Grace
R.K.
88
93
-007
21.00A.
-012
~~-002~~
~~42.43A.~~
42.22 Ac.
-008
28.38A.
-011
37.33A.
-005
50.00A. Dup.
- 1.69 A.
48.31 A.
-004
.71A.
-006
.50A.
-007
1.69A.
-003
1.00A
-011
.11A
-002
20.77A
HOLLOW
1566.42
1138.4
1353.90
696.10
1014.50
1174.35
1135.20
77°19
77°28'
89°32'
90°19'
90°389
661.98
375.81
379.58
194.84
162.21
1121
921
1108.8
102°38'
903
1012.9