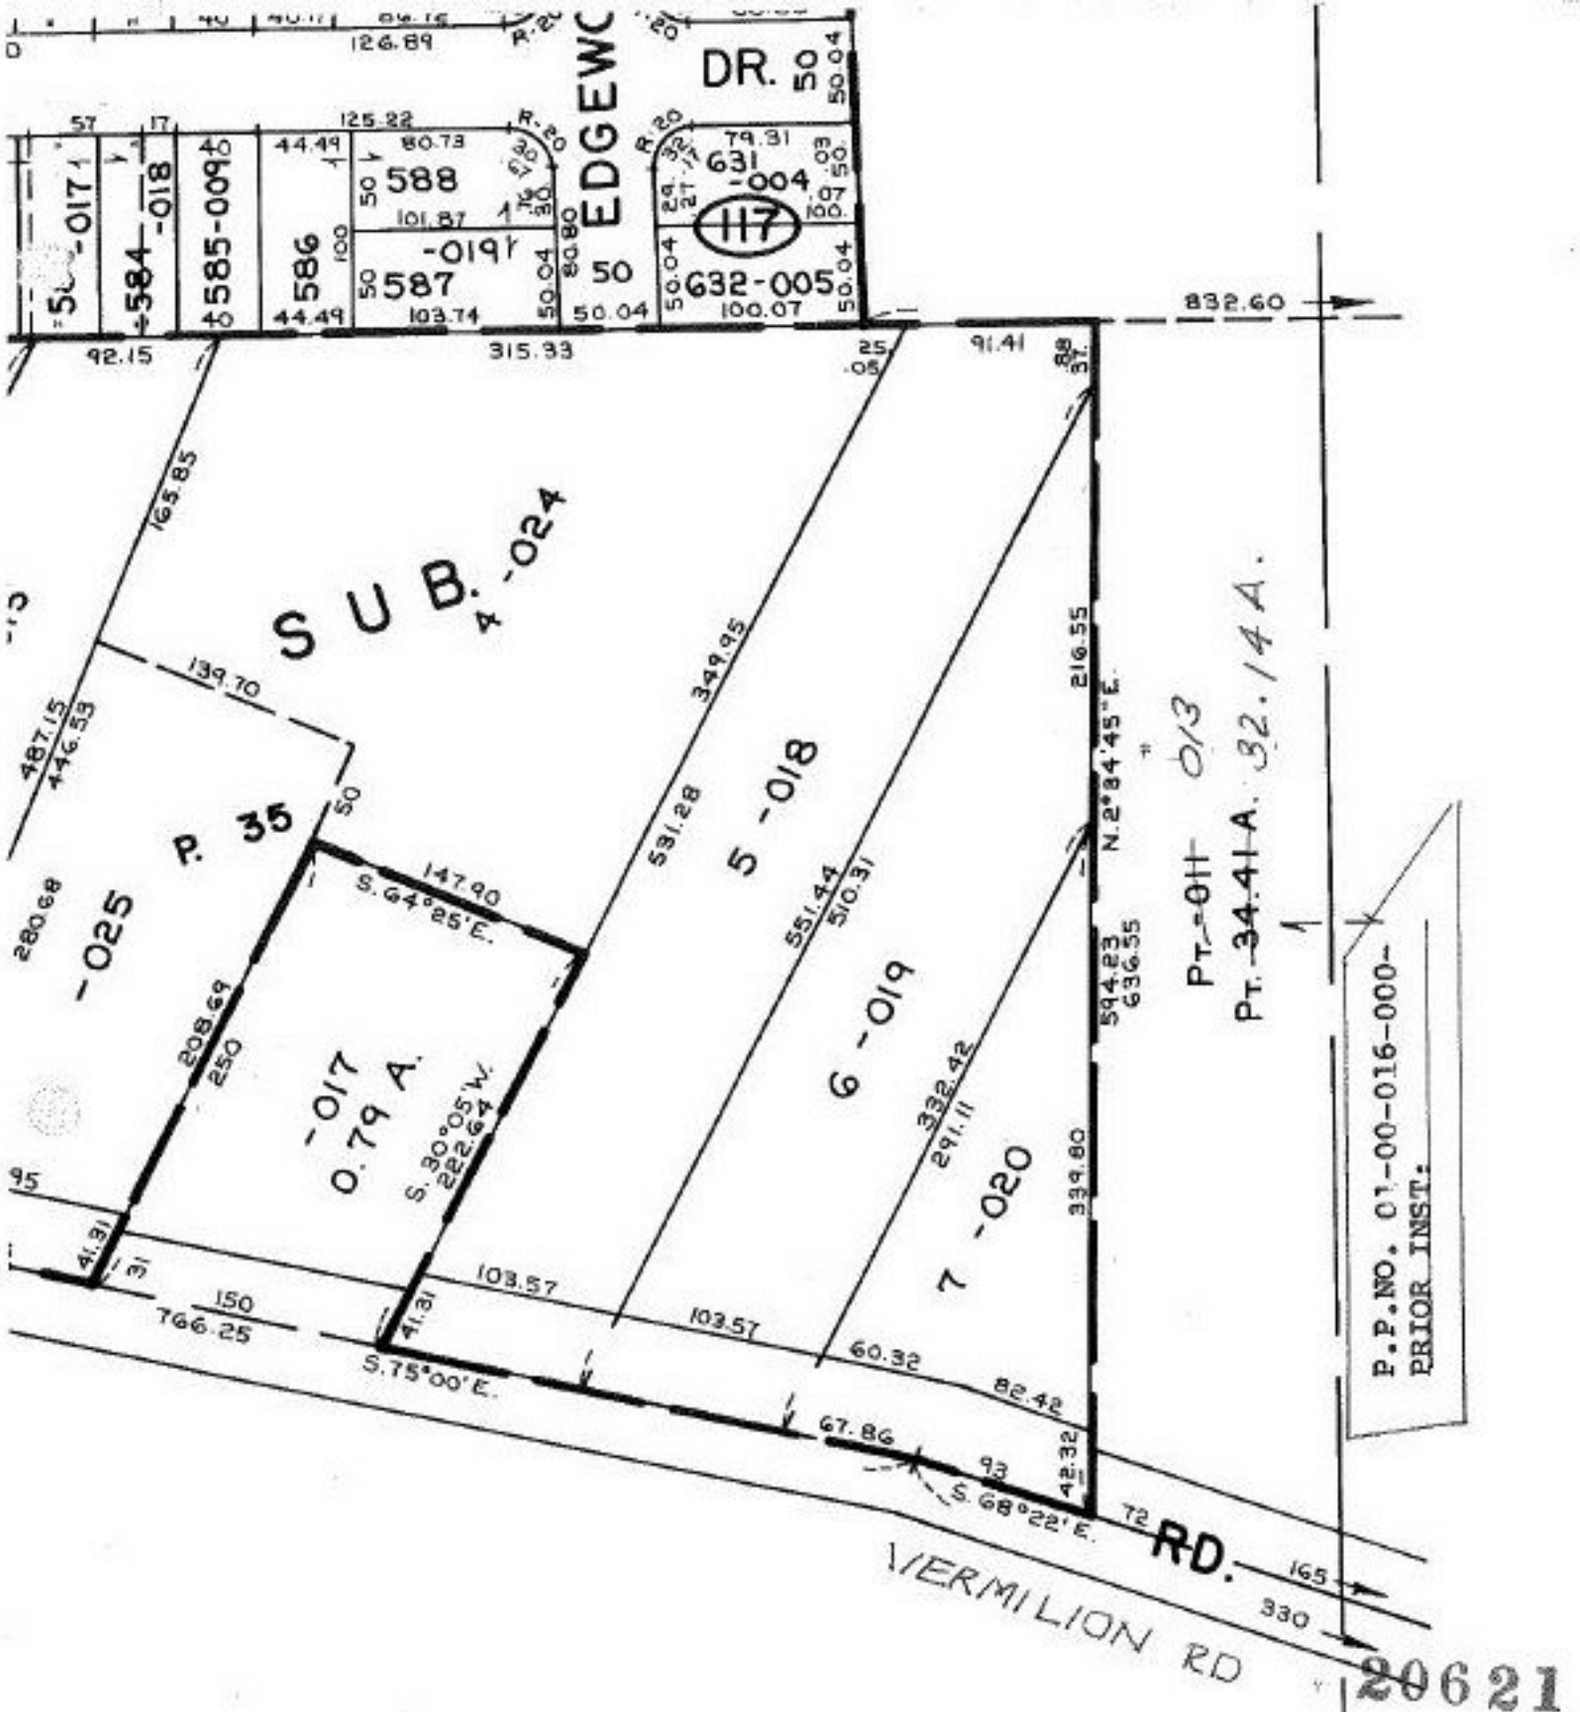
DR.
EDGEWC
-017
-018
585-009
586
588
-019
587
631
-004
117
632-005
SUB.
4 -024
5 -018
6 -019
7 -020
-025
P. 35
-017
0.79 A.
Pt.-011
Pt. 34.41 A.
32.14 A.
013
P.P.NO. 01-00-016-000-
PRIOR INST:
VERMILION RD
RD.
Pt. - 001
Pt. 21.00 A.
20621
APPROVED
LORAIN CO.
MAP DEPT.
DATE 12-16-93
PAGE 1-00-016 A
BY CAROLYN FRANCIS
VOID METER # 20621