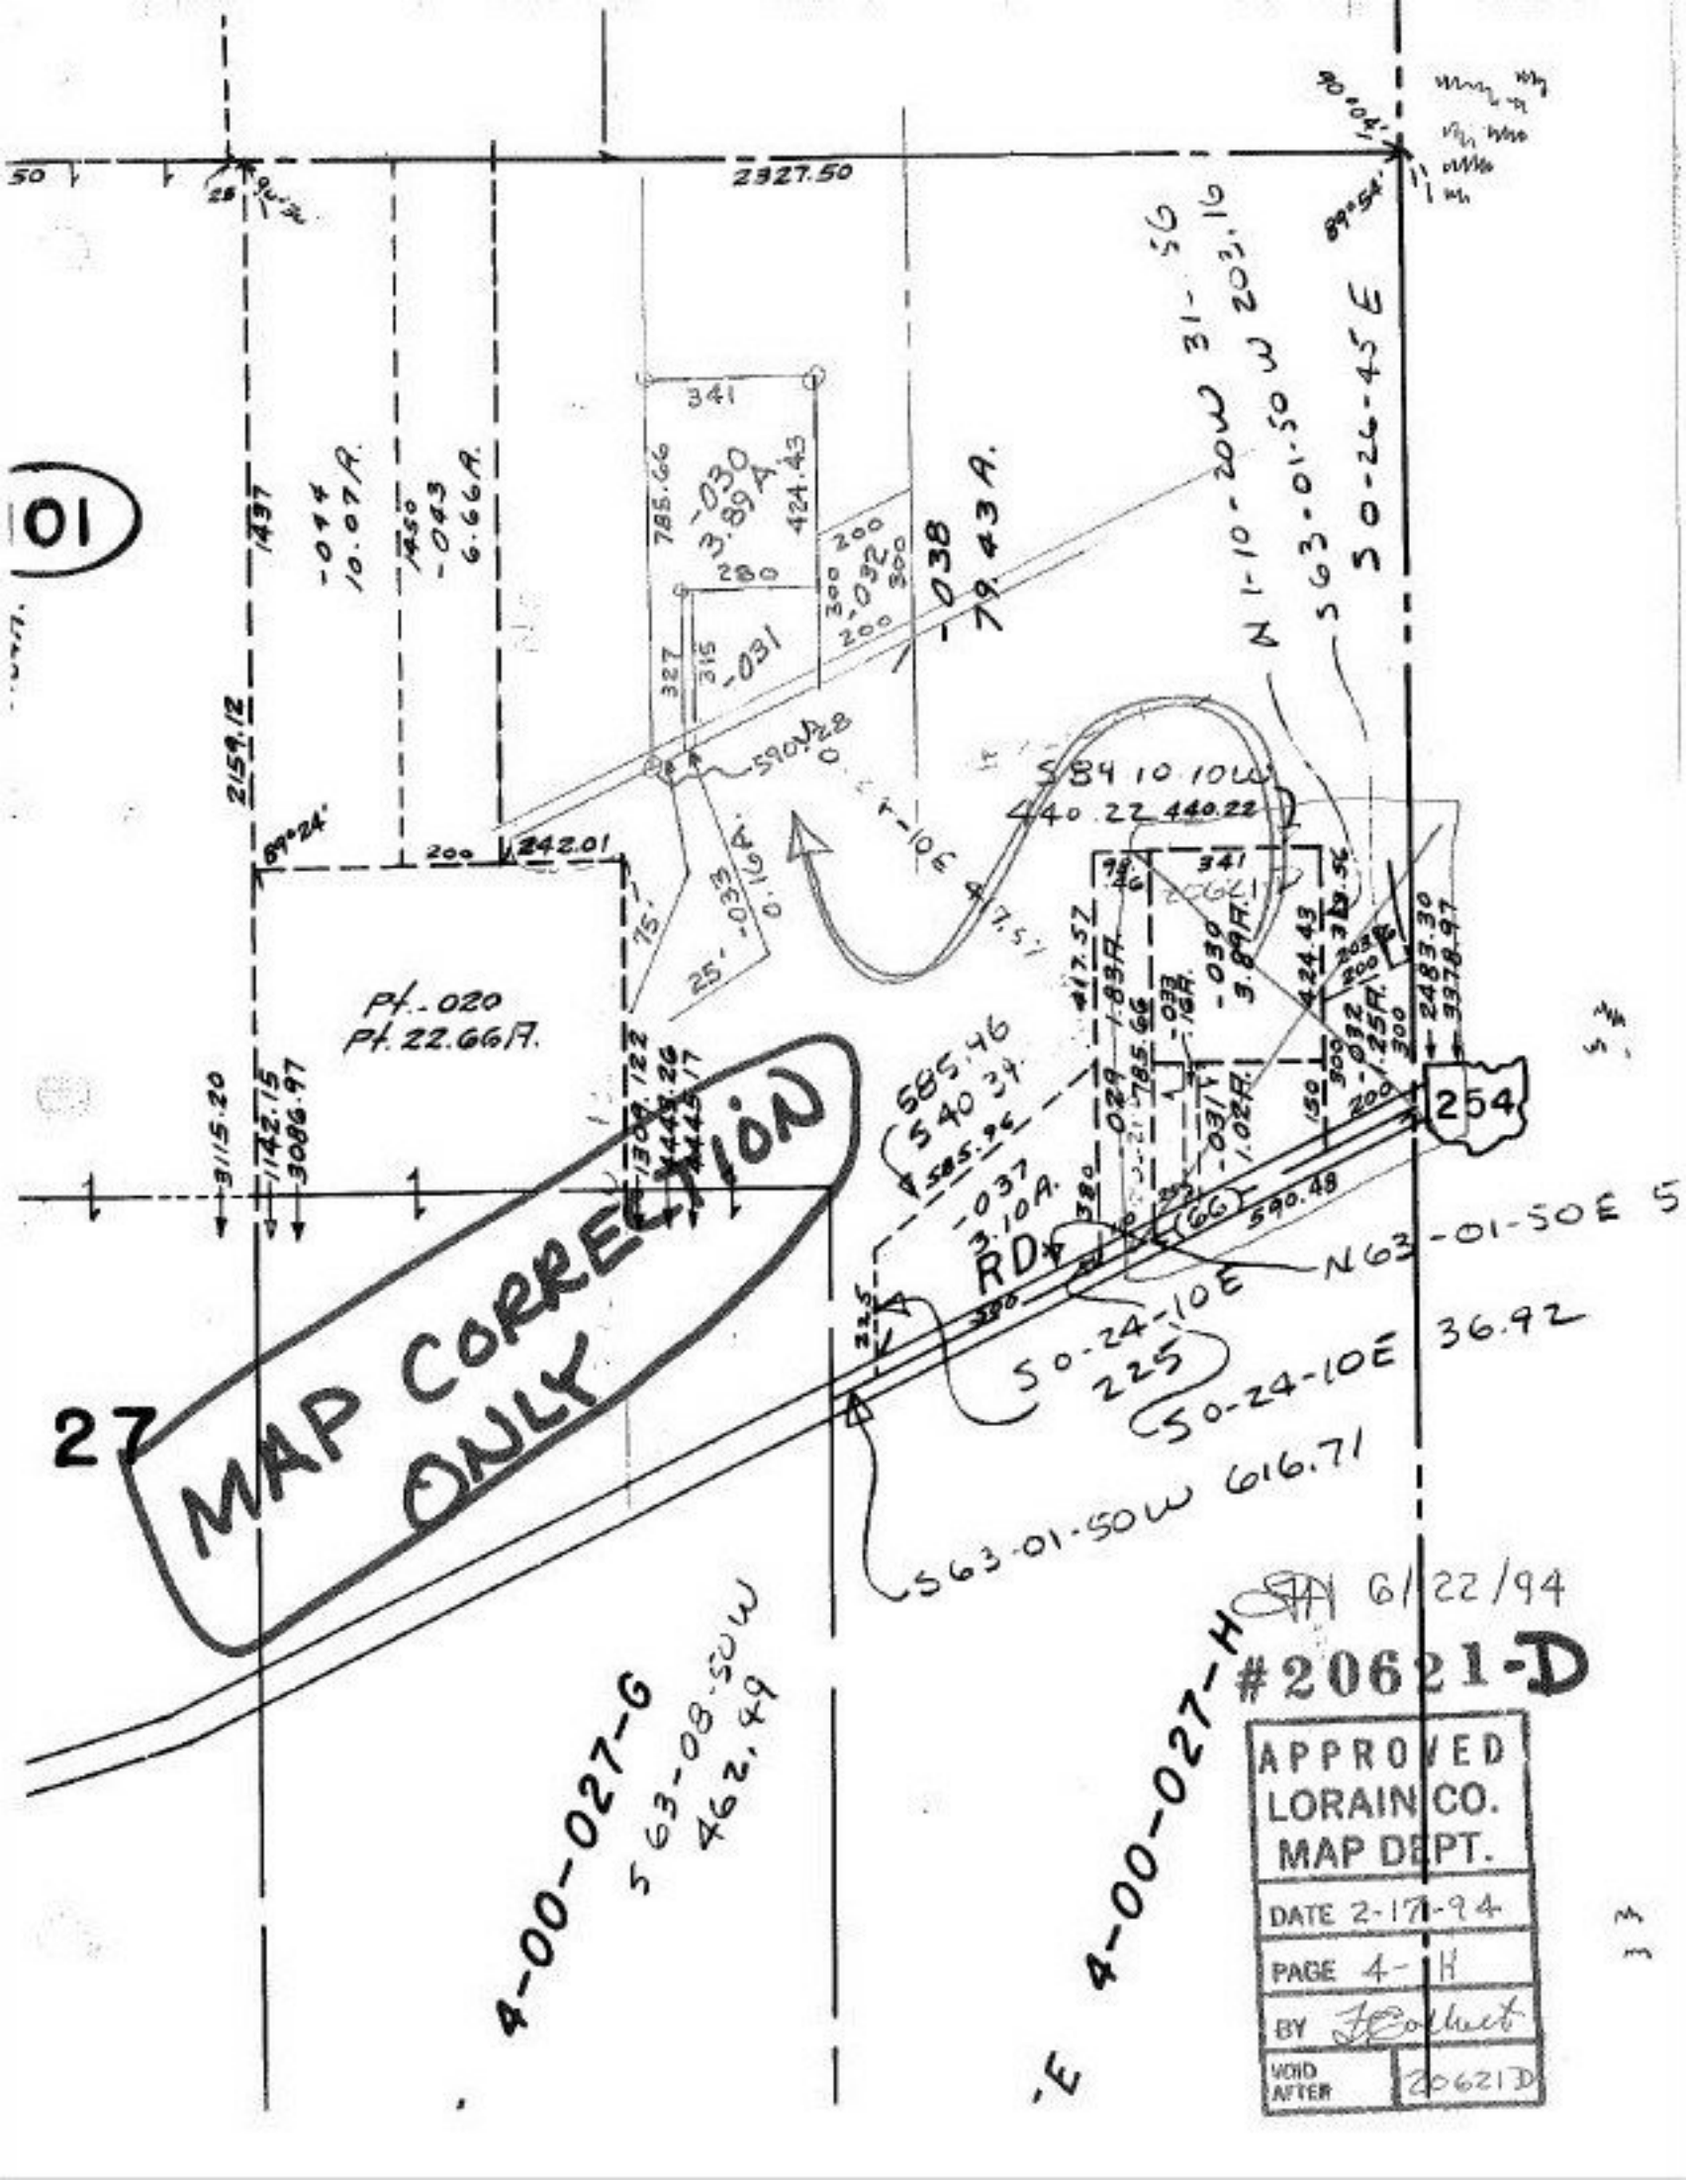

2327.50
101
27
254
Pt.-020
Pt. 22.66A.
MAP CORRECTION ONLY
RD
N63-01-50E 5
S0-24-10E 225
S0-24-10E 36.92
S63-01-50W 616.71
S63-08-50W 462.49
4-00-027-G
4-00-027-H
6/22/94
#20621-D
APPROVED
LORAIN CO.
MAP DEPT.
DATE 2-17-94
PAGE 4-H
BY
VOID AFTER 20621D