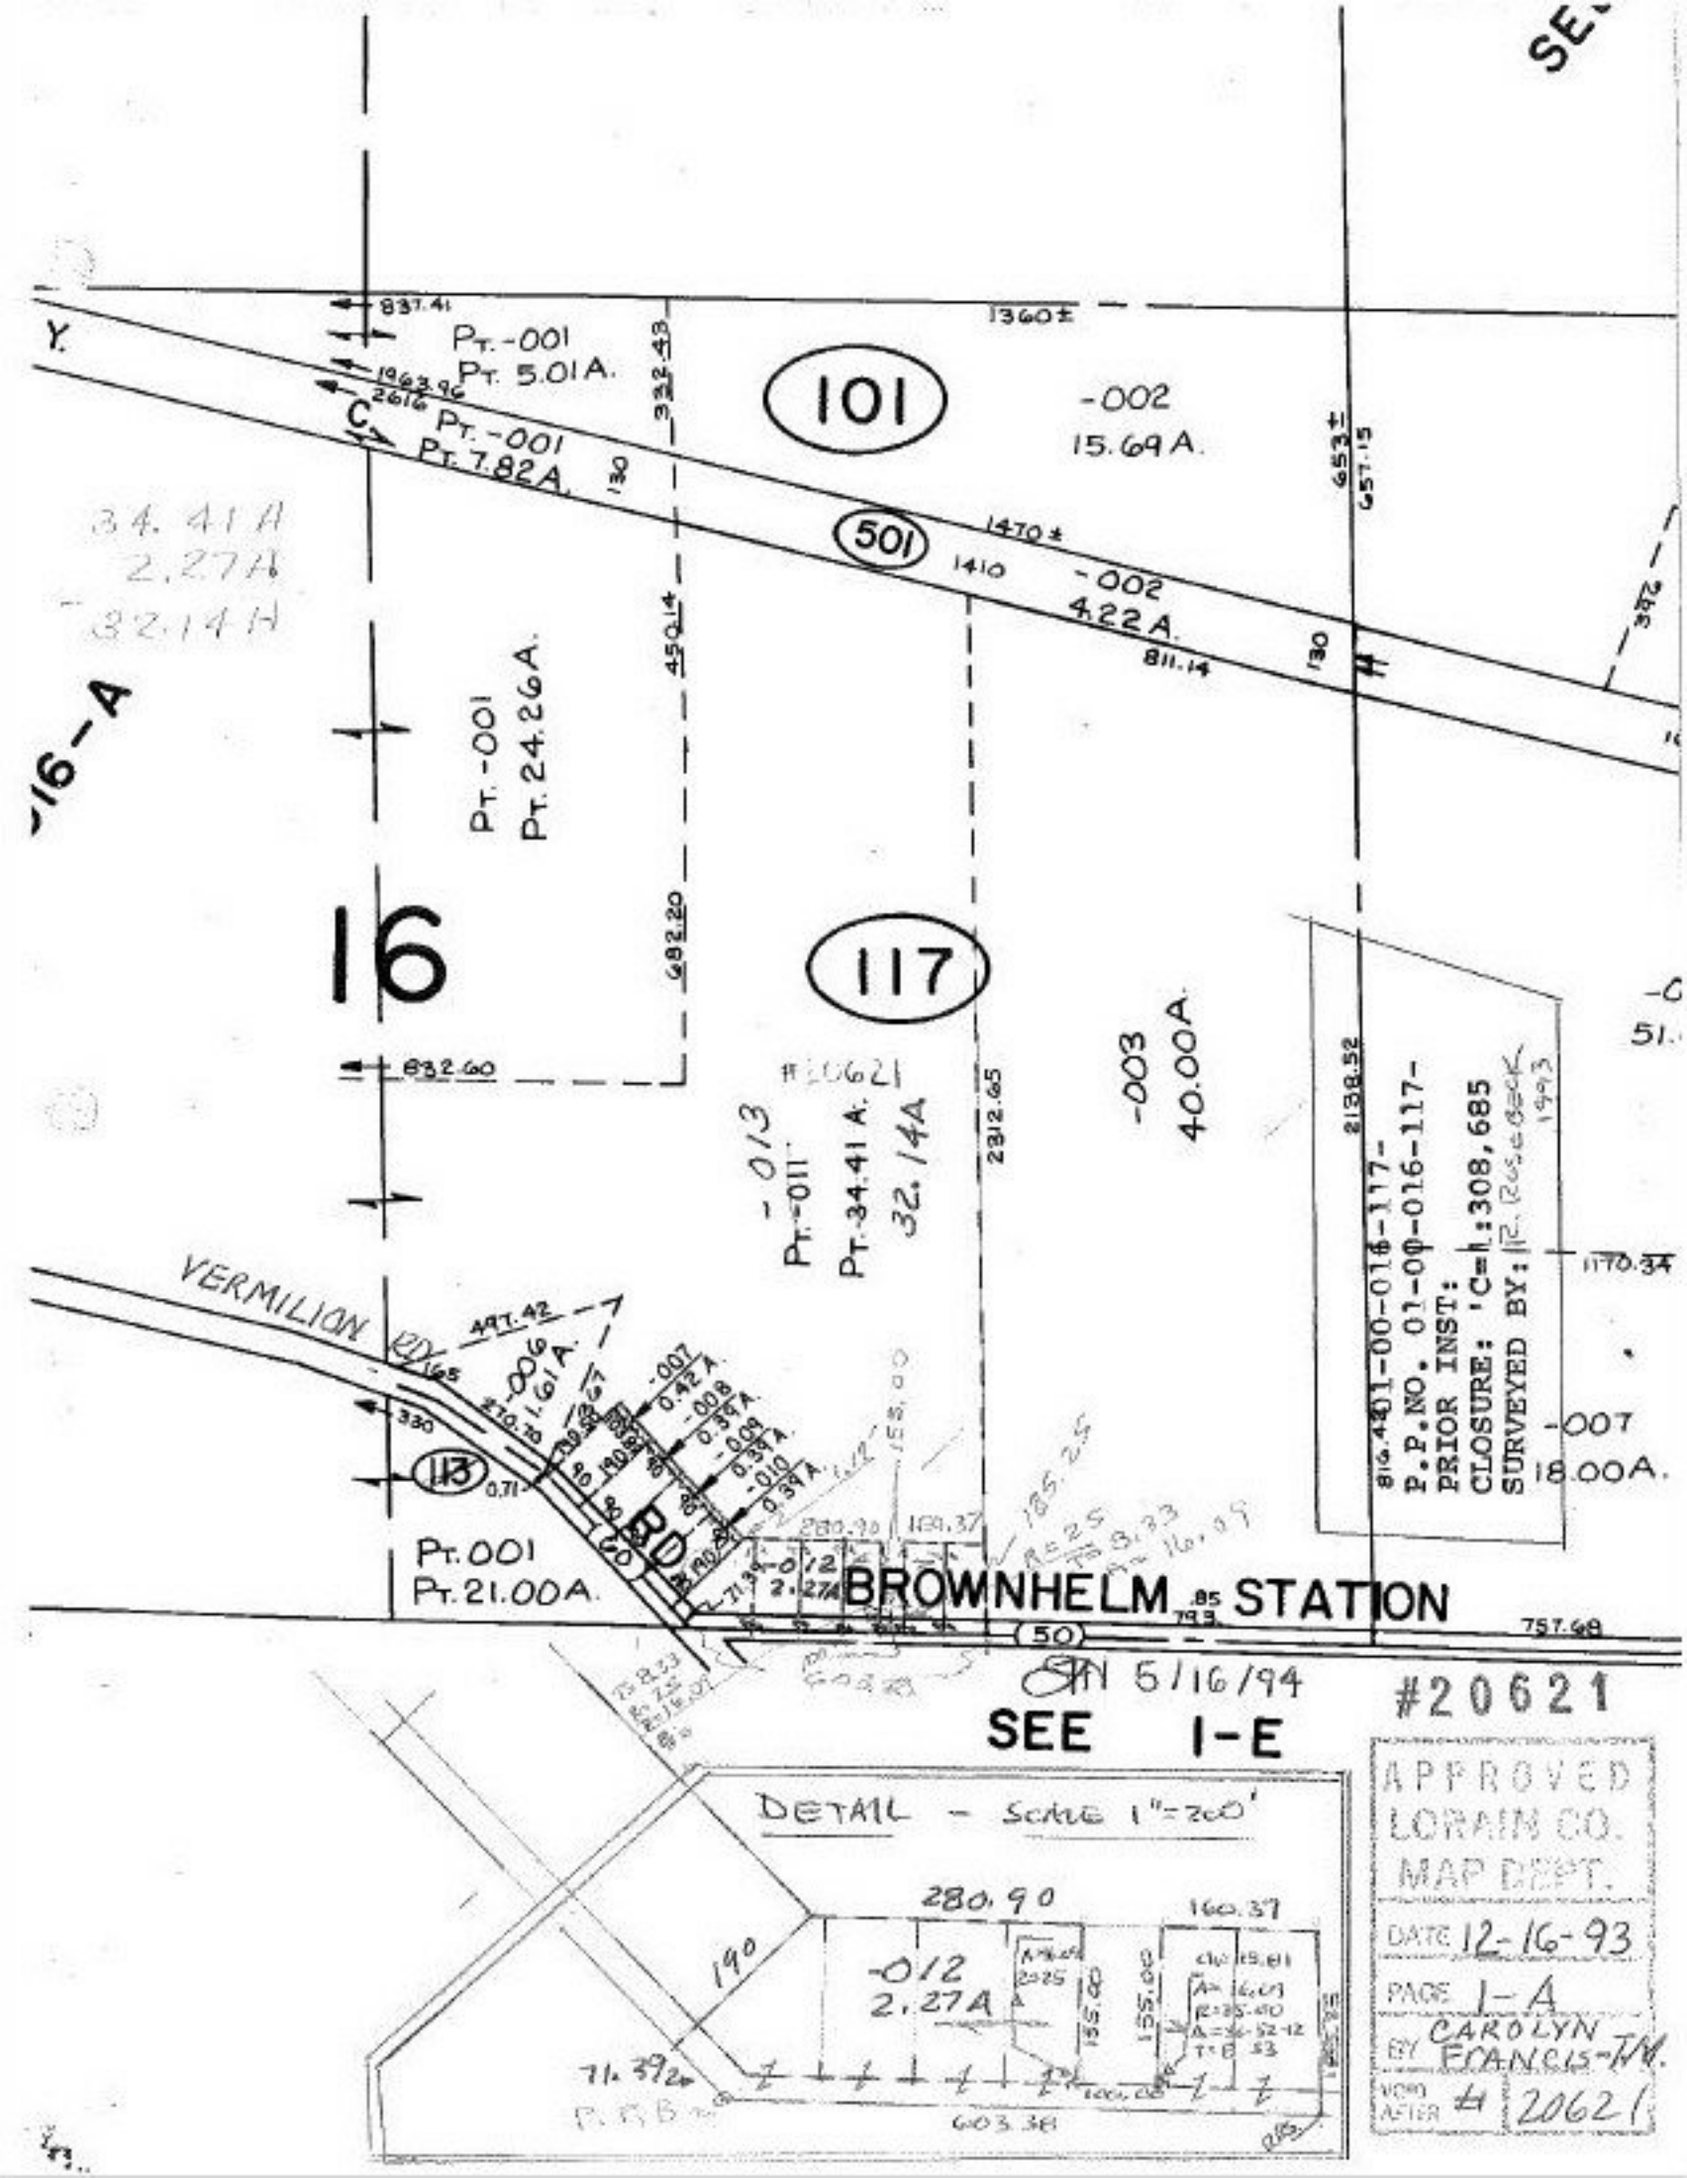

SEE
Y.
837.41
Pt.-001
Pt. 5.01A.
1963.96
2616
C
Pt.-001
Pt. 7.82A.
332.43
1360±
101
-002
15.69A.
653±
657.15
130
501
1470±
1410
-002
4.22A.
811.14
130
34.41A
2.27A
32.14A
450.14
Pt.-001
Pt. 24.26A.
16-A
16
682.20
117
832.60
#20621
-013
Pt.-011
Pt. 34.41 A.
32.14A
2312.65
-003
40.00A.
2138.52
01-00-016-117-
P.P.NO. 01-00-016-117-
PRIOR INST:
CLOSURE: 'C=1:308,685
SURVEYED BY: R. Rosebeck 1993
1170.34
VERMILION RD
497.42
-006
1.61A.
-007
0.42A.
-008
0.39A.
-009
0.39A.
-010
0.39A.
330
113
0.71
RD
Pt.001
Pt. 21.00A.
280.90
160.37
-012
2.27A
BROWNHELM STATION
50
757.68
-007
18.00A.
5/16/94
SEE 1-E
#20621
DETAIL - SCALE 1"=200'
280.90
160.37
190
-012
2.27A
155.00
155.00
71.39
603.38
APPROVED
LORAIN CO.
MAP DEPT.
DATE 12-16-93
PAGE 1-A
BY CAROLYN FRANCIS-TM.
VOID AFTER # 20621