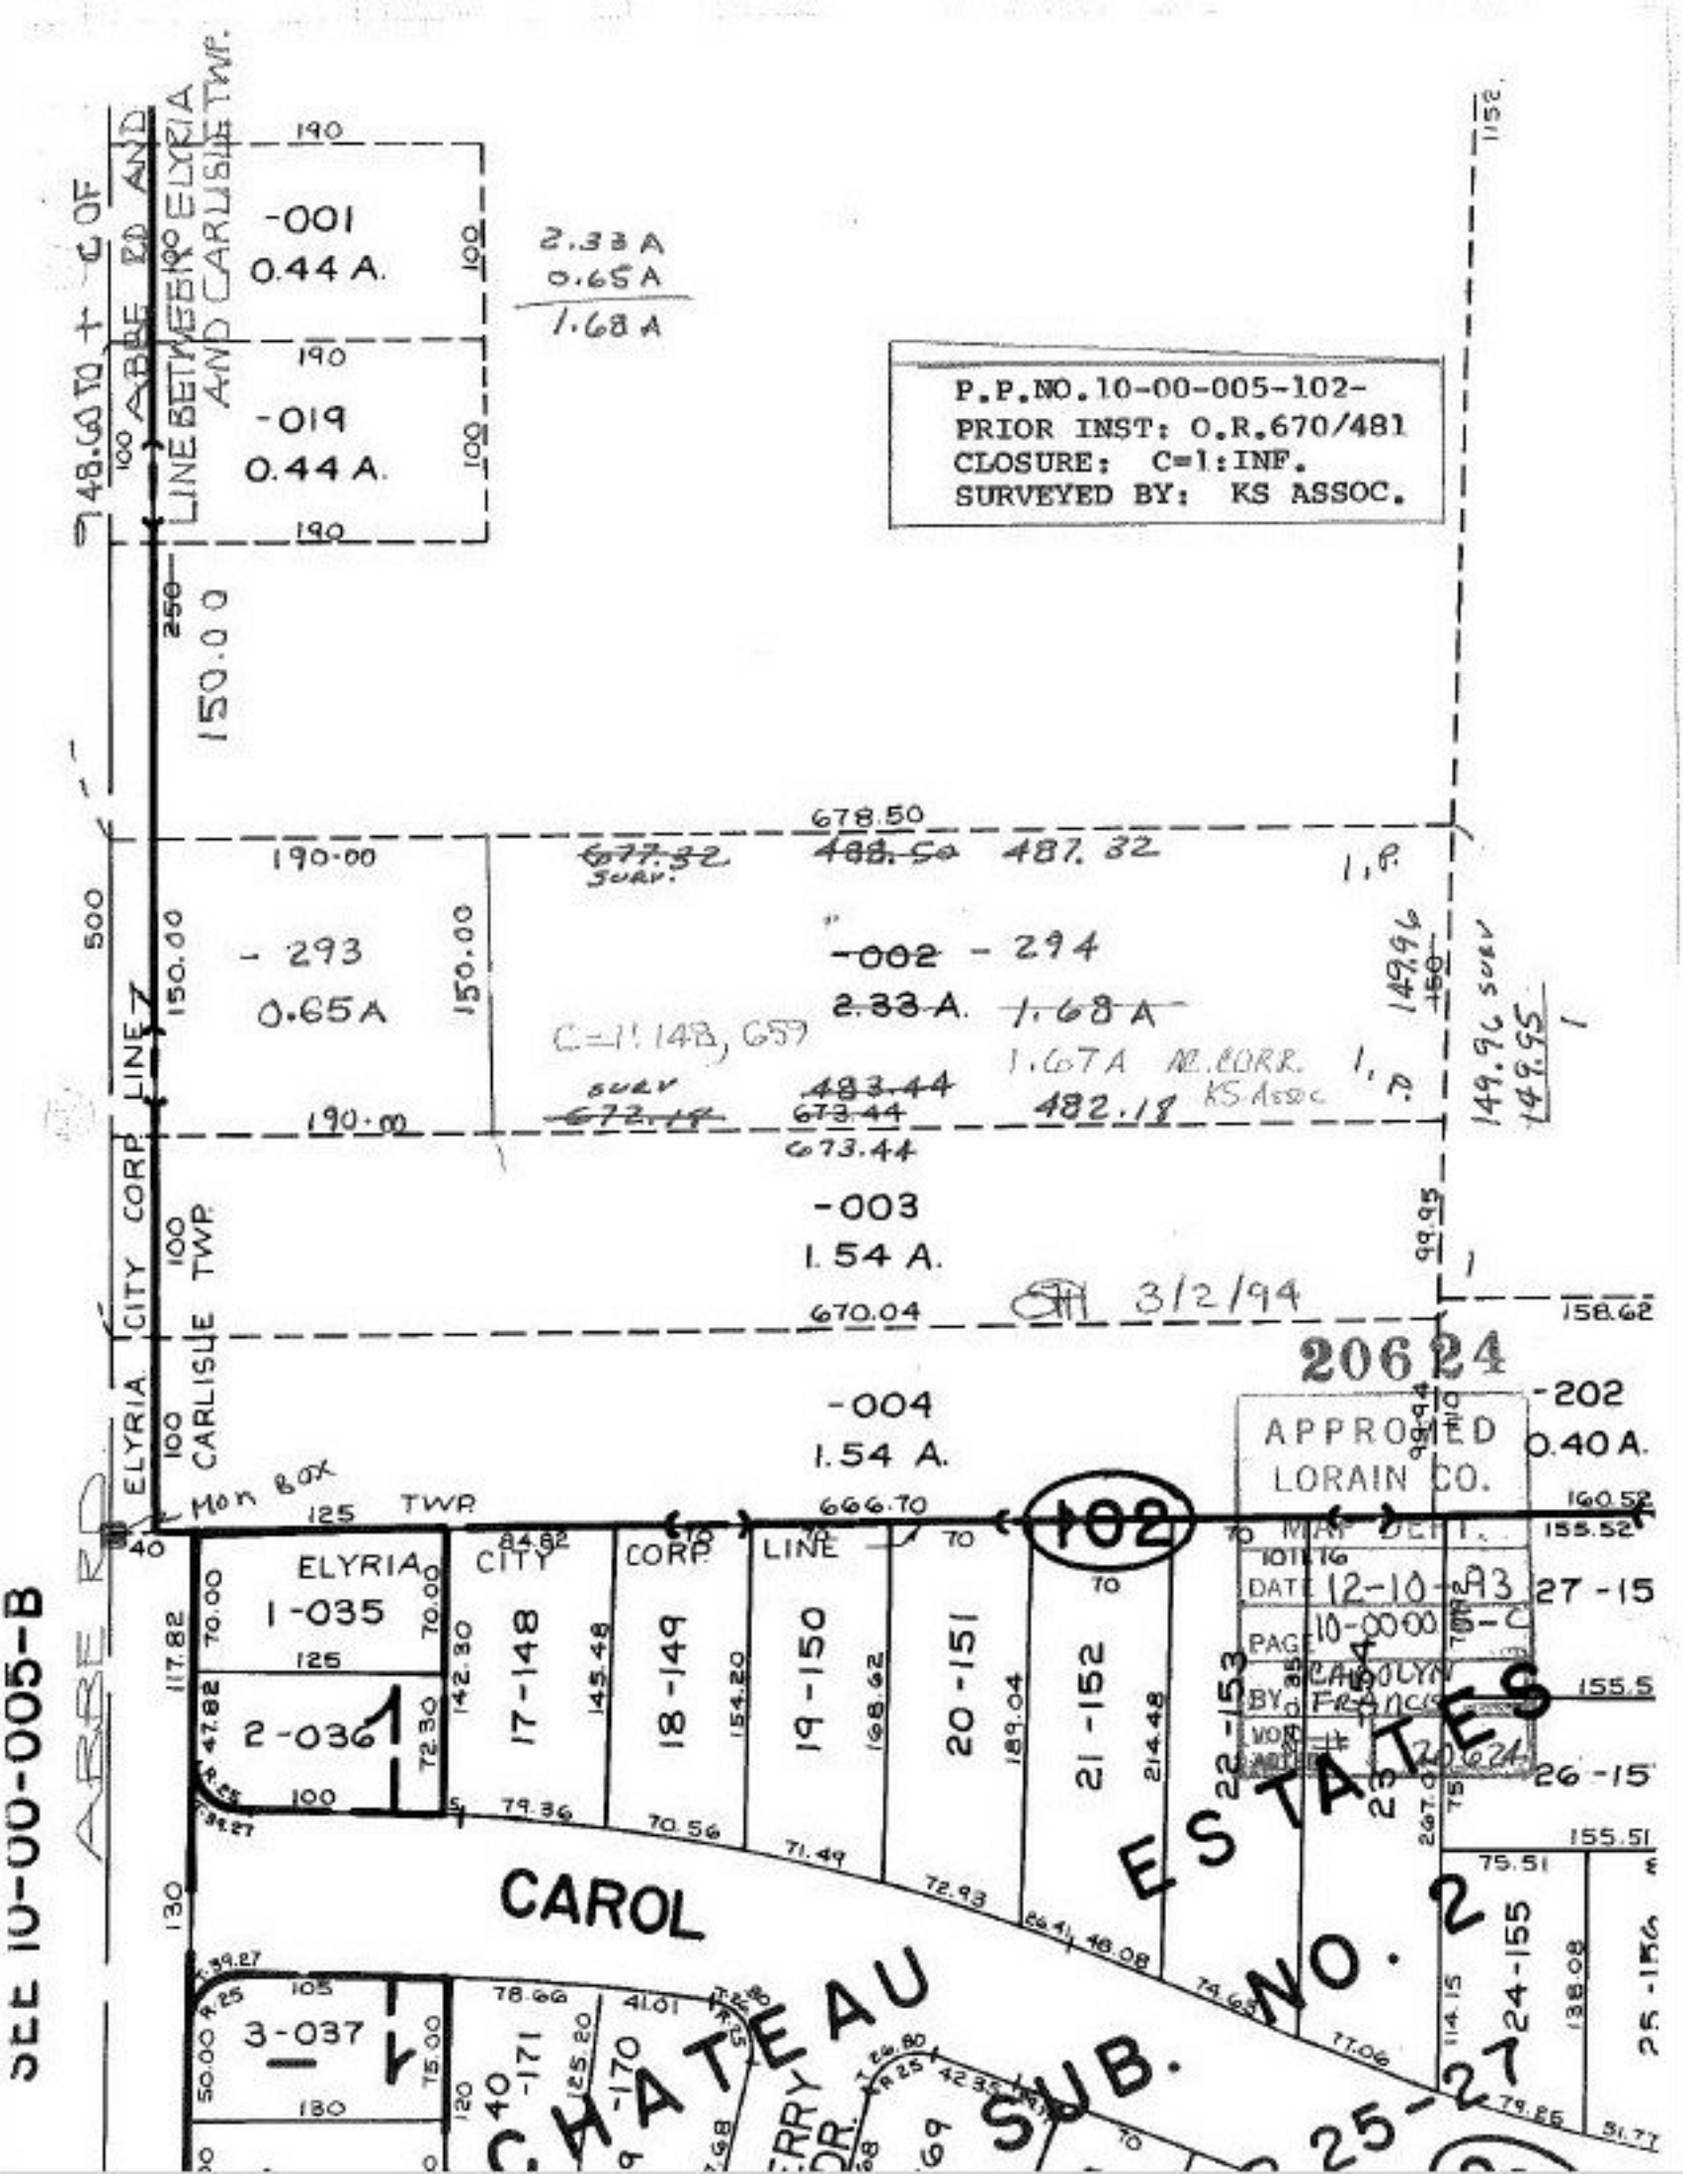
P.P.NO. 10-00-005-102-
PRIOR INST: O.R.670/481
CLOSURE: C=1:INF.
SURVEYED BY: KS ASSOC.
LINE BETWEEN ELYRIA AND CARLISLE TWP.
ABBE RD
ELYRIA CITY CORP LINE
ELYRIA CARLISLE TWP
-001 0.44 A.
-019 0.44 A.
2.33 A
0.65 A
1.68 A
-293 0.65 A
-002 - 294
2.33 A. 1.68 A
1.67 A MEAS. KS ASSOC
-003 1.54 A.
-004 1.54 A.
-202 0.40 A.
APPROVED LORAIN CO.
DATE 12-10-93
PAGE 10-00-00
BY CAROLYN FRANCIS
20624
CAROL
CHATEAU ESTATES SUB. NO. 2
ELYRIA 1-035
2-036
3-037
17-148
18-149
19-150
20-151
21-152
22-153
23-154
24-155
25-156
26-15
27-15
102
SEE 10-00-005-B