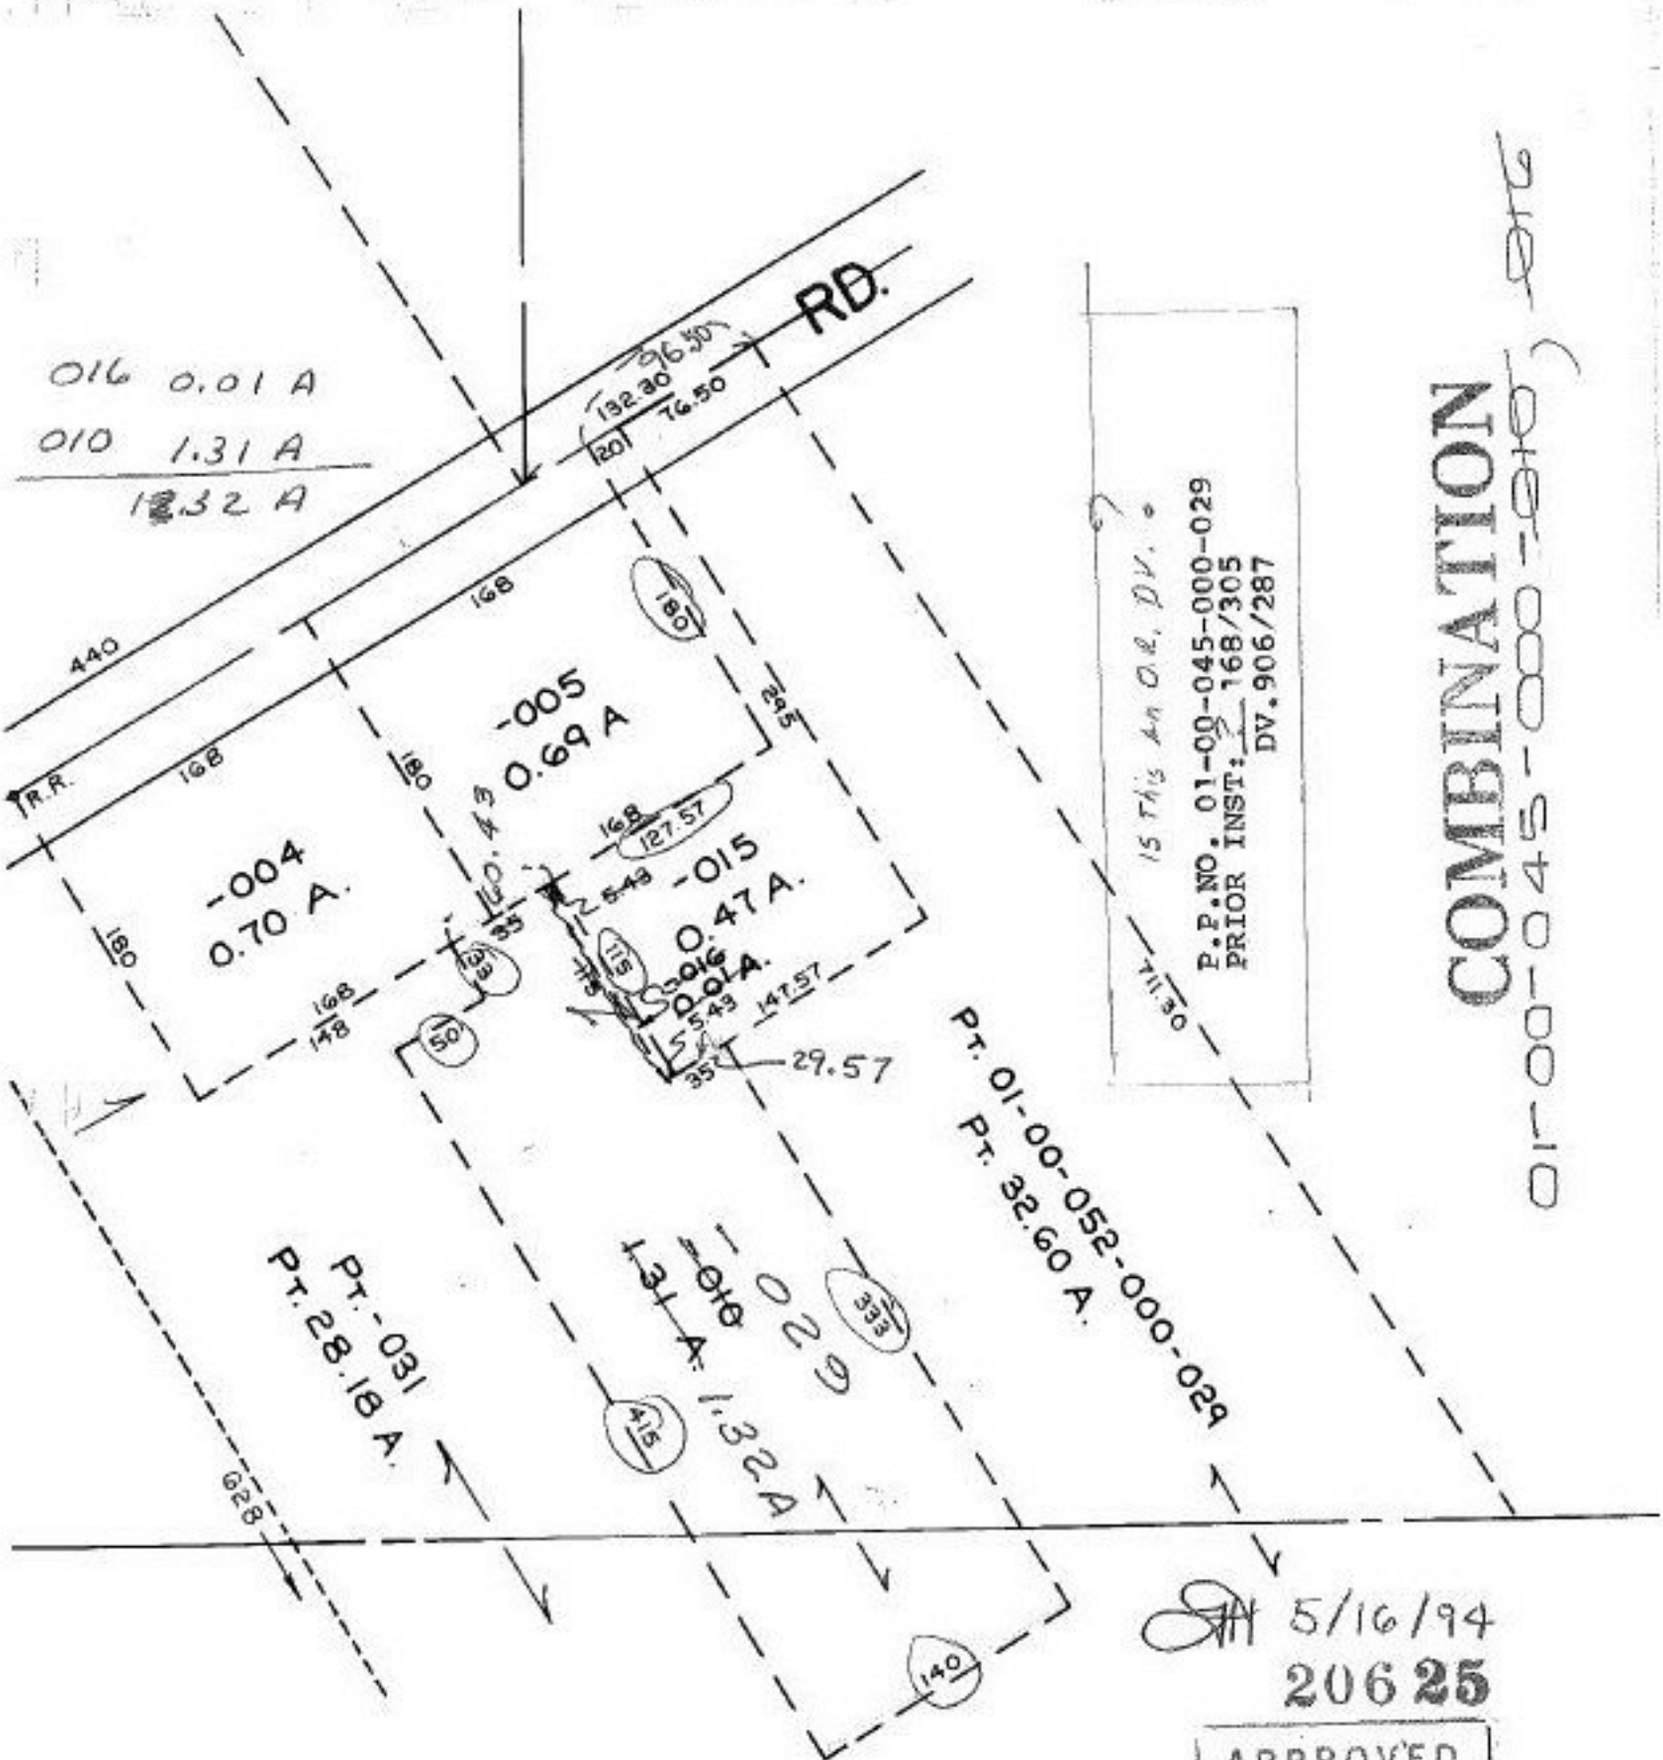

5/16/94

20625

APPROVED
LORAIN CO.
MAP DEPT.

DATE 12-13-93

PAGE 1-00-045A

BY CAROLYN FRANCIS

VOID AFTER # 20625