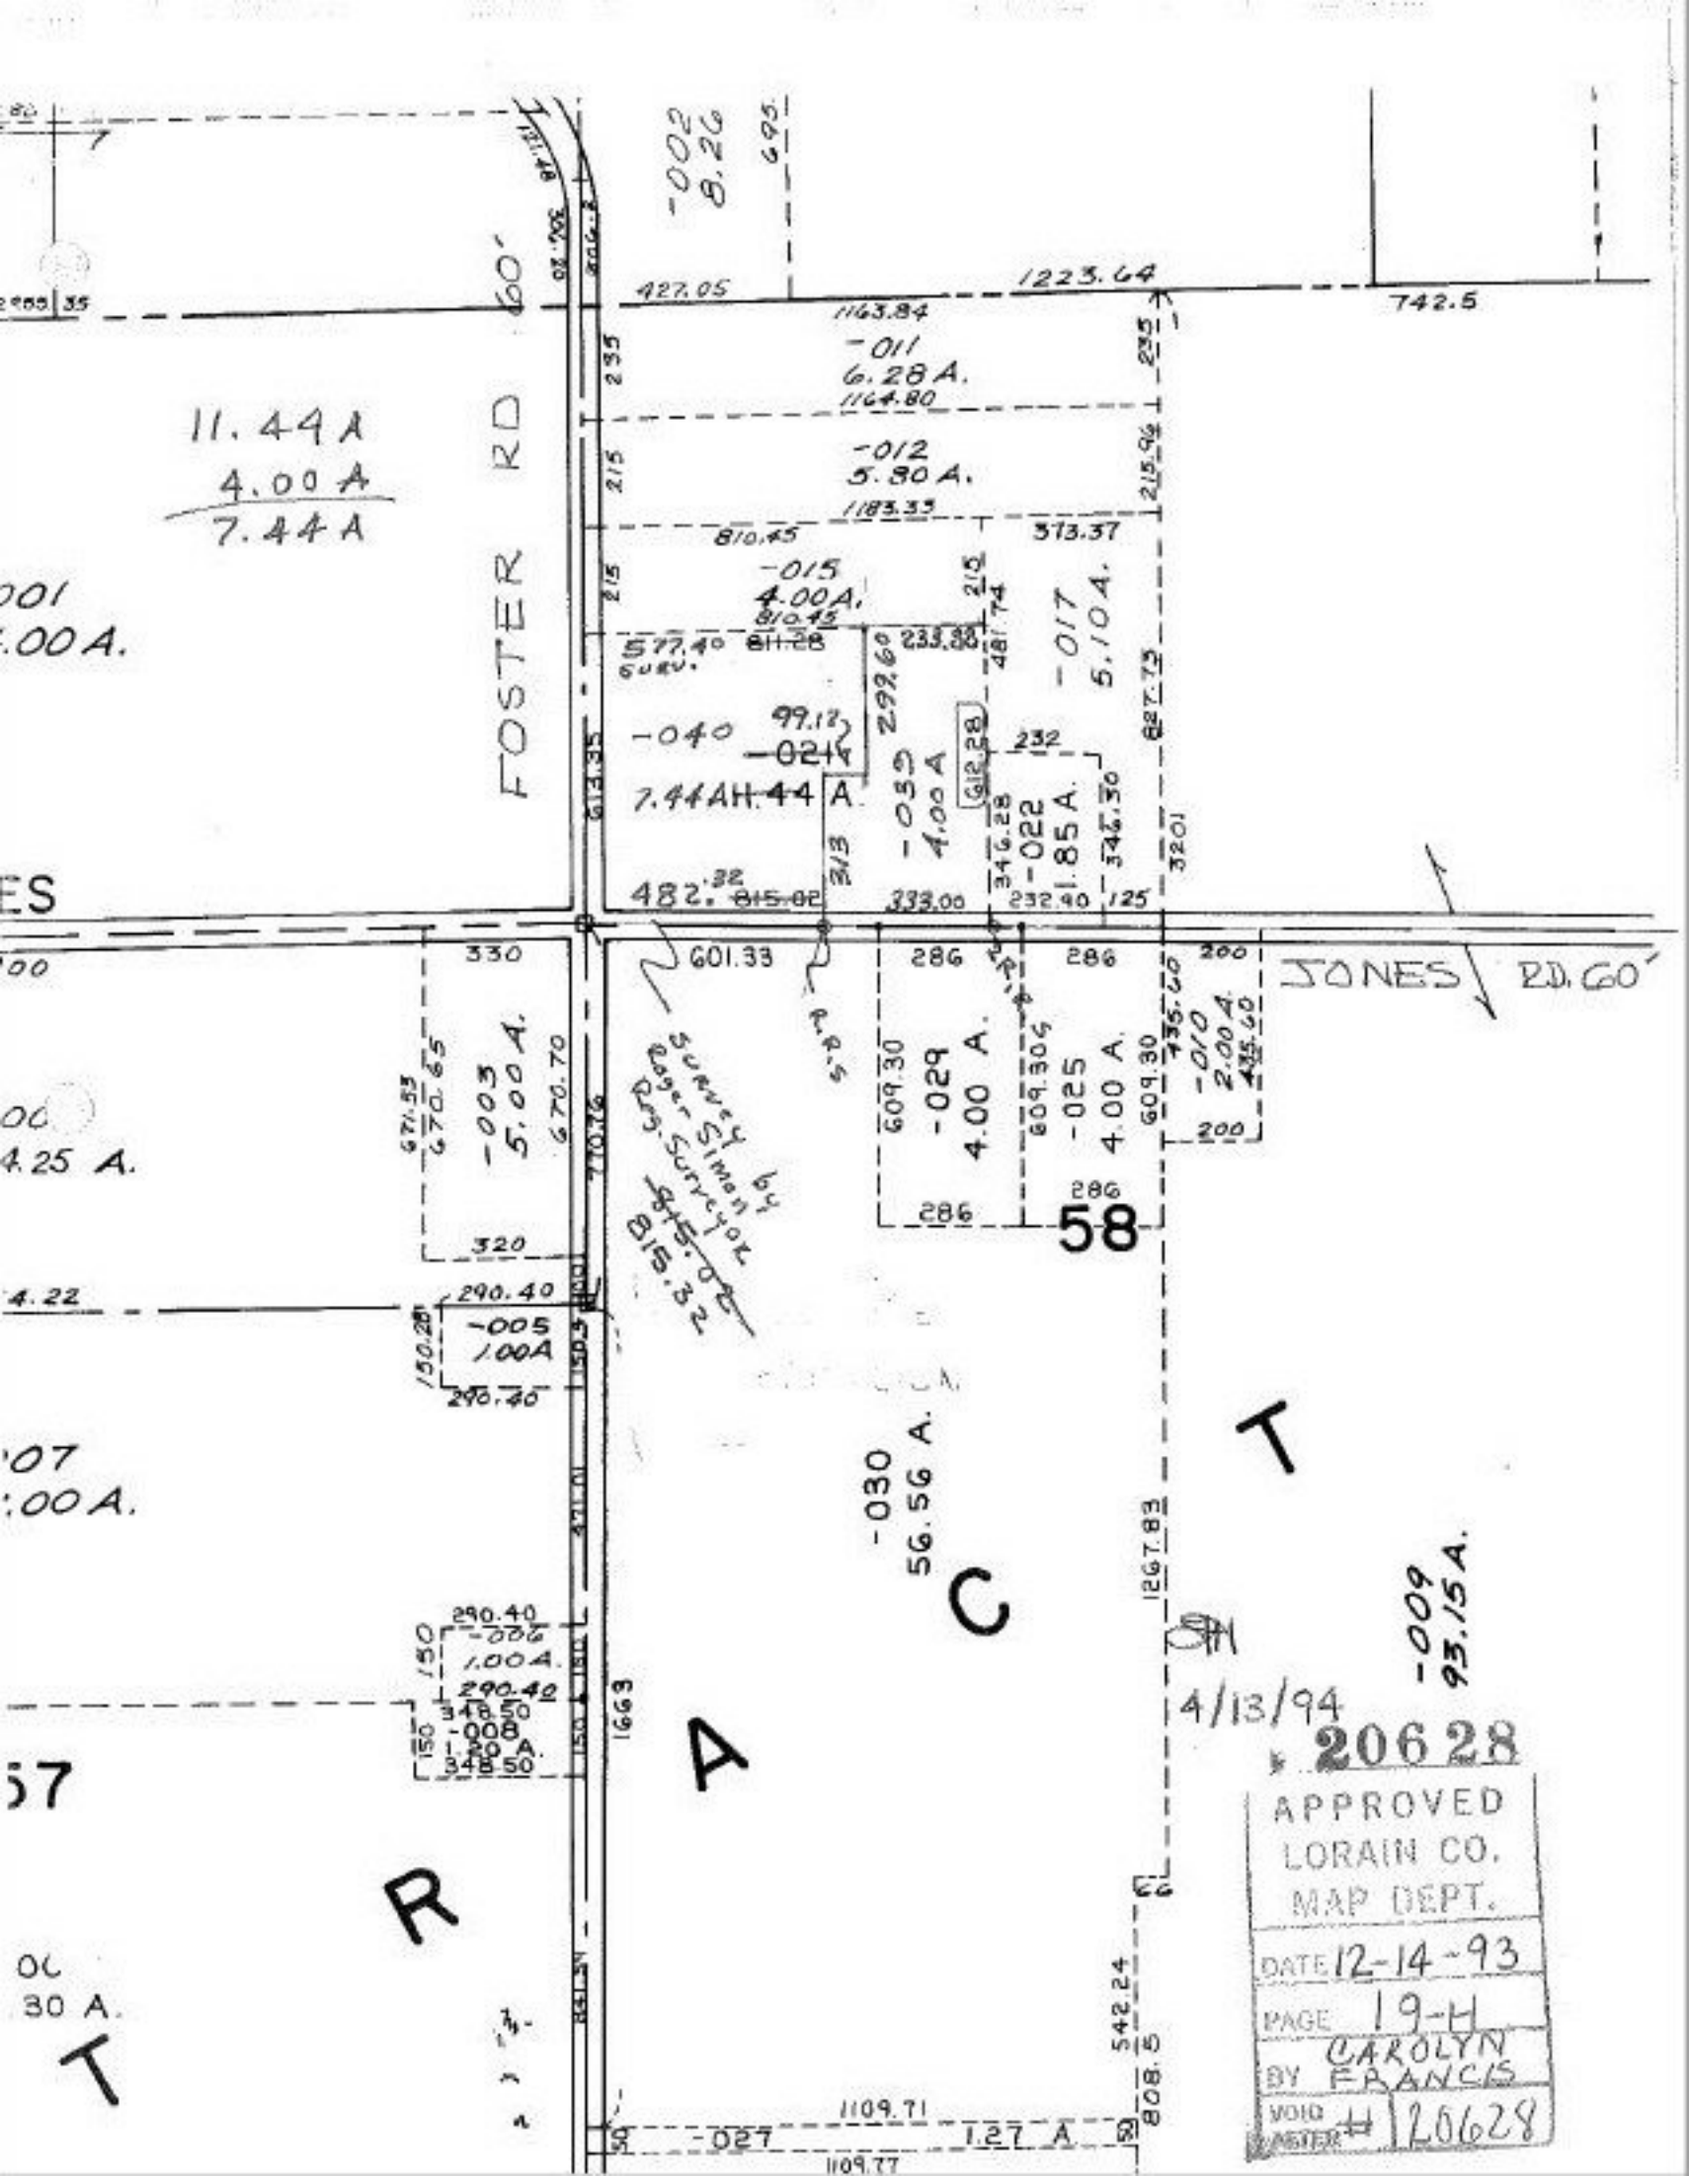
FOSTER RD 60'
JONES RD. 60'
11.44 A
4.00 A
7.44 A
-002
8.26
427.05
1223.64
742.5
1163.84
-011
6.28 A.
1164.80
-012
5.80 A.
1183.33
810.45
373.37
-015
4.00 A.
810.45
577.40
811.28
233.85
292.60
481.74
-017
5.104.
627.75
-040
99.12
-021
7.44 A
-039
4.00 A
-022
1.85 A.
346.28
346.30
482.32
815.02
333.00
232.40
125
3201
601.33
330
-003
5.00 A.
670.65
671.53
670.70
320
286
609.30
-029
4.00 A.
609.30
-025
4.00 A.
609.30
435.60
-010
2.004
435.60
200
58
290.40
-005
1.00A
290.40
150.28
150.03
Survey Simon 64
Roger Survey
815.32
-030
56.56 A.
1267.83
-009
93.15A.
290.40
-006
1.00A.
290.40
348.50
-008
1.20 A.
348.50
150
1663
542.24
808.5
1109.71
-027
1.27 A
1109.77
4/13/94
20628
APPROVED
LORAIN CO.
MAP DEPT.
DATE 12-14-93
PAGE 19-H
CAROLYN
BY FRANCIS
VOID
ASTER # 20628