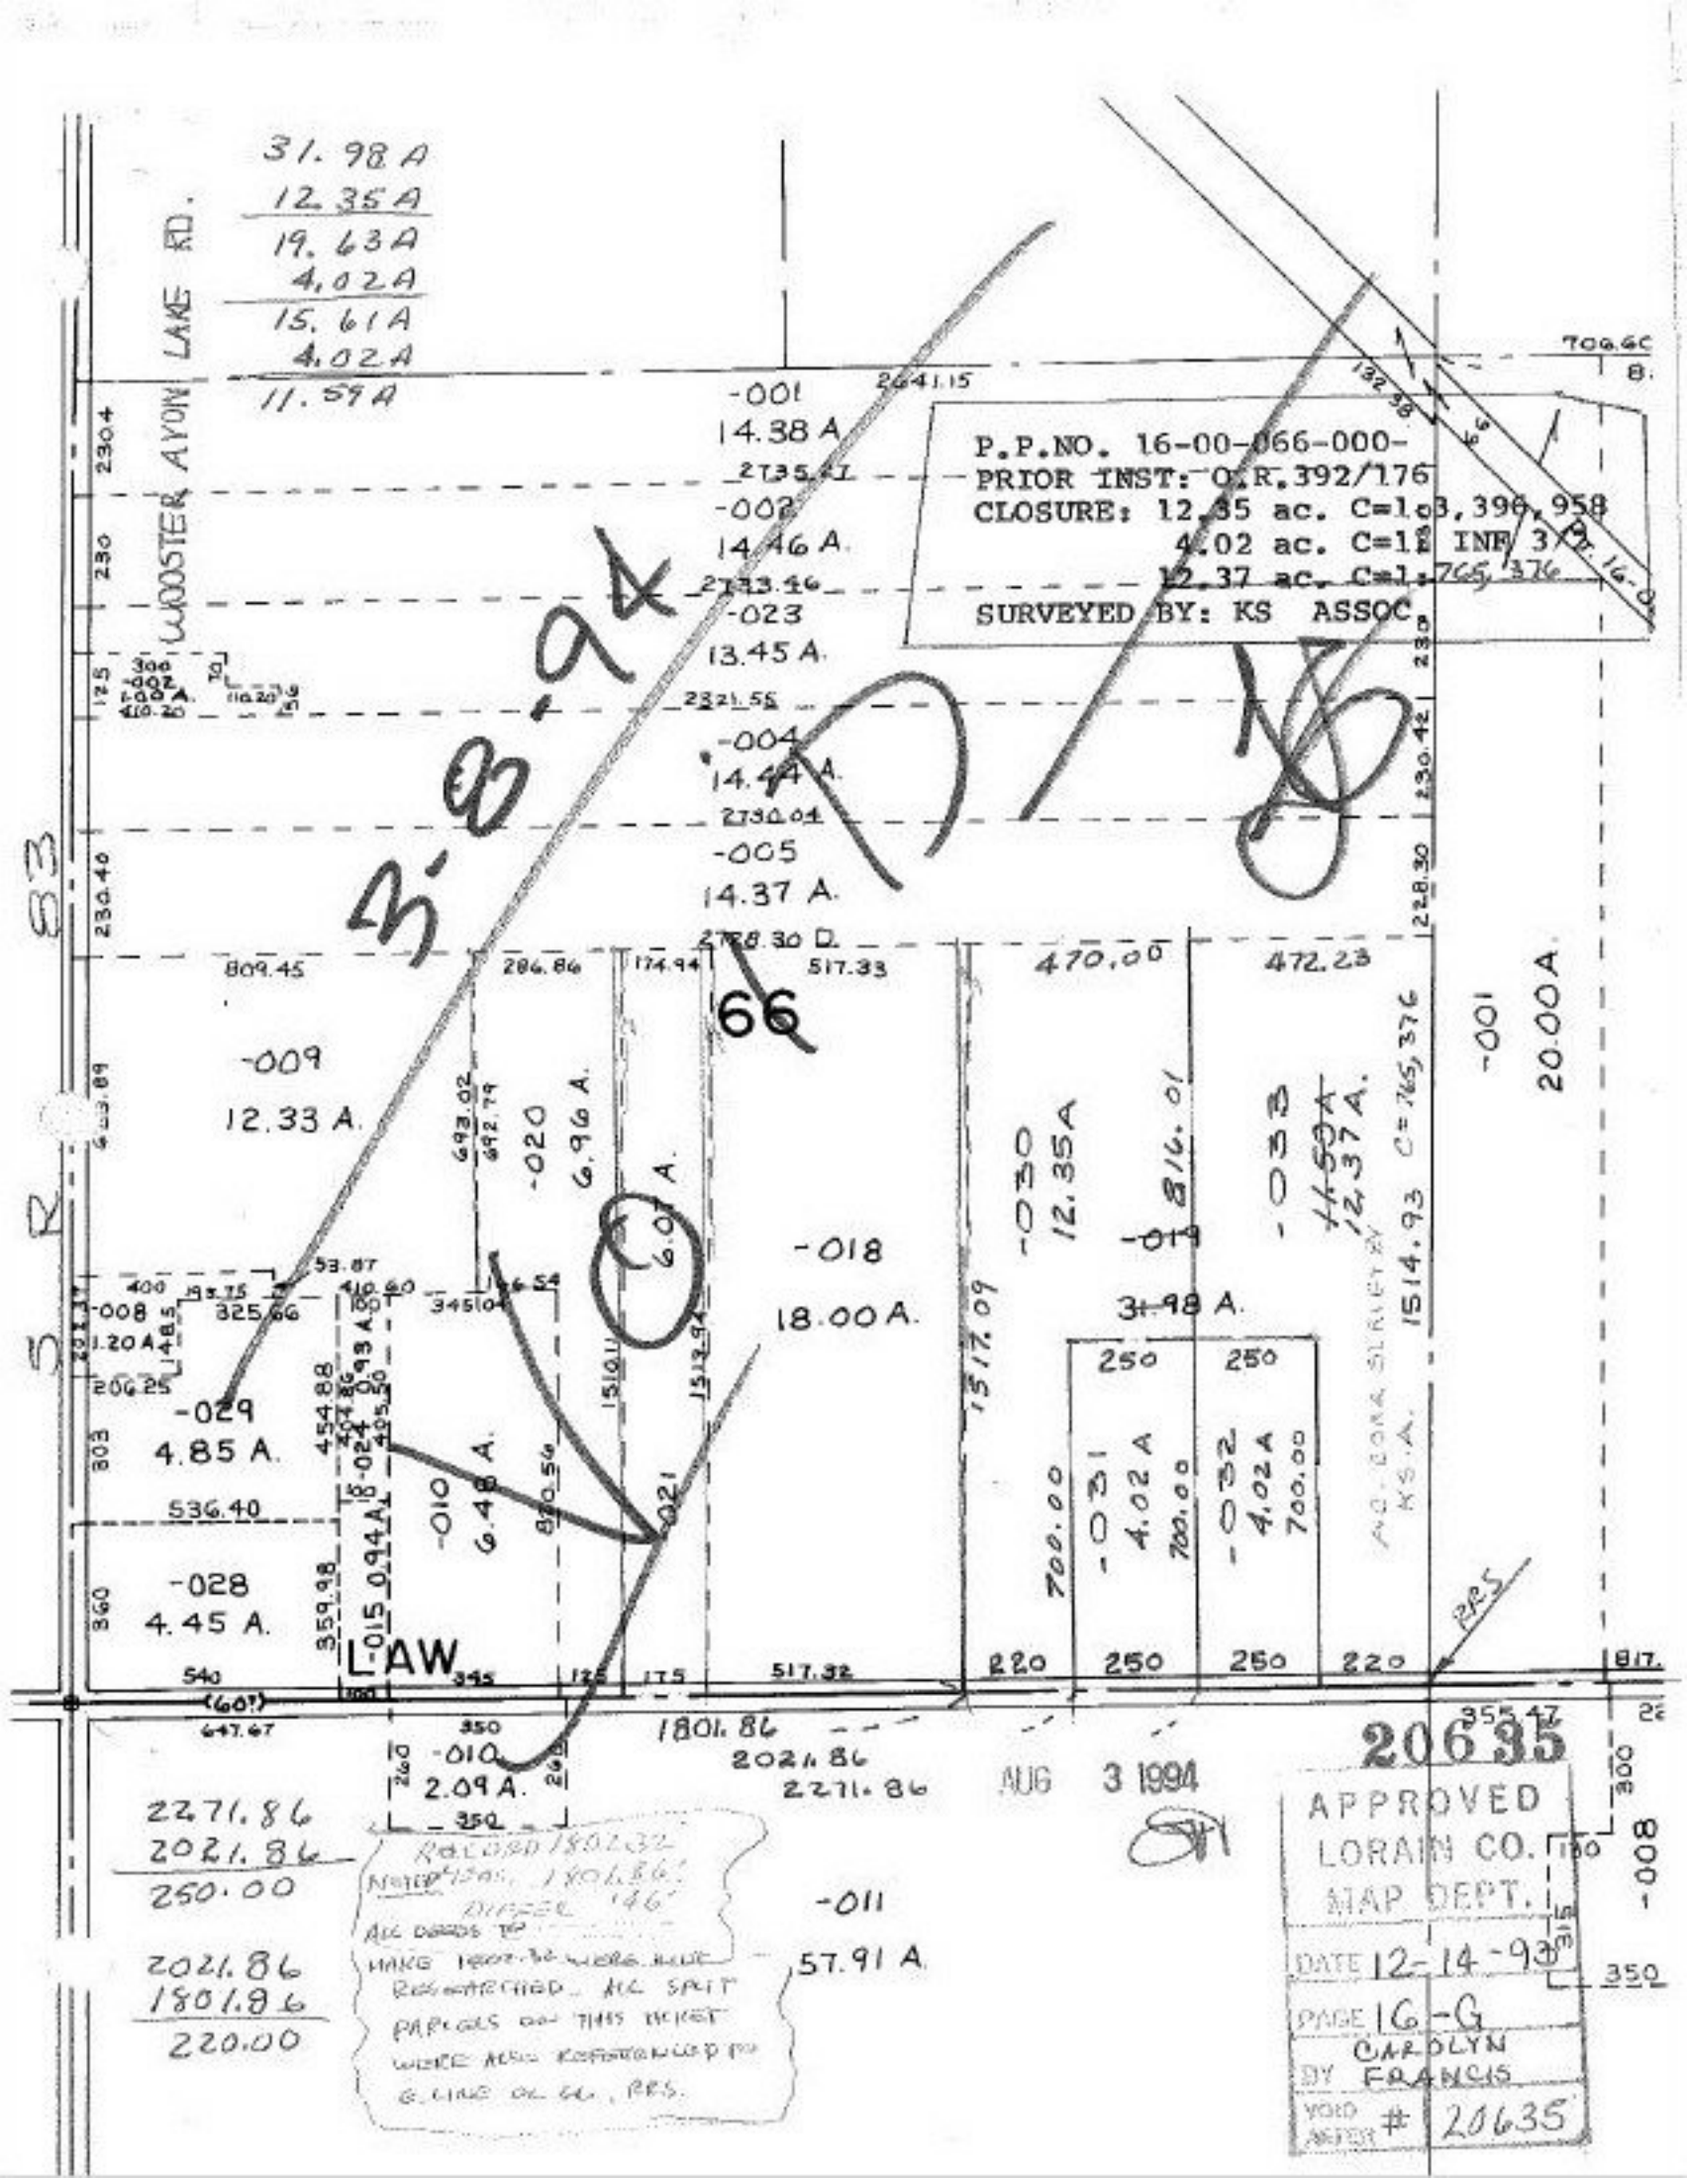
31.98 A
12.35 A
19.63 A
4.02 A
15.61 A
4.02 A
11.59 A
WOOSTER AYON LAKE RD.
-001
14.38 A
-002
14.46 A
-023
13.45 A
-004
14.44 A
-005
14.37 A
P.P.NO. 16-00-066-000-
PRIOR INST: O.R.392/176
CLOSURE: 12.35 ac. C=1.000,396,958
4.02 ac. C=1.000 INF 3 O.R. 16-00
12.37 ac. C=1.765,376
SURVEYED BY: KS ASSOC.
-009
12.33 A.
-020
6.96 A.
-018
18.00 A.
-030
12.35A
-033
12.37 A.
-001
20.00A.
-029
4.85 A.
-028
4.45 A.
-010
6.48 A.
-031
4.02 A
-032
4.02 A
-011
57.91 A
-010
2.09 A.
-008
1.20 A.
L-015 0.94 A.
LAW
RRS
(60')
2271.86
2021.86
250.00
2021.86
1801.86
220.00
RECORD 1801.32
MEAS 1801.86
DIFFER .46'
ALL DEEDS TO
MAKE 1801.86 WHERE SAME
RECTIFIED. ALL SPLIT
PARCELS ON THIS DESKET
WERE ALSO RECTIFIED TO
E. LINE OF SEC. RRS.
AUG 3 1994
APPROVED
LORAIN CO.
MAP DEPT.
DATE 12-14-93
PAGE 16-G
BY CAROLYN FRANCIS
VOID AFTER # 20635
20635