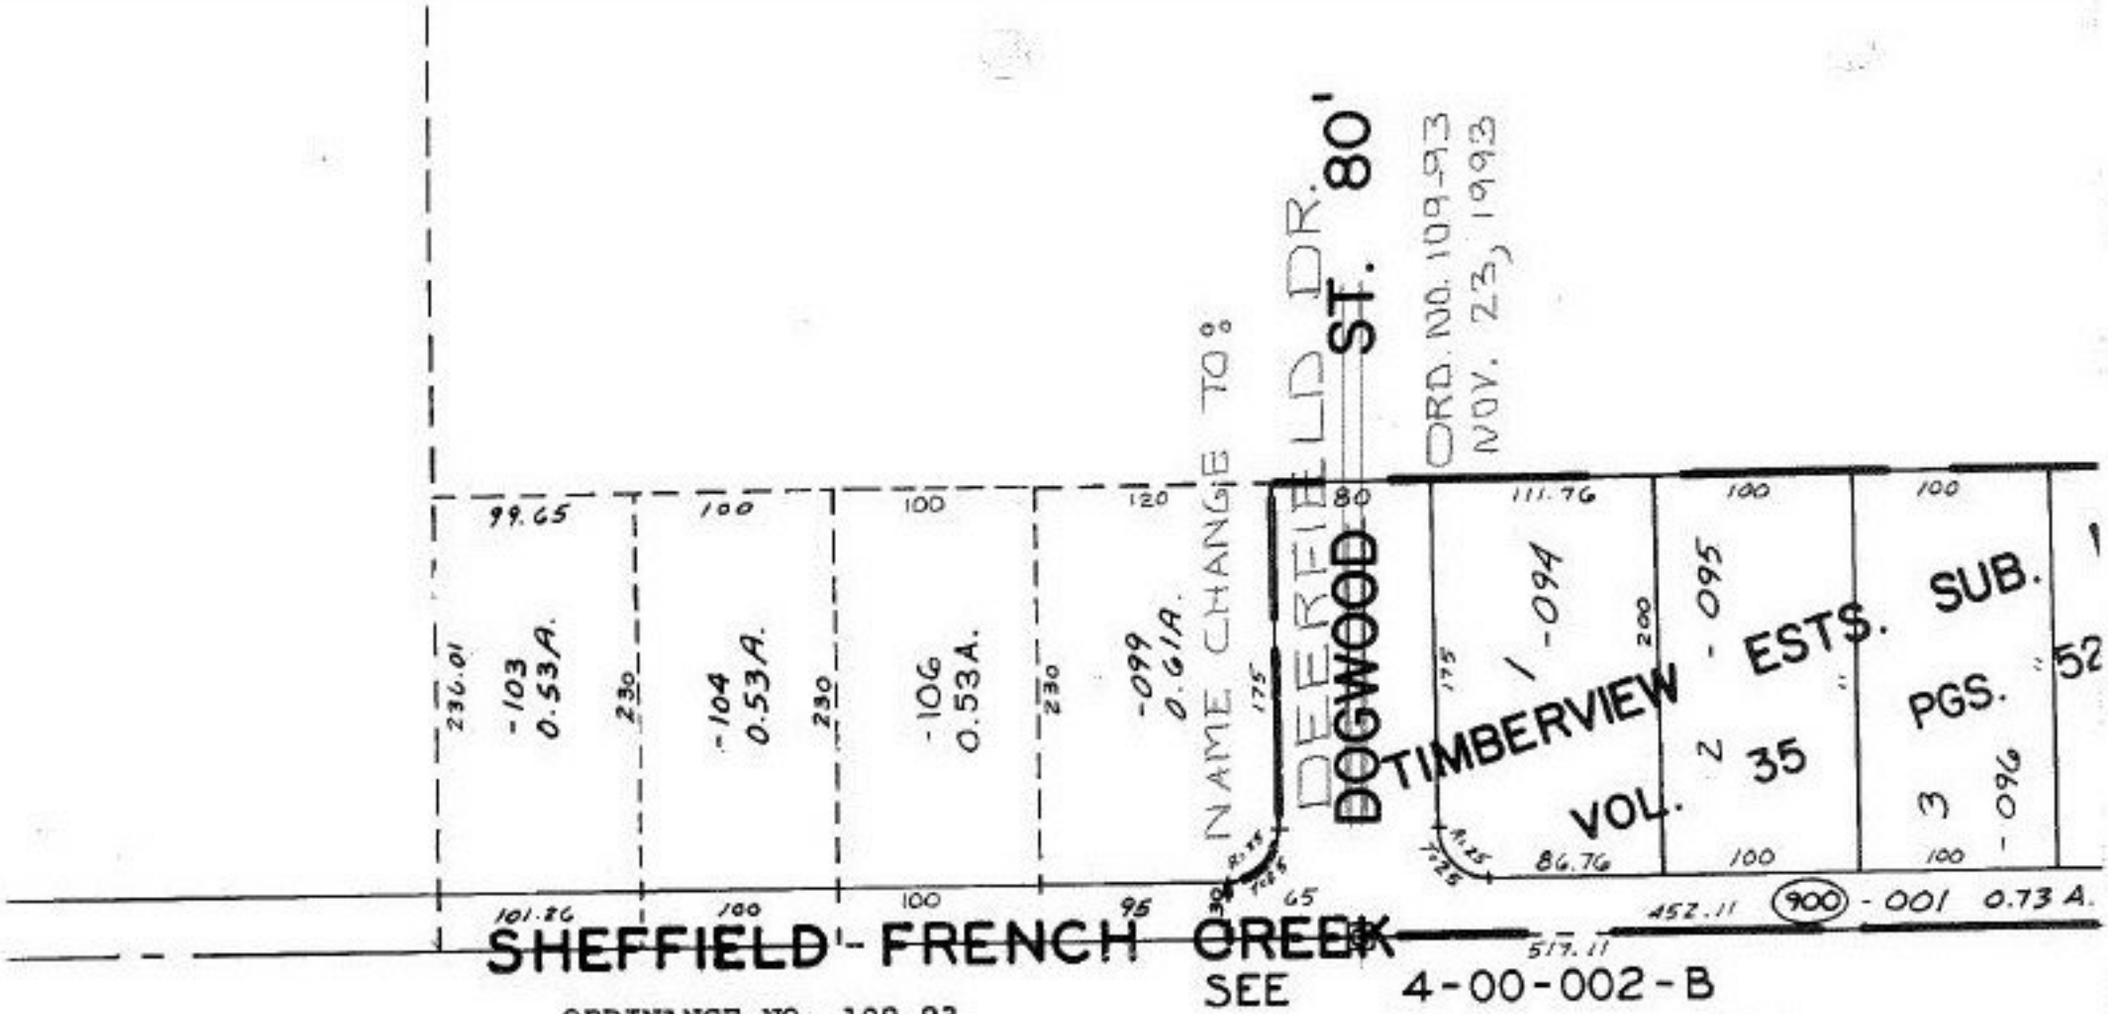

ORDINANCE NO. 109-93

AN ORDINANCE TO CHANGE THE NAME OF DOGWOOD STREET TO DEERFIELD DRIVE IN TIMBERVIEW ESTATES SUBDIVISION NO. 1XXXX

20638-0 6/22/94

APPROVED
LORAIN CO.
MAP DEPT.
DATE 2-2-94
PAGE 4-00-003F
BY FRANCIS
VOID # 20638-0

ST. NAME CHG.

AVON CITY

W 1/2 S

SCALE 1" = 100'