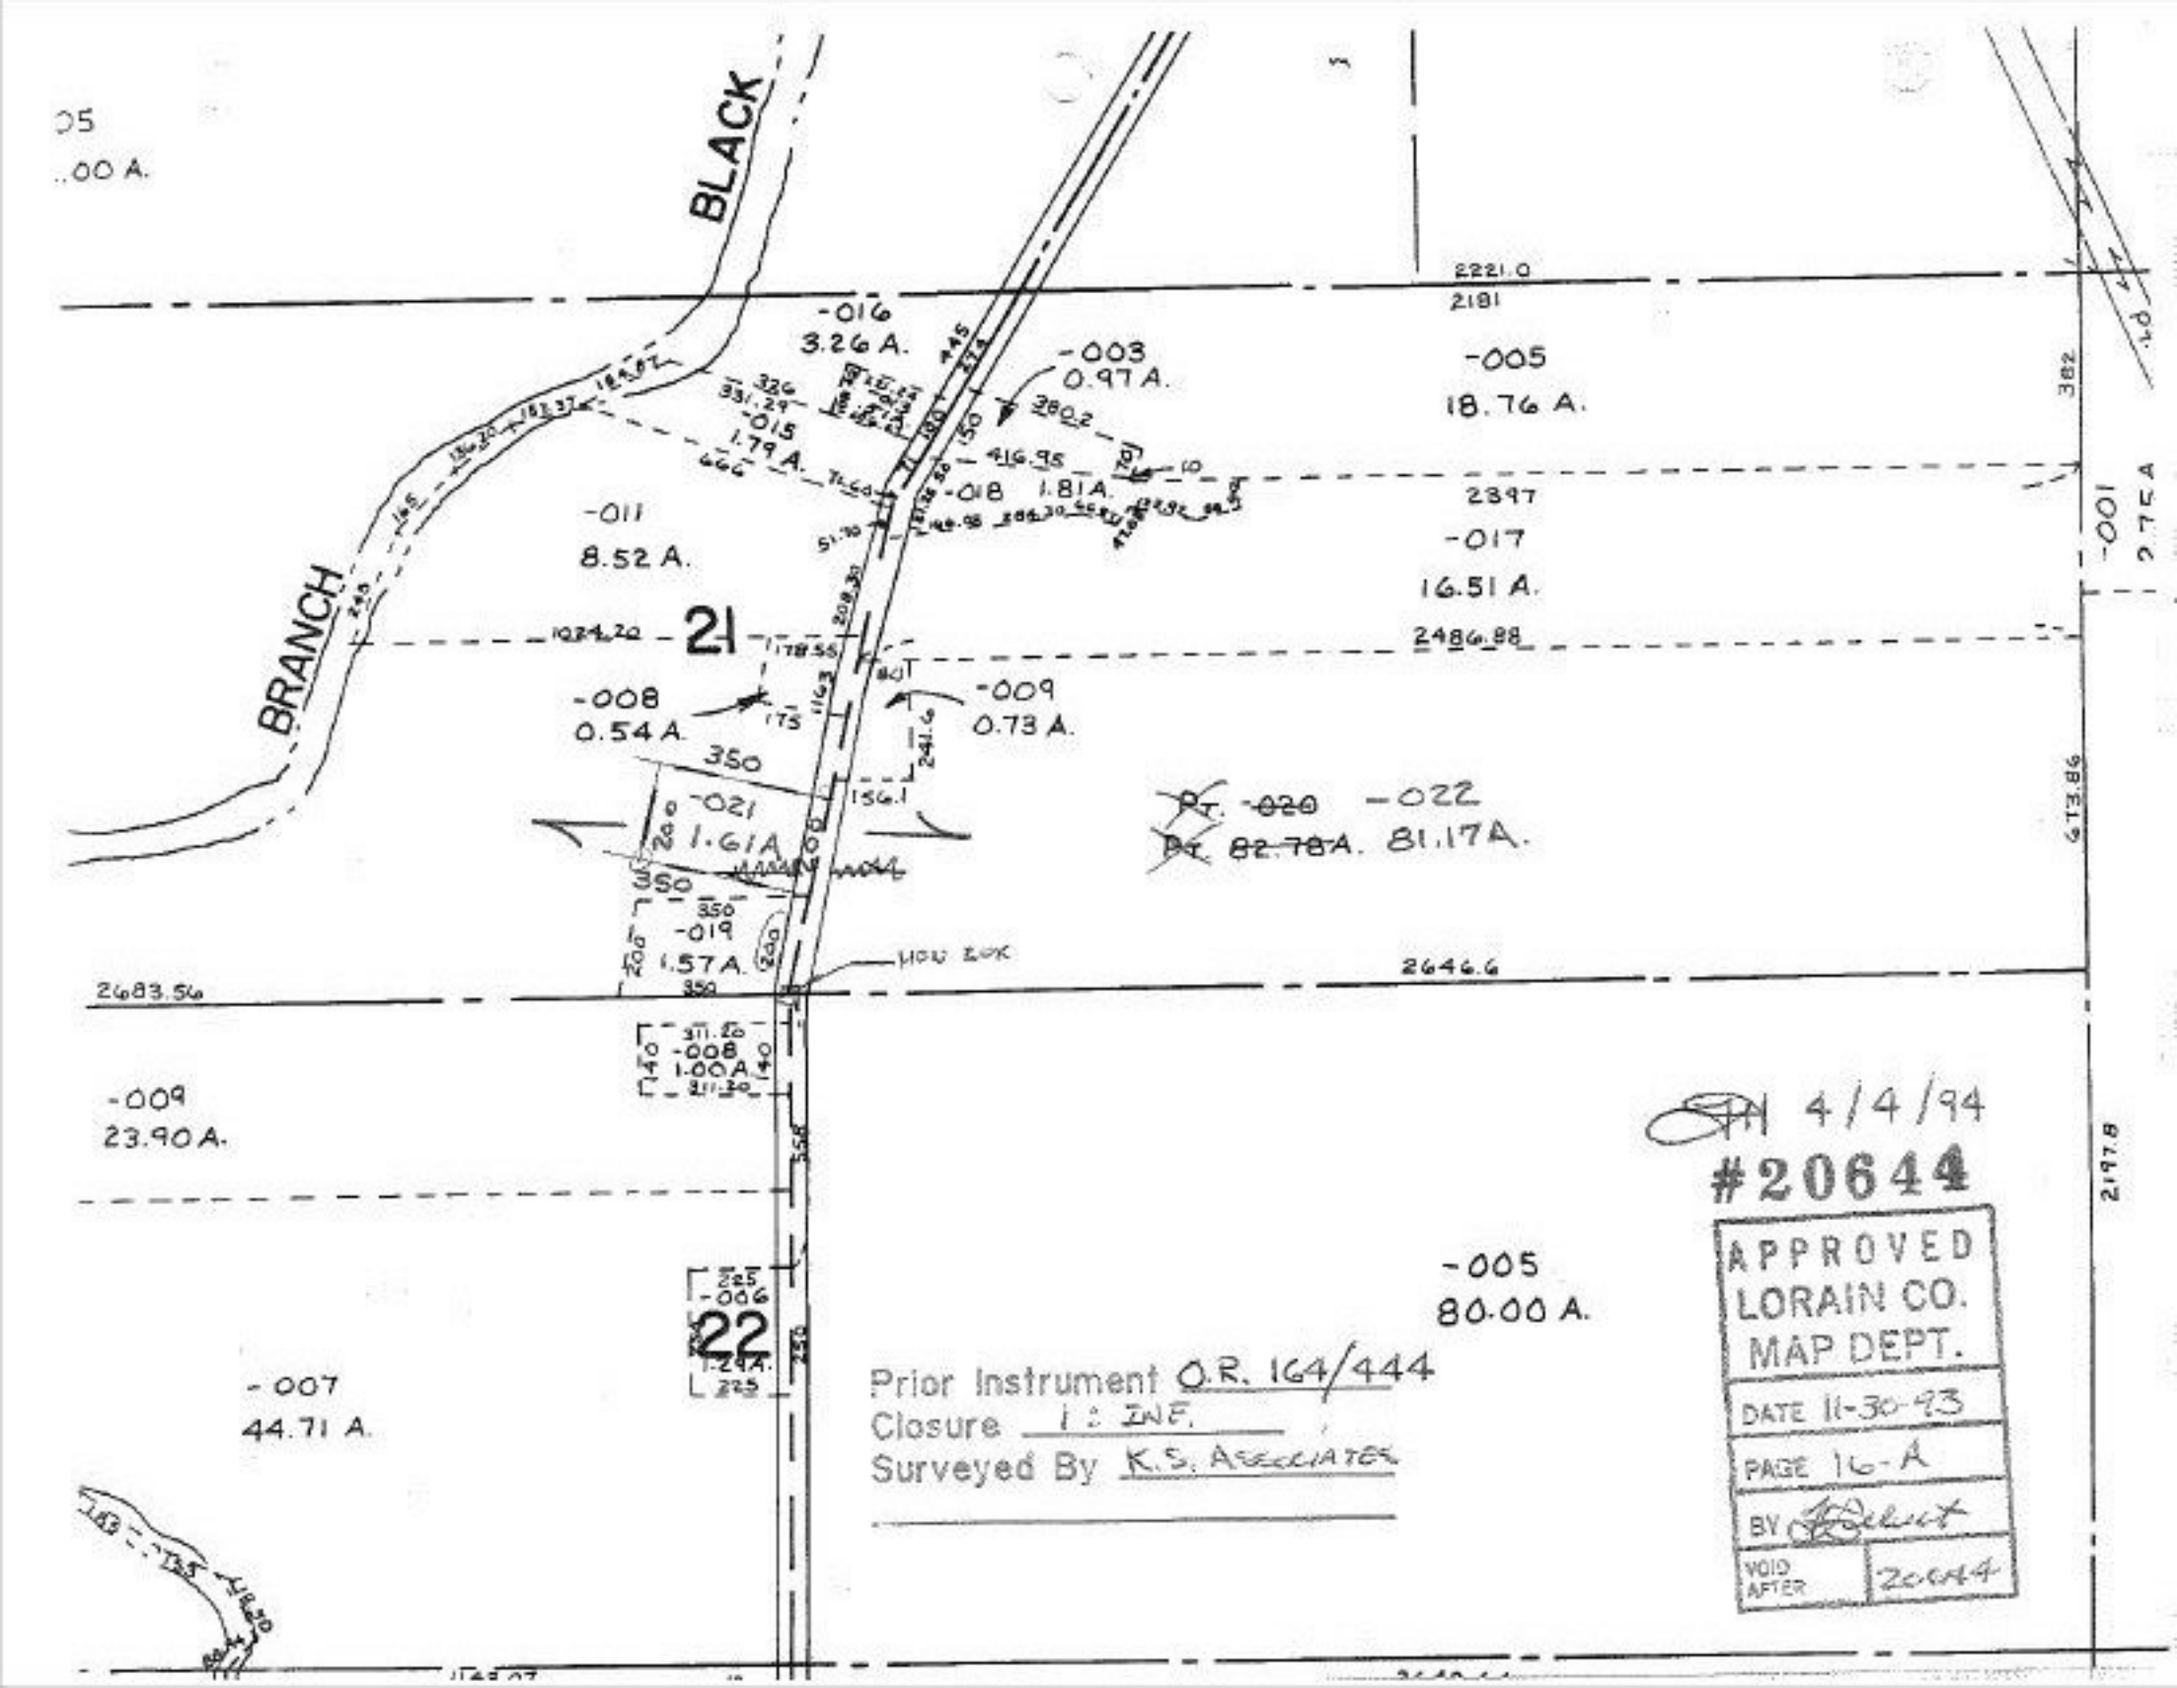


Prior Instrument O.R. 164/444
Closure 1 : INF.
Surveyed By K.S. ASSOCIATES