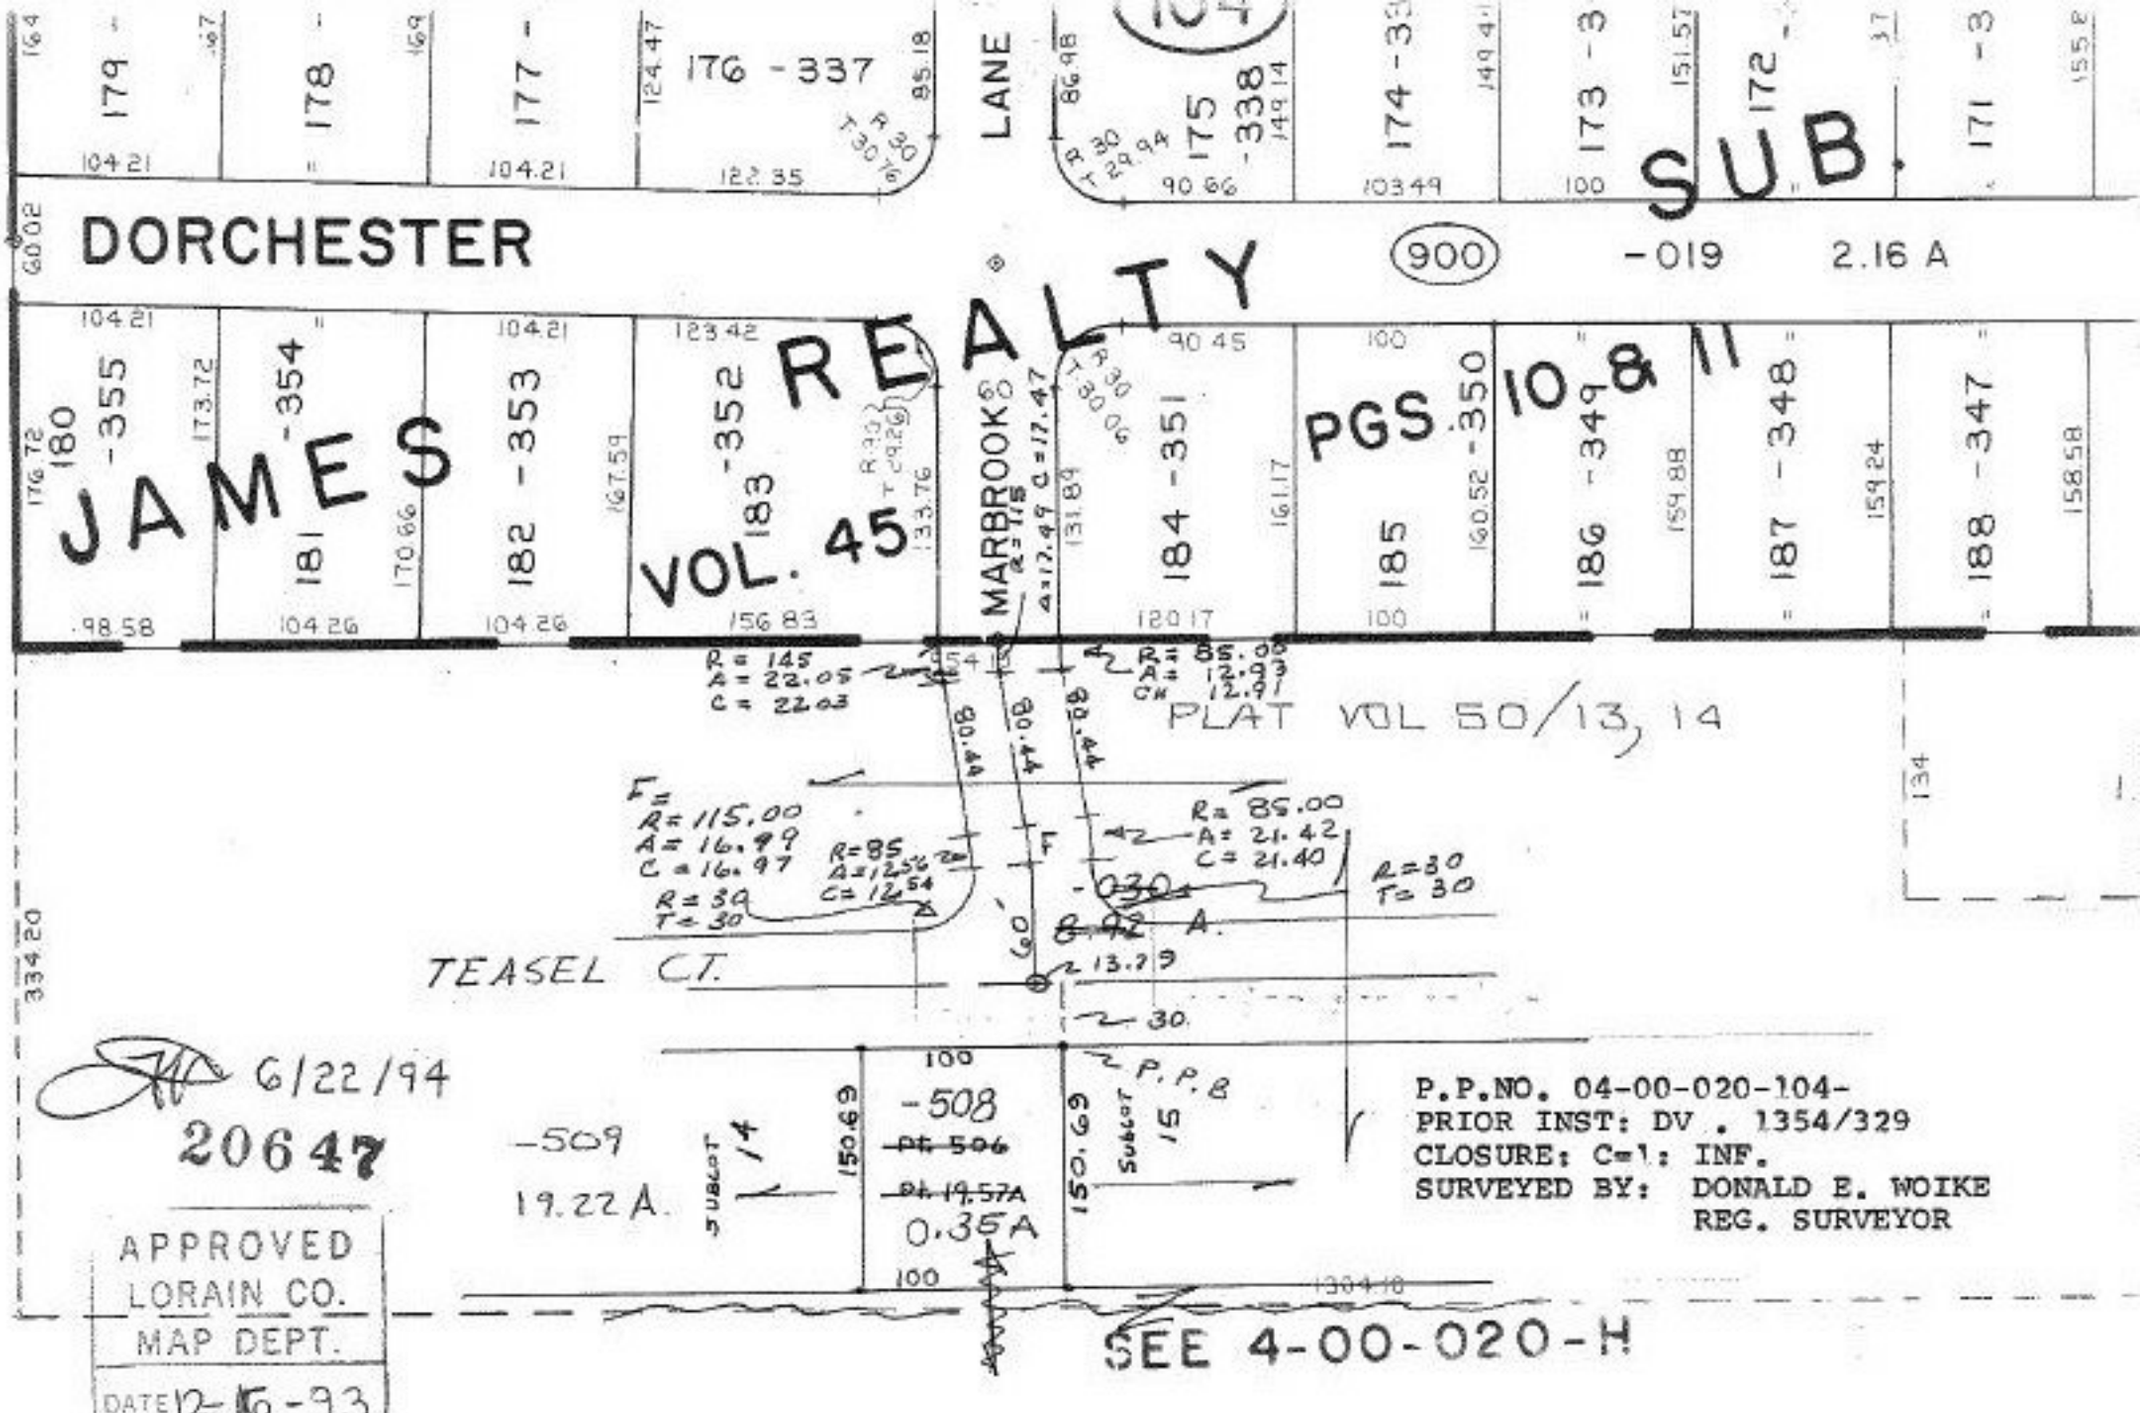


6/22/94

20647

APPROVED
LORAIN CO.
MAP DEPT.
DATE 12-16-93
PAGE 4-00-020 D
BY CAROLYN FRANCIS
VOID AFTER 20647

P.P.NO. 04-00-020-104-
PRIOR INST: DV . 1354/329
CLOSURE: C=1: INF.
SURVEYED BY: DONALD E. WOIKE
REG. SURVEYOR