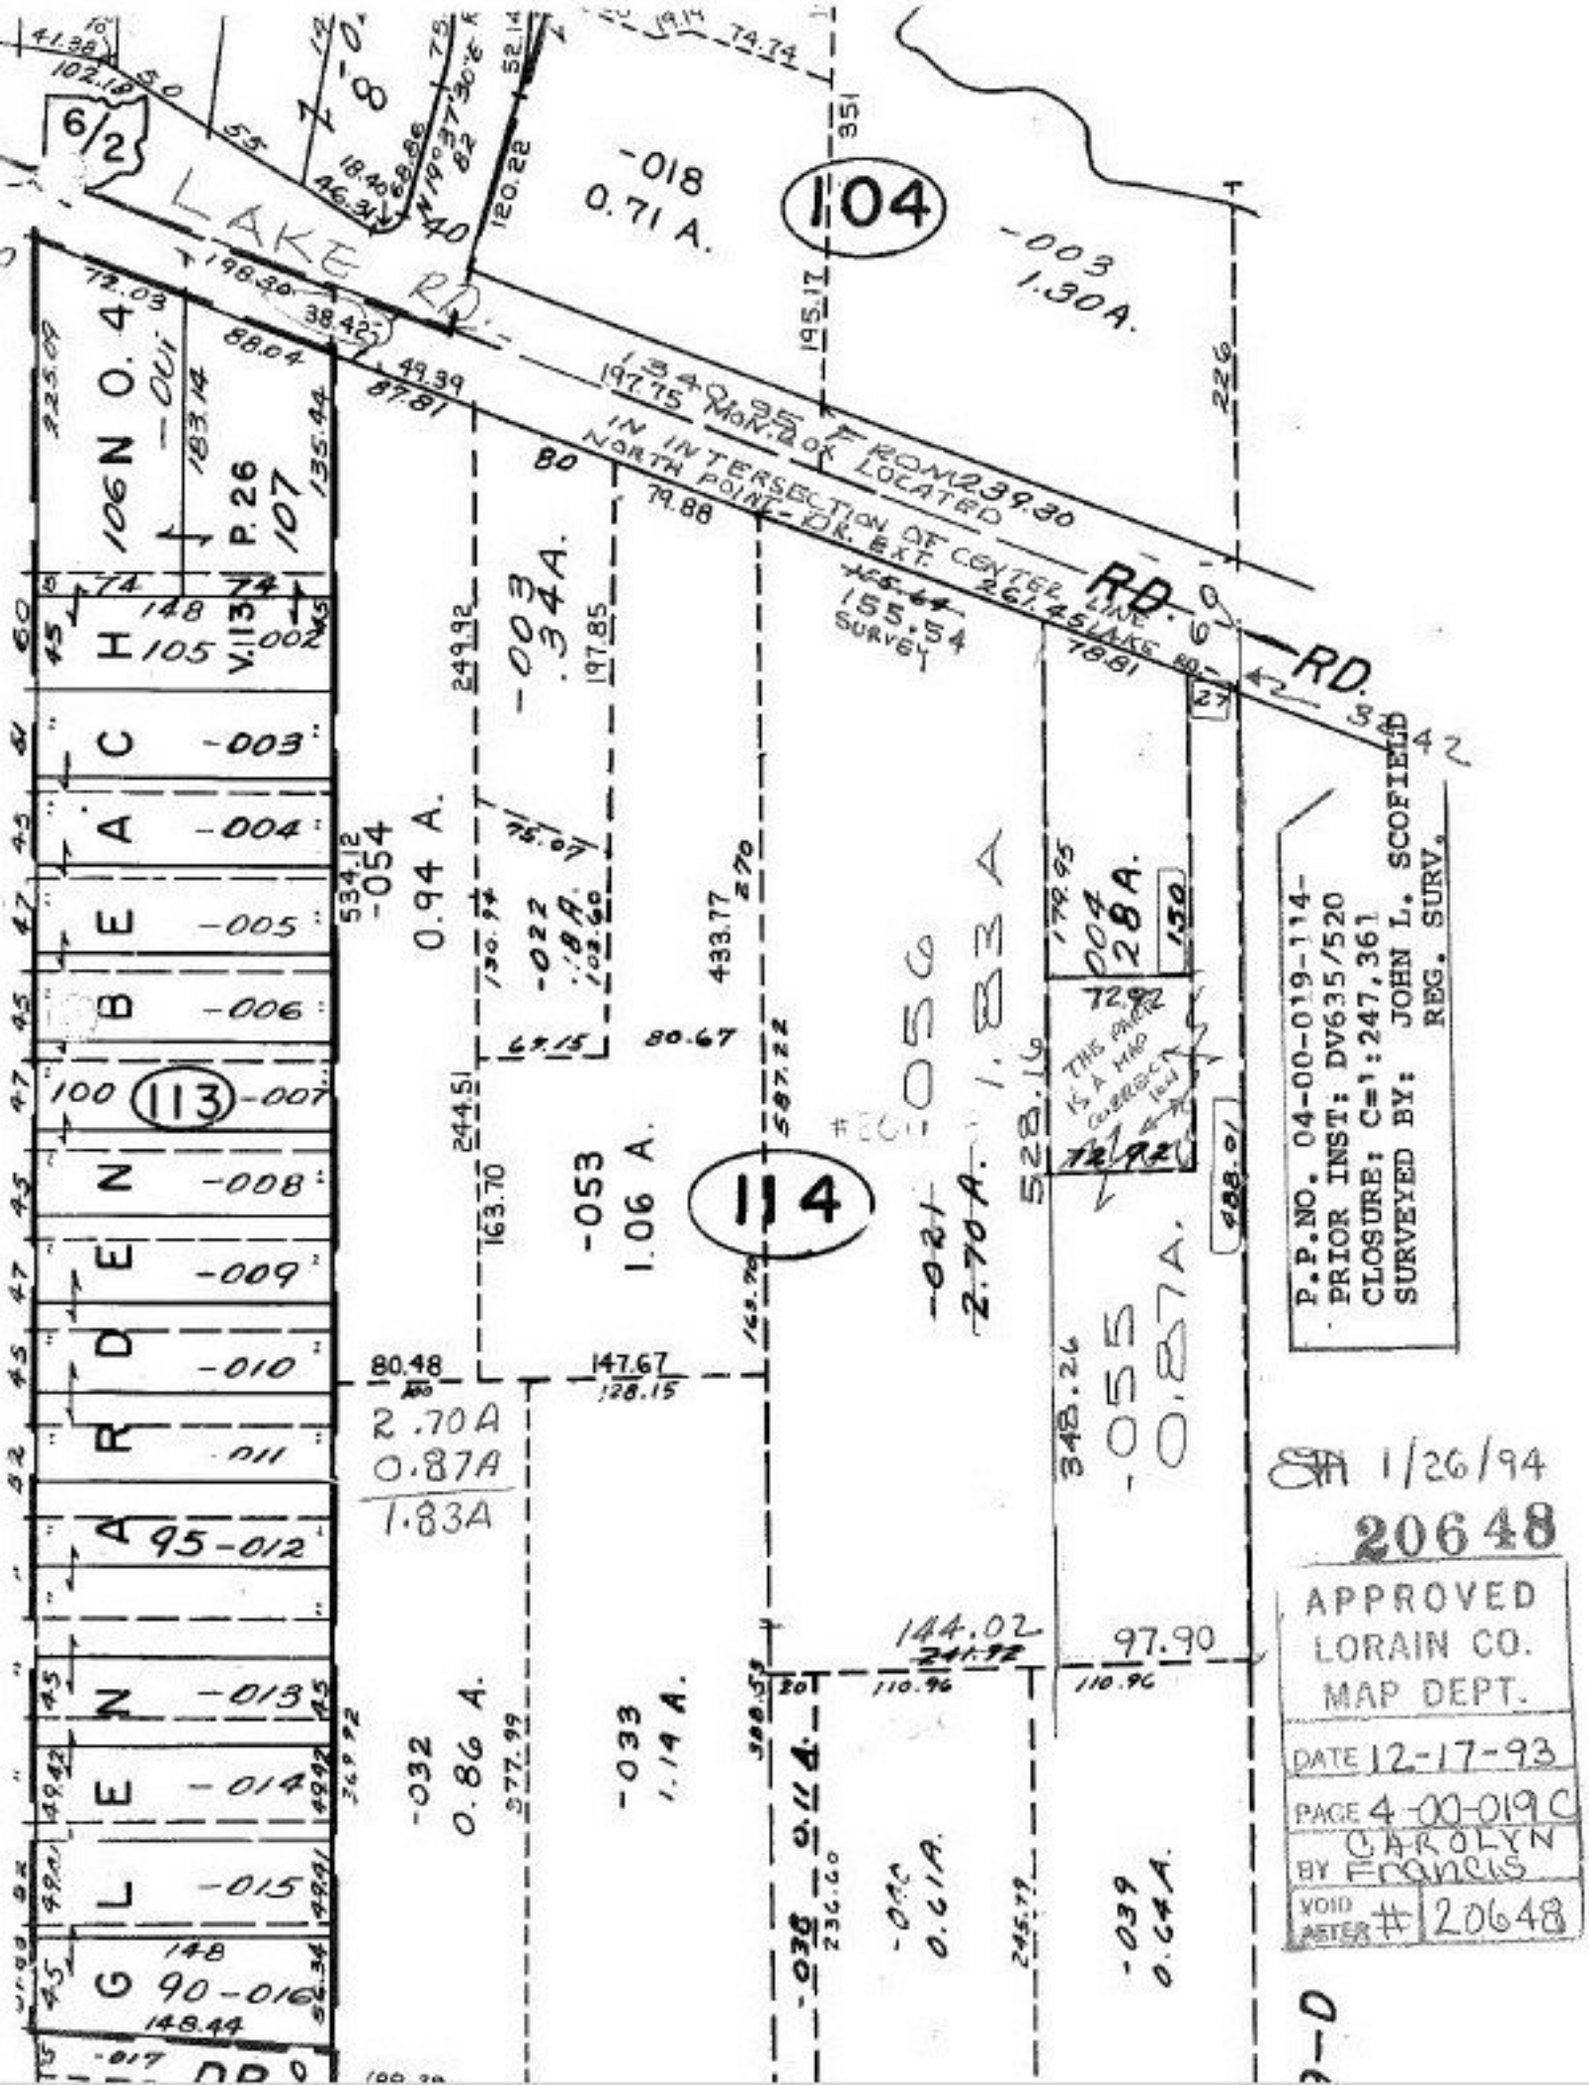

LAKE RD.
104
-018
0.71 A.
-003
1.30A.
1340.95 FROM 239.30
MON. BOX LOCATED
IN INTERSECTION OF CENTER LINE
NORTH POINT-DR. EXT.
261.45 LAKE RD.
RD.
RD.
155.54
SURVEY
-003
.34A.
-054
0.94 A.
-022
.18A.
-053
1.06 A.
114
-056
1.83A
-021
2.70 A.
-055
0.87A.
-004
28A.
THIS PART IS A MAP CORRECTION
2.70A
0.87A
1.83A
-032
0.86 A.
-033
1.14 A.
-038
0.11 A.
-040
0.61A.
-039
0.64A.
144.02
97.90
106 N O. 4
-OUI
P. 26
107
V.113
105
-002
-003
-004
-005
-006
100
113
-007
-008
-009
-010
-011
95-012
-013
-014
-015
90-016
148
148.44
-017
6/2
P.P.NO. 04-00-019-114-
PRIOR INST: DV635/520
CLOSURE: C=1:247,361
SURVEYED BY: JOHN L. SCOFIELD
REG. SURV.
1/26/94
20648
APPROVED
LORAIN CO.
MAP DEPT.
DATE 12-17-93
PAGE 4-00-019C
BY CAROLYN Francis
VOID AFTER # 20648