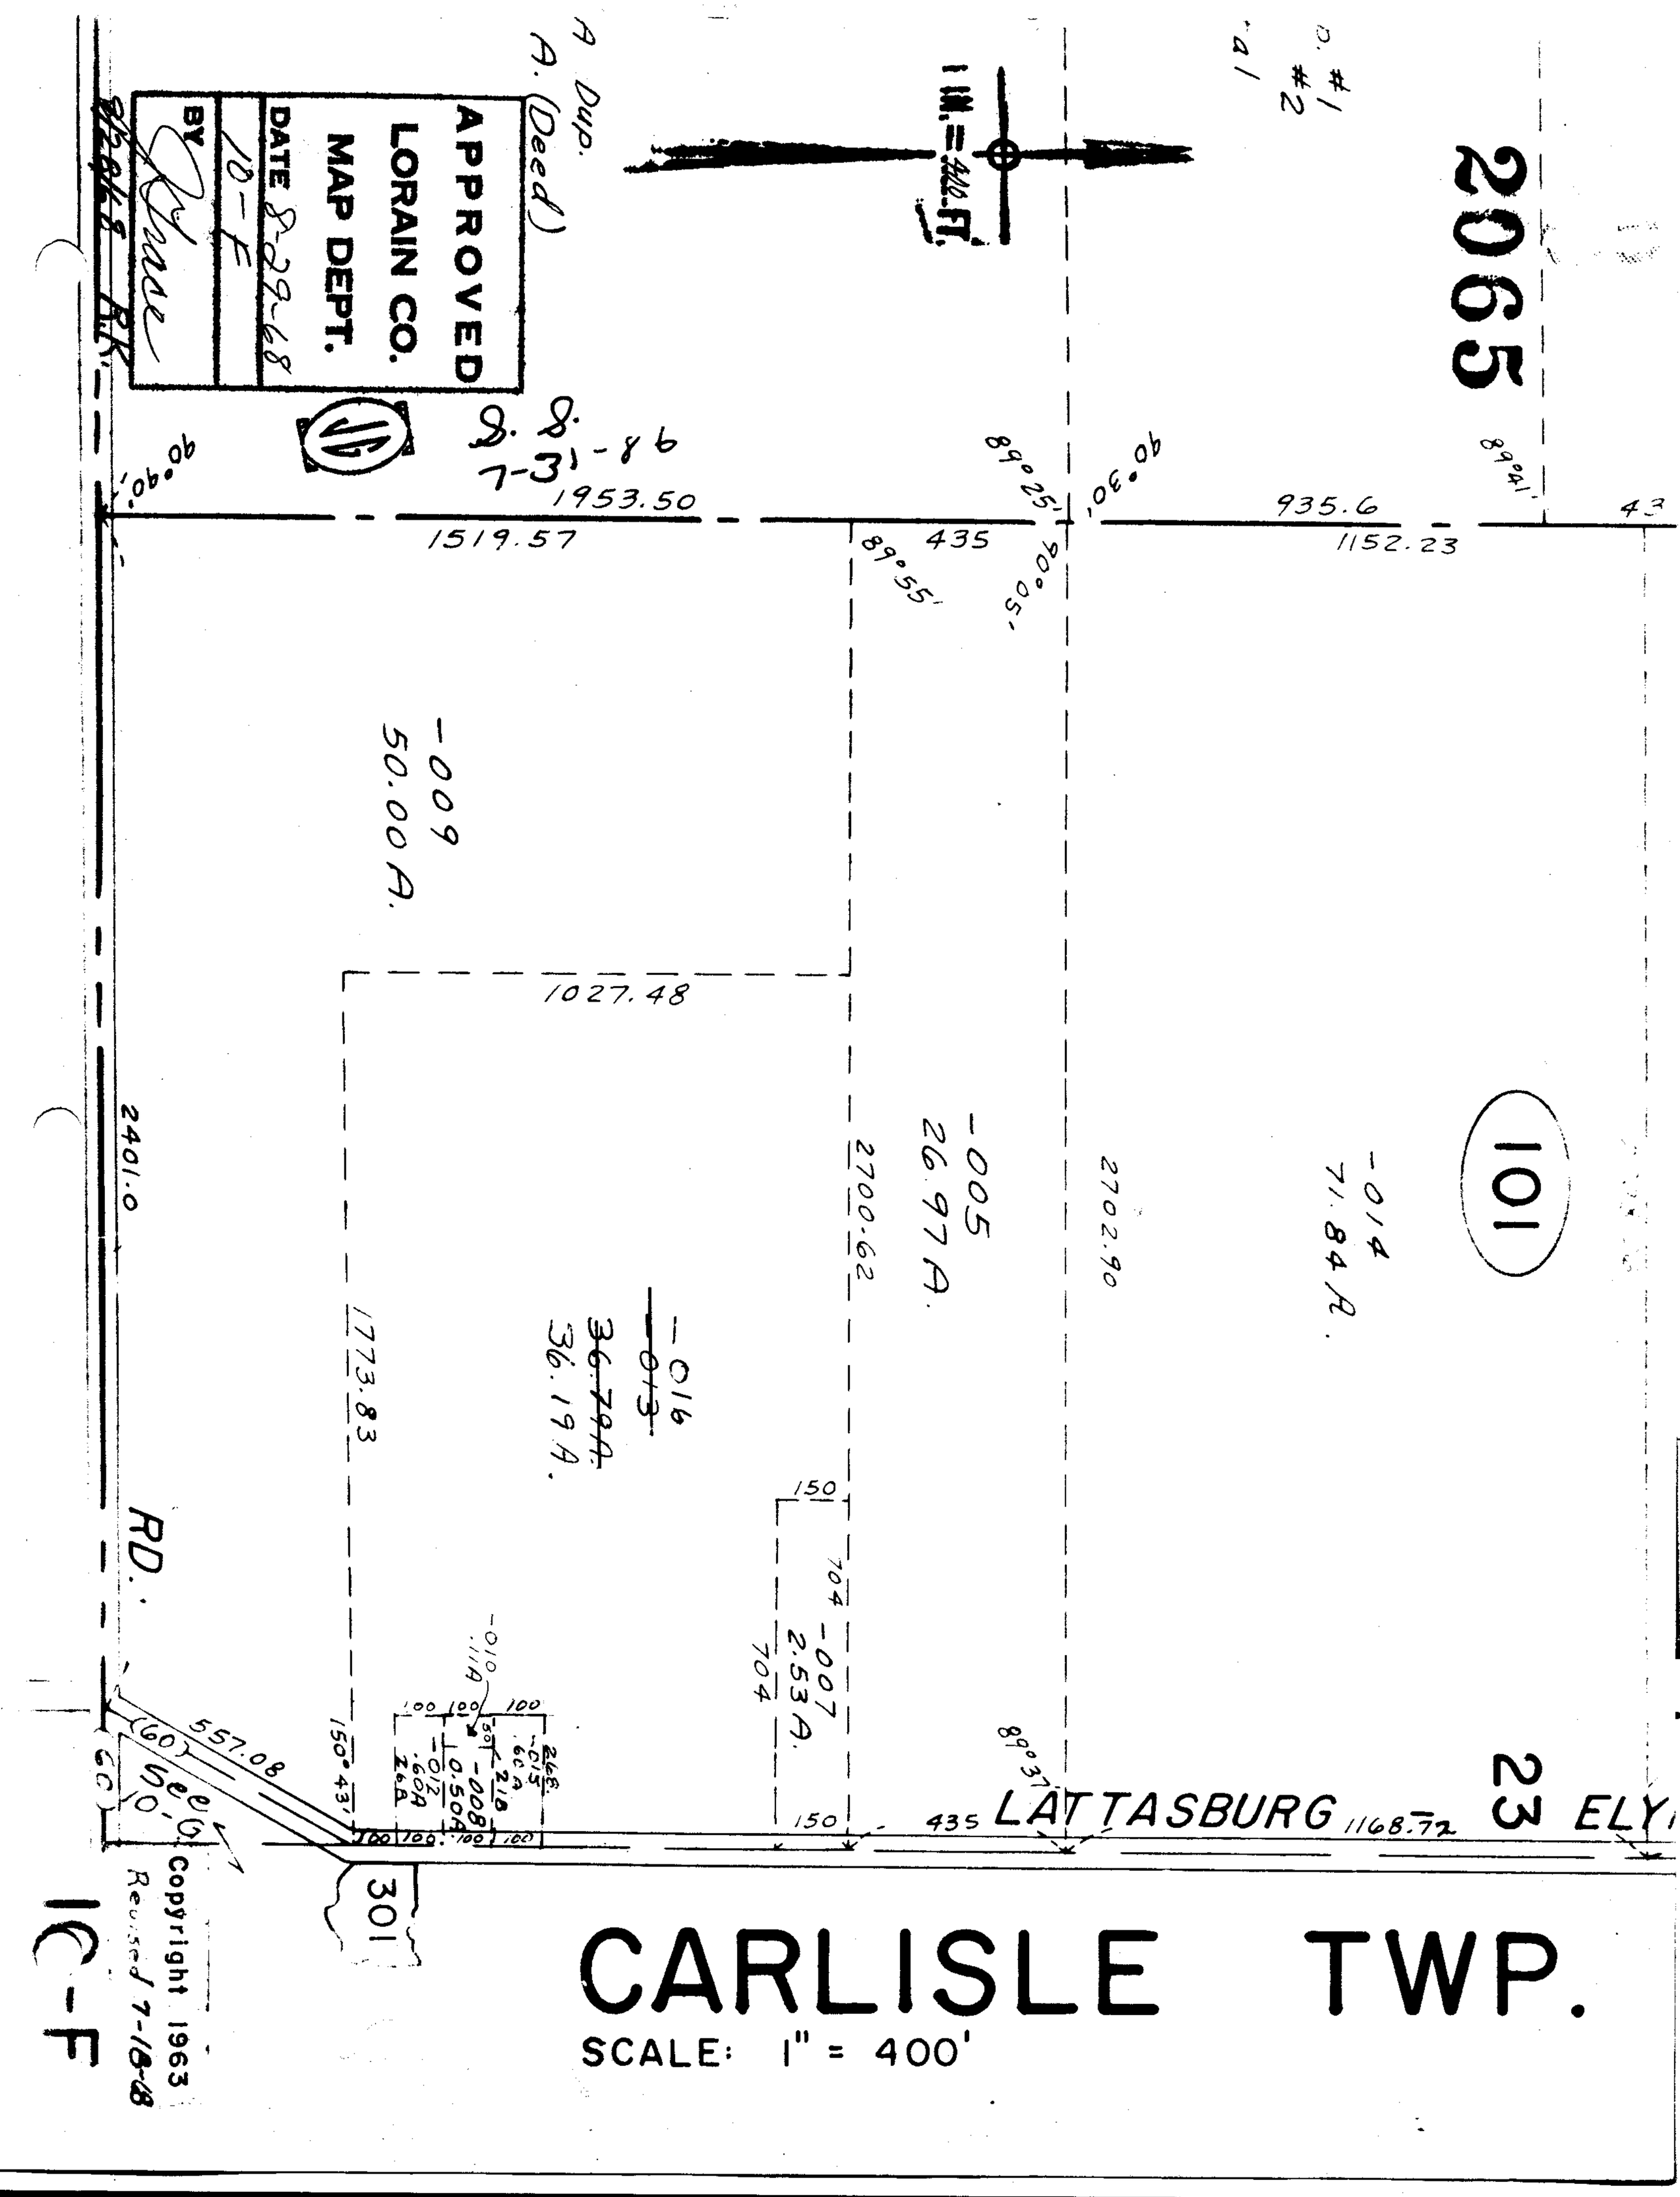

CARLISLE TWP.

SCALE: 1" = 400'

Copyright 1963
Revised 7-18-68

10-F