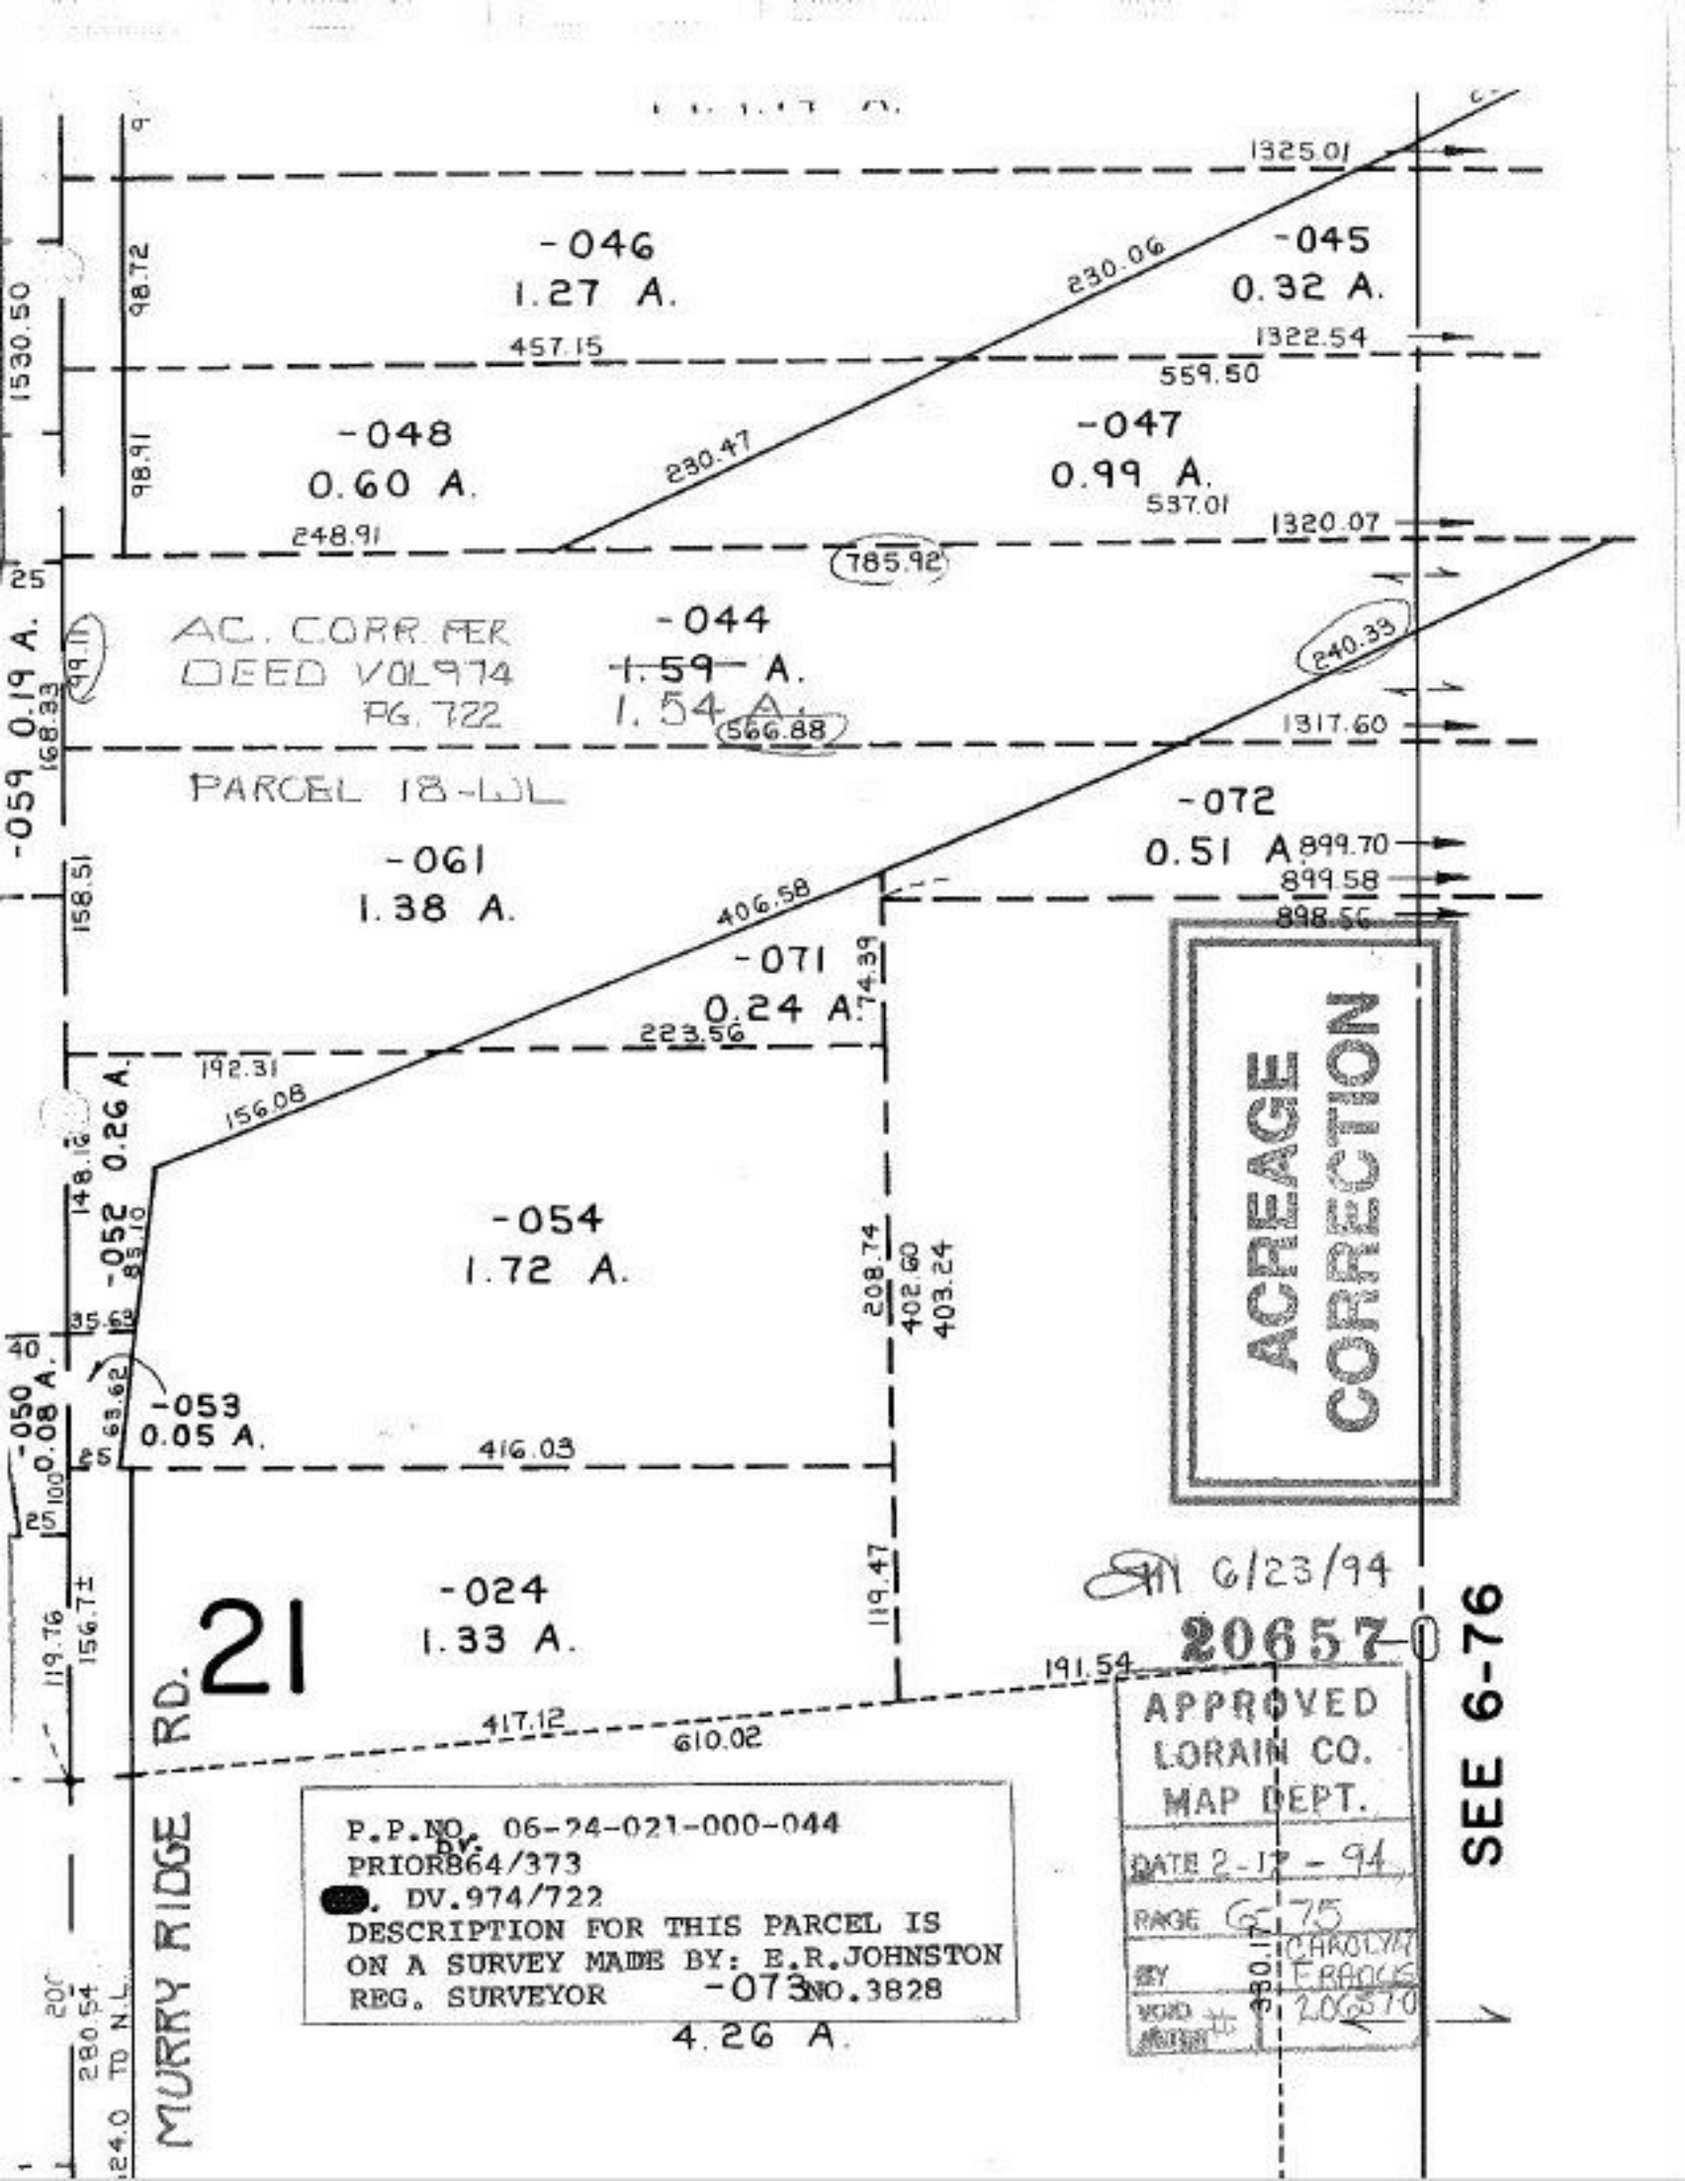
1325.01
-046
1.27 A.
-045
0.32 A.
230.06
1322.54
457.15
559.50
-048
0.60 A.
-047
0.99 A.
230.47
537.01
1320.07
248.91
785.92
AC. CORR. PER
DEED VOL 974
PG. 722
-044
1.59 A.
1.54 A.
566.88
240.33
1317.60
PARCEL 18-LOL
-059 0.19 A.
-061
1.38 A.
-072
0.51 A.
899.70
899.58
898.56
406.58
-071
0.24 A.
74.39
223.56
192.31
156.08
-052 0.26 A.
-054
1.72 A.
208.74
402.60
403.24
-050 0.08 A.
-053
0.05 A.
416.03
119.47
-024
1.33 A.
191.54
417.12
610.02
MURRY RIDGE RD.
21
4.26 A.
ACREAGE CORRECTION
SEE 6-76
6/23/94
20657-0
APPROVED
LORAIN CO.
MAP DEPT.
DATE 2-17-94
PAGE 6-75
BY CAROLYN ERBACK
VOID AFFIDAVIT # 20670
P.P.NO. 06-24-021-000-044
PRIOR 864/373
DV. 974/722
DESCRIPTION FOR THIS PARCEL IS
ON A SURVEY MADE BY: E.R.JOHNSTON
REG. SURVEYOR NO. 3828
-073