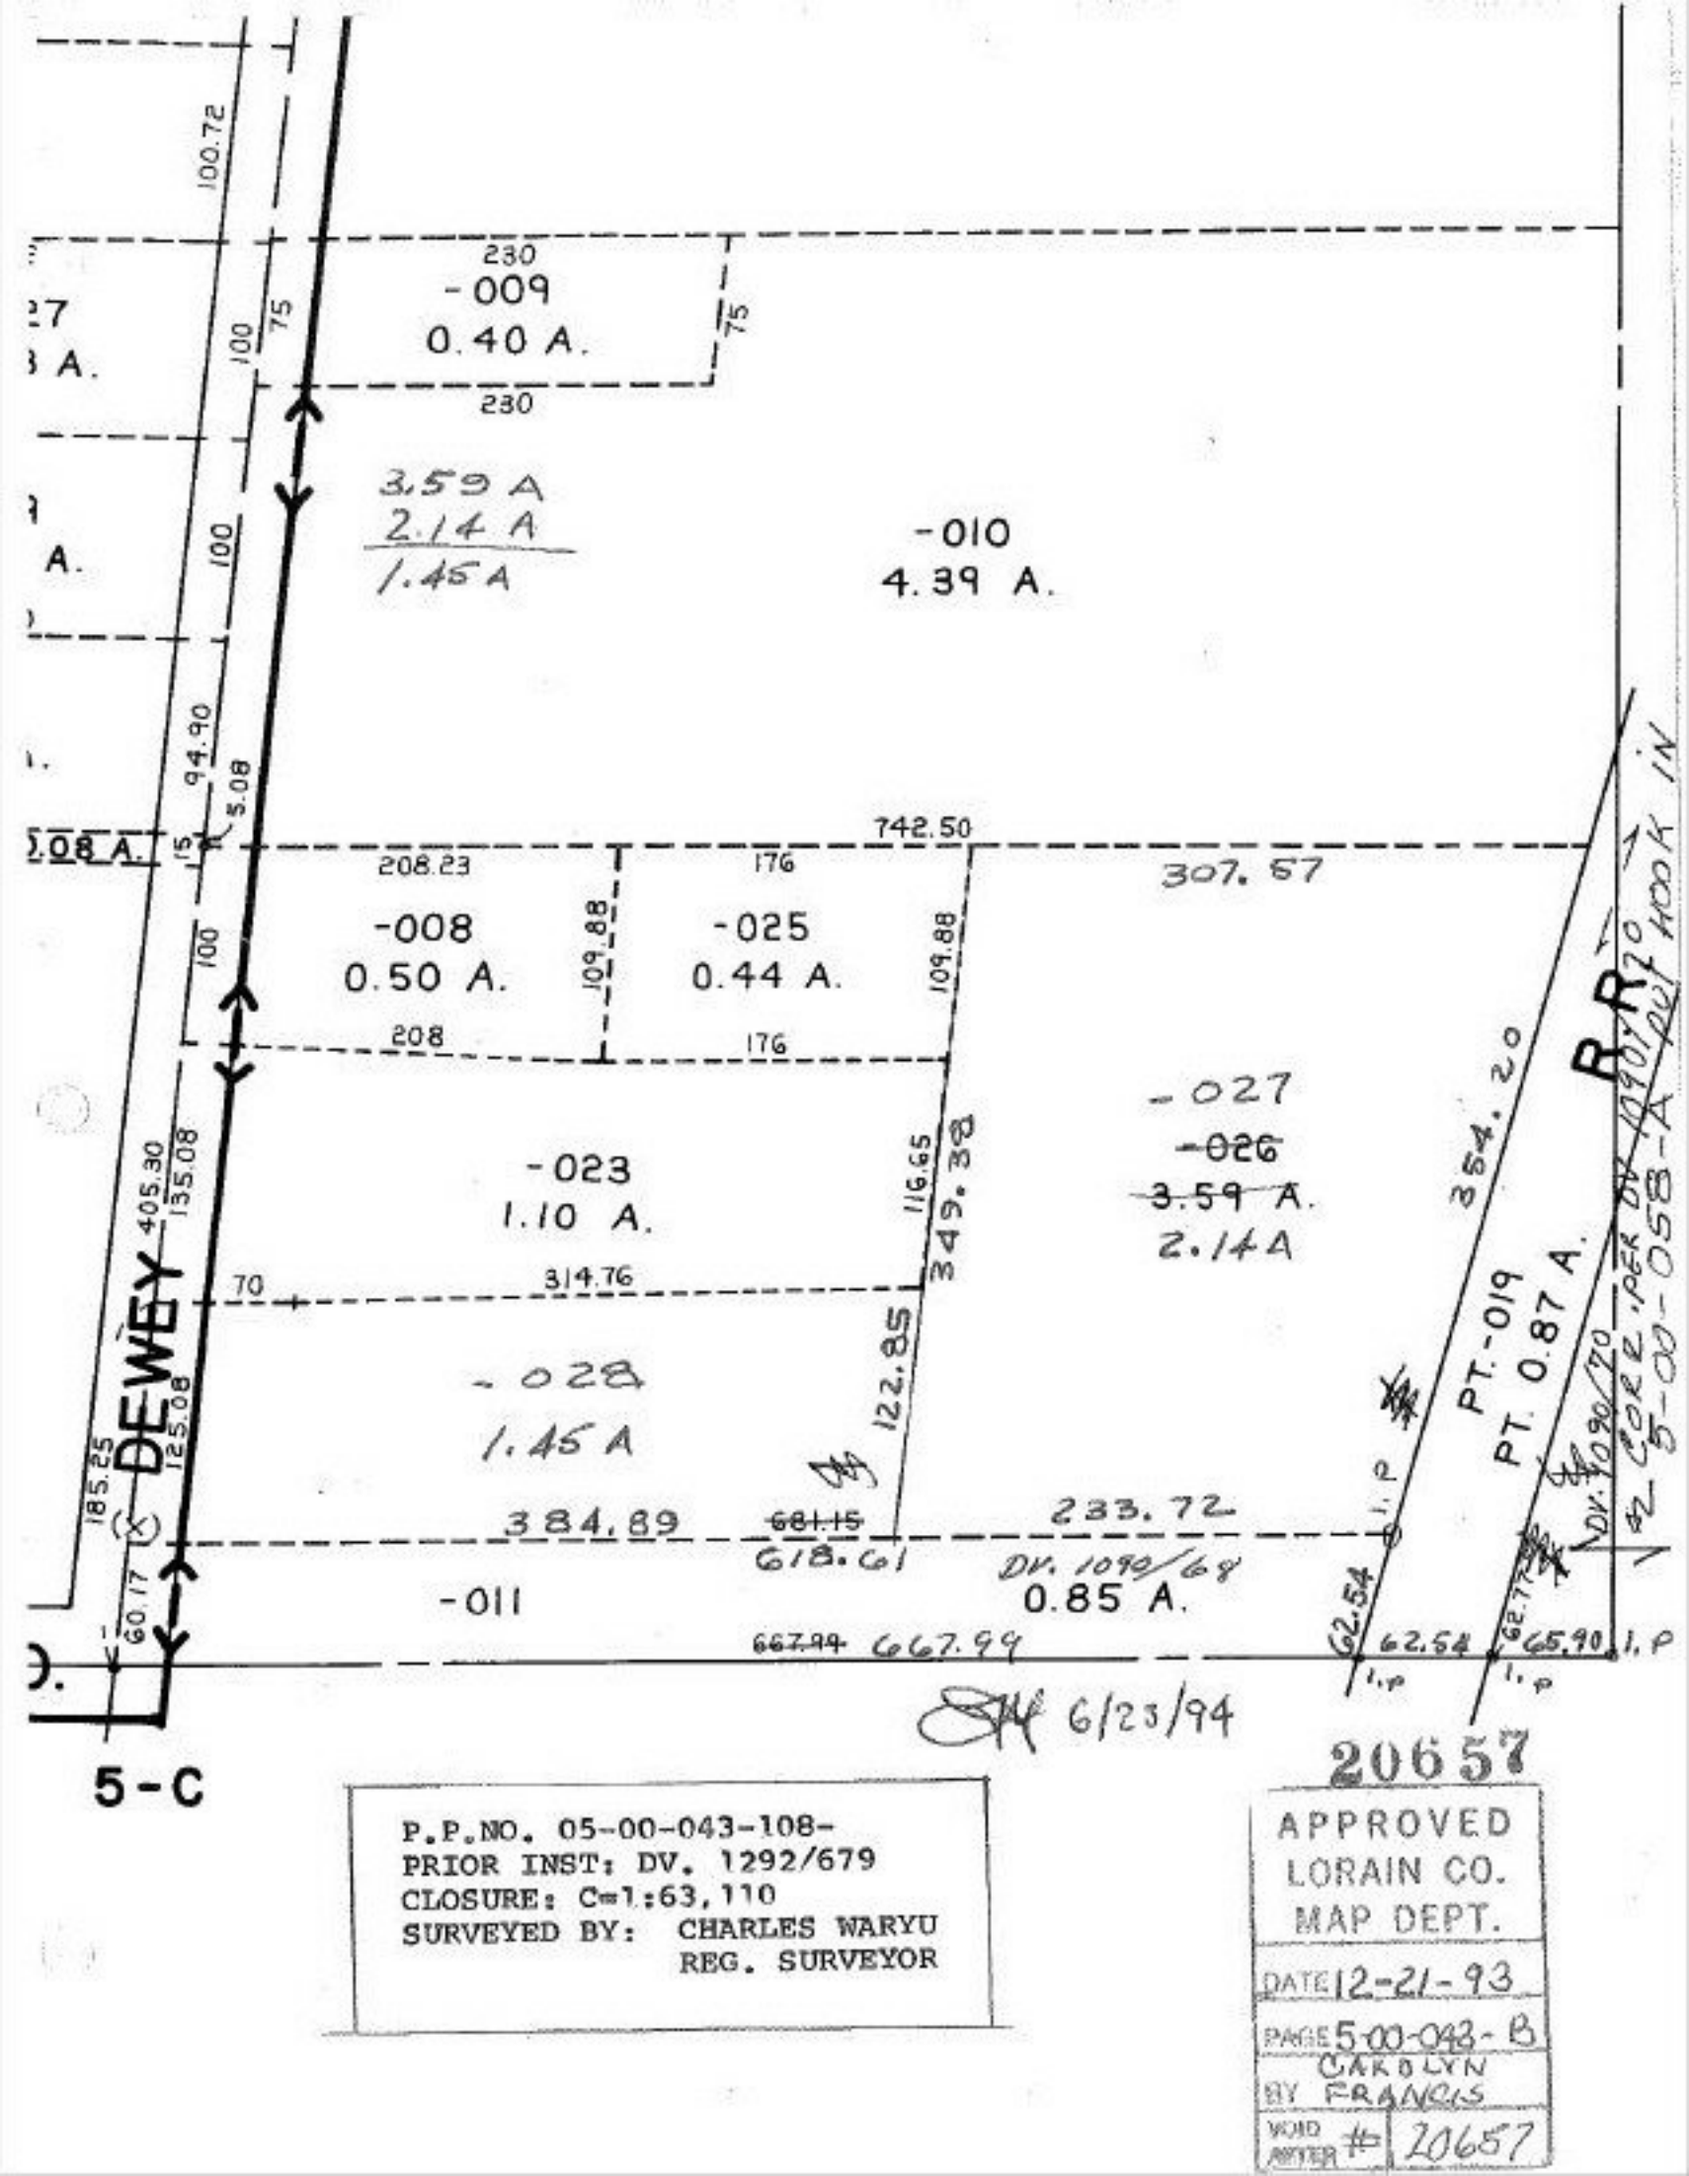

P.P.NO. 05-00-043-108-
PRIOR INST: DV. 1292/679
CLOSURE: C=1:63,110
SURVEYED BY: CHARLES WARYU
REG. SURVEYOR

20657

APPROVED
LORAIN CO.
MAP DEPT.

DATE 12-21-93

PAGE 5-00-043-B

BY CAROLYN FRANCIS

VOID AFTER # 20657