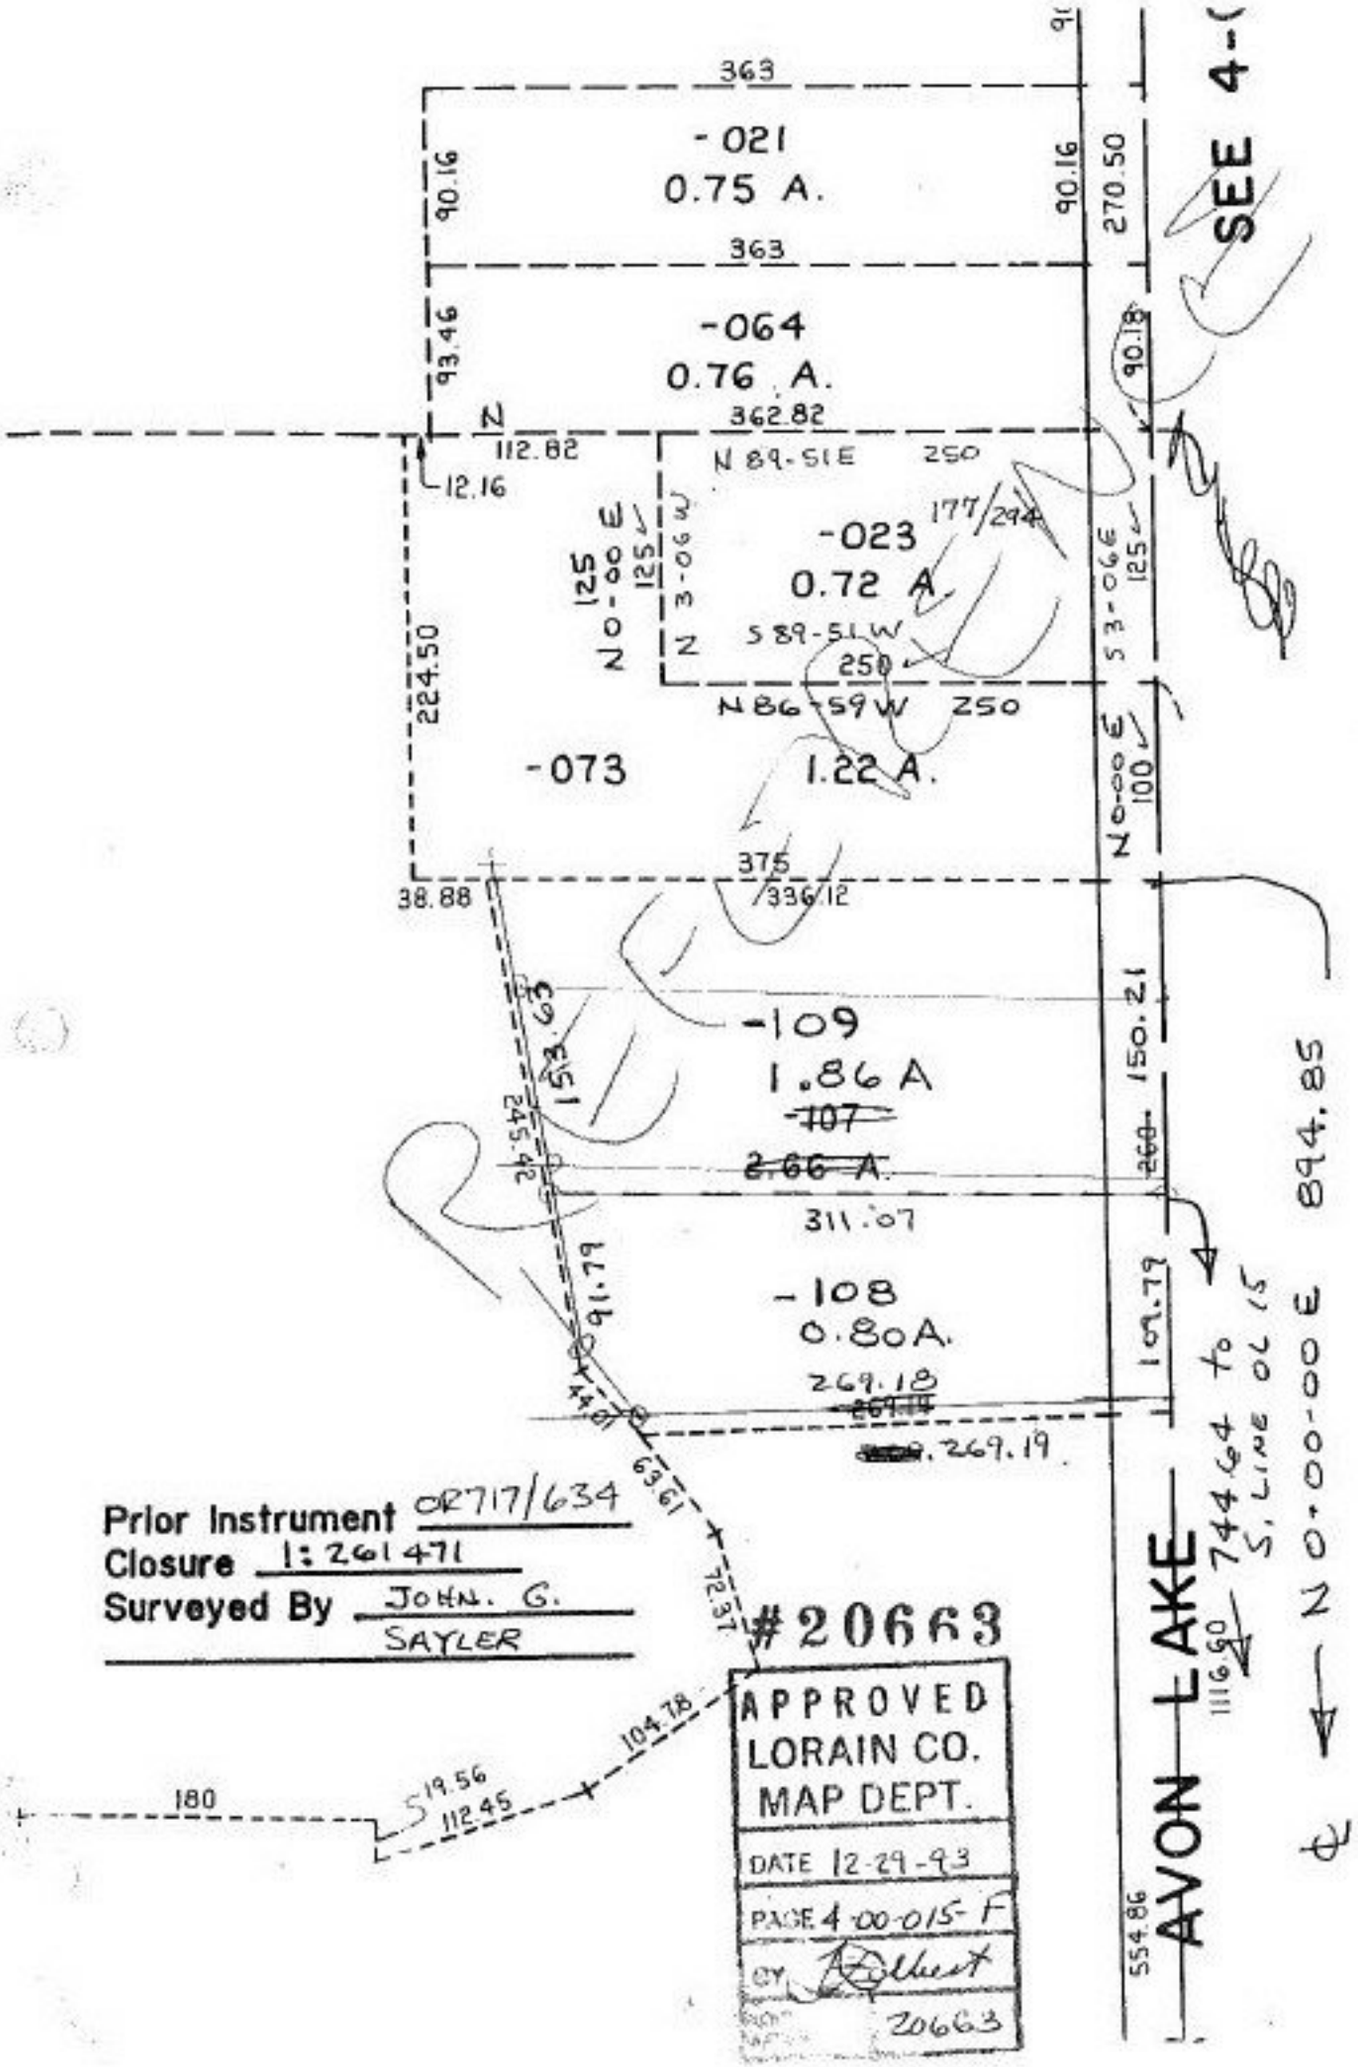
363
-021
0.75 A.
90.16
90.16
270.50
363
-064
0.76 A.
93.46
90.18
N
112.82
362.82
N 89-51E 250
12.16
-023
0.72 A
177/294
N 3-06W 125
N 0-00E 125
S 3-06E 125
S 89-51W 250
N 86-59W 250
224.50
-073
1.22 A.
N 0-00E 100
375
336.12
38.88
-109
1.86 A
~~107~~
~~2.66 A.~~
150.21
~~260~~
245.42
311.07
-108
0.80A.
109.79
269.18
~~269.18~~
269.19
91.79
63.61
72.37
104.78
180
S 19.56
112.45
Prior Instrument OR717/634
Closure 1:261471
Surveyed By JOHN. G. SAYLER
#20663
APPROVED
LORAIN CO.
MAP DEPT.
DATE 12-29-93
PAGE 4-00-015-F
BY
20663
554.86
AVON LAKE
1116.60
744.64 to
S. LINE OF
N 0-00-00 E 894.85
SEE 4-(