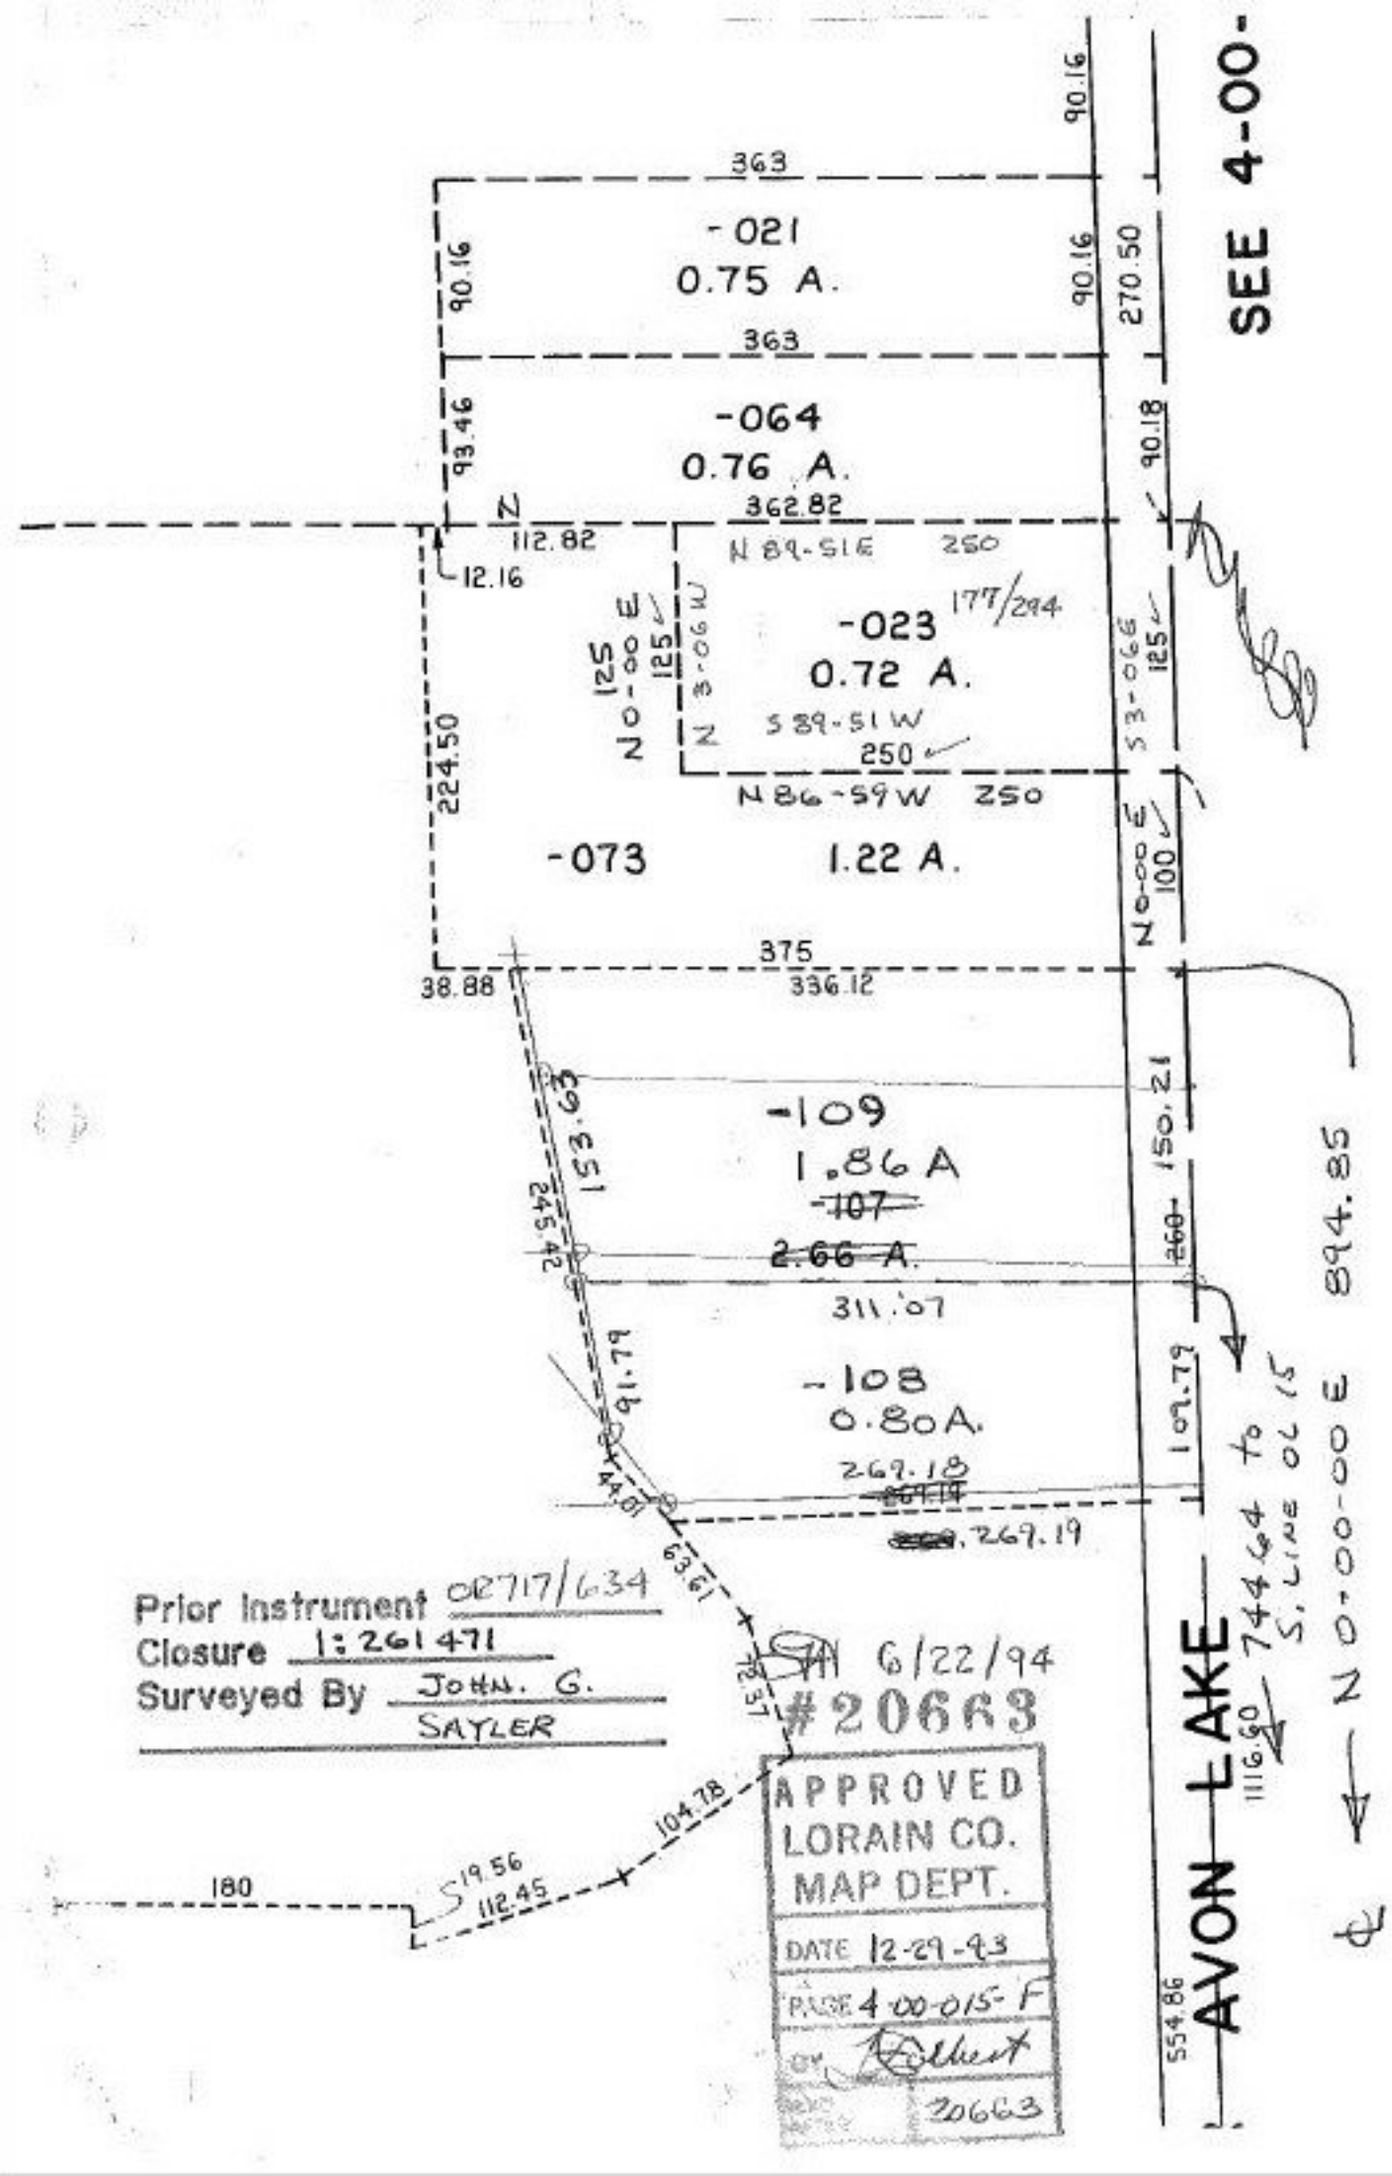
SEE 4-00-
90.16
363
-021
0.75 A.
90.16
90.16
270.50
363
93.46
-064
0.76 A.
90.18
N
112.82
362.82
N 89-51E 250
12.16
-023
0.72 A.
177/294
N 0-00 E 125
N 3-06 W 125
S 3-06 E 125
S 89-51 W 250
224.50
N 86-59 W 250
-073
1.22 A.
N 0-00 E 100
375
38.88
336.12
-109
1.86 A
-107
2.66 A.
153.63
245.42
150.21
260
311.07
-108
0.80A.
91.79
269.18
269.19
109.79
63.61
42.57
104.78
180
S 19.56
112.45
N 0-00-00 E 894.85
744.64 to
S. Line of
1116.60
554.86
AVON LAKE
Prior Instrument 02717/634
Closure 1:261471
Surveyed By JOHN. G. SAYLER
6/22/94
#20663
APPROVED
LORAIN CO.
MAP DEPT.
DATE 12-29-93
PAGE 4-00-015-F
BY
20663