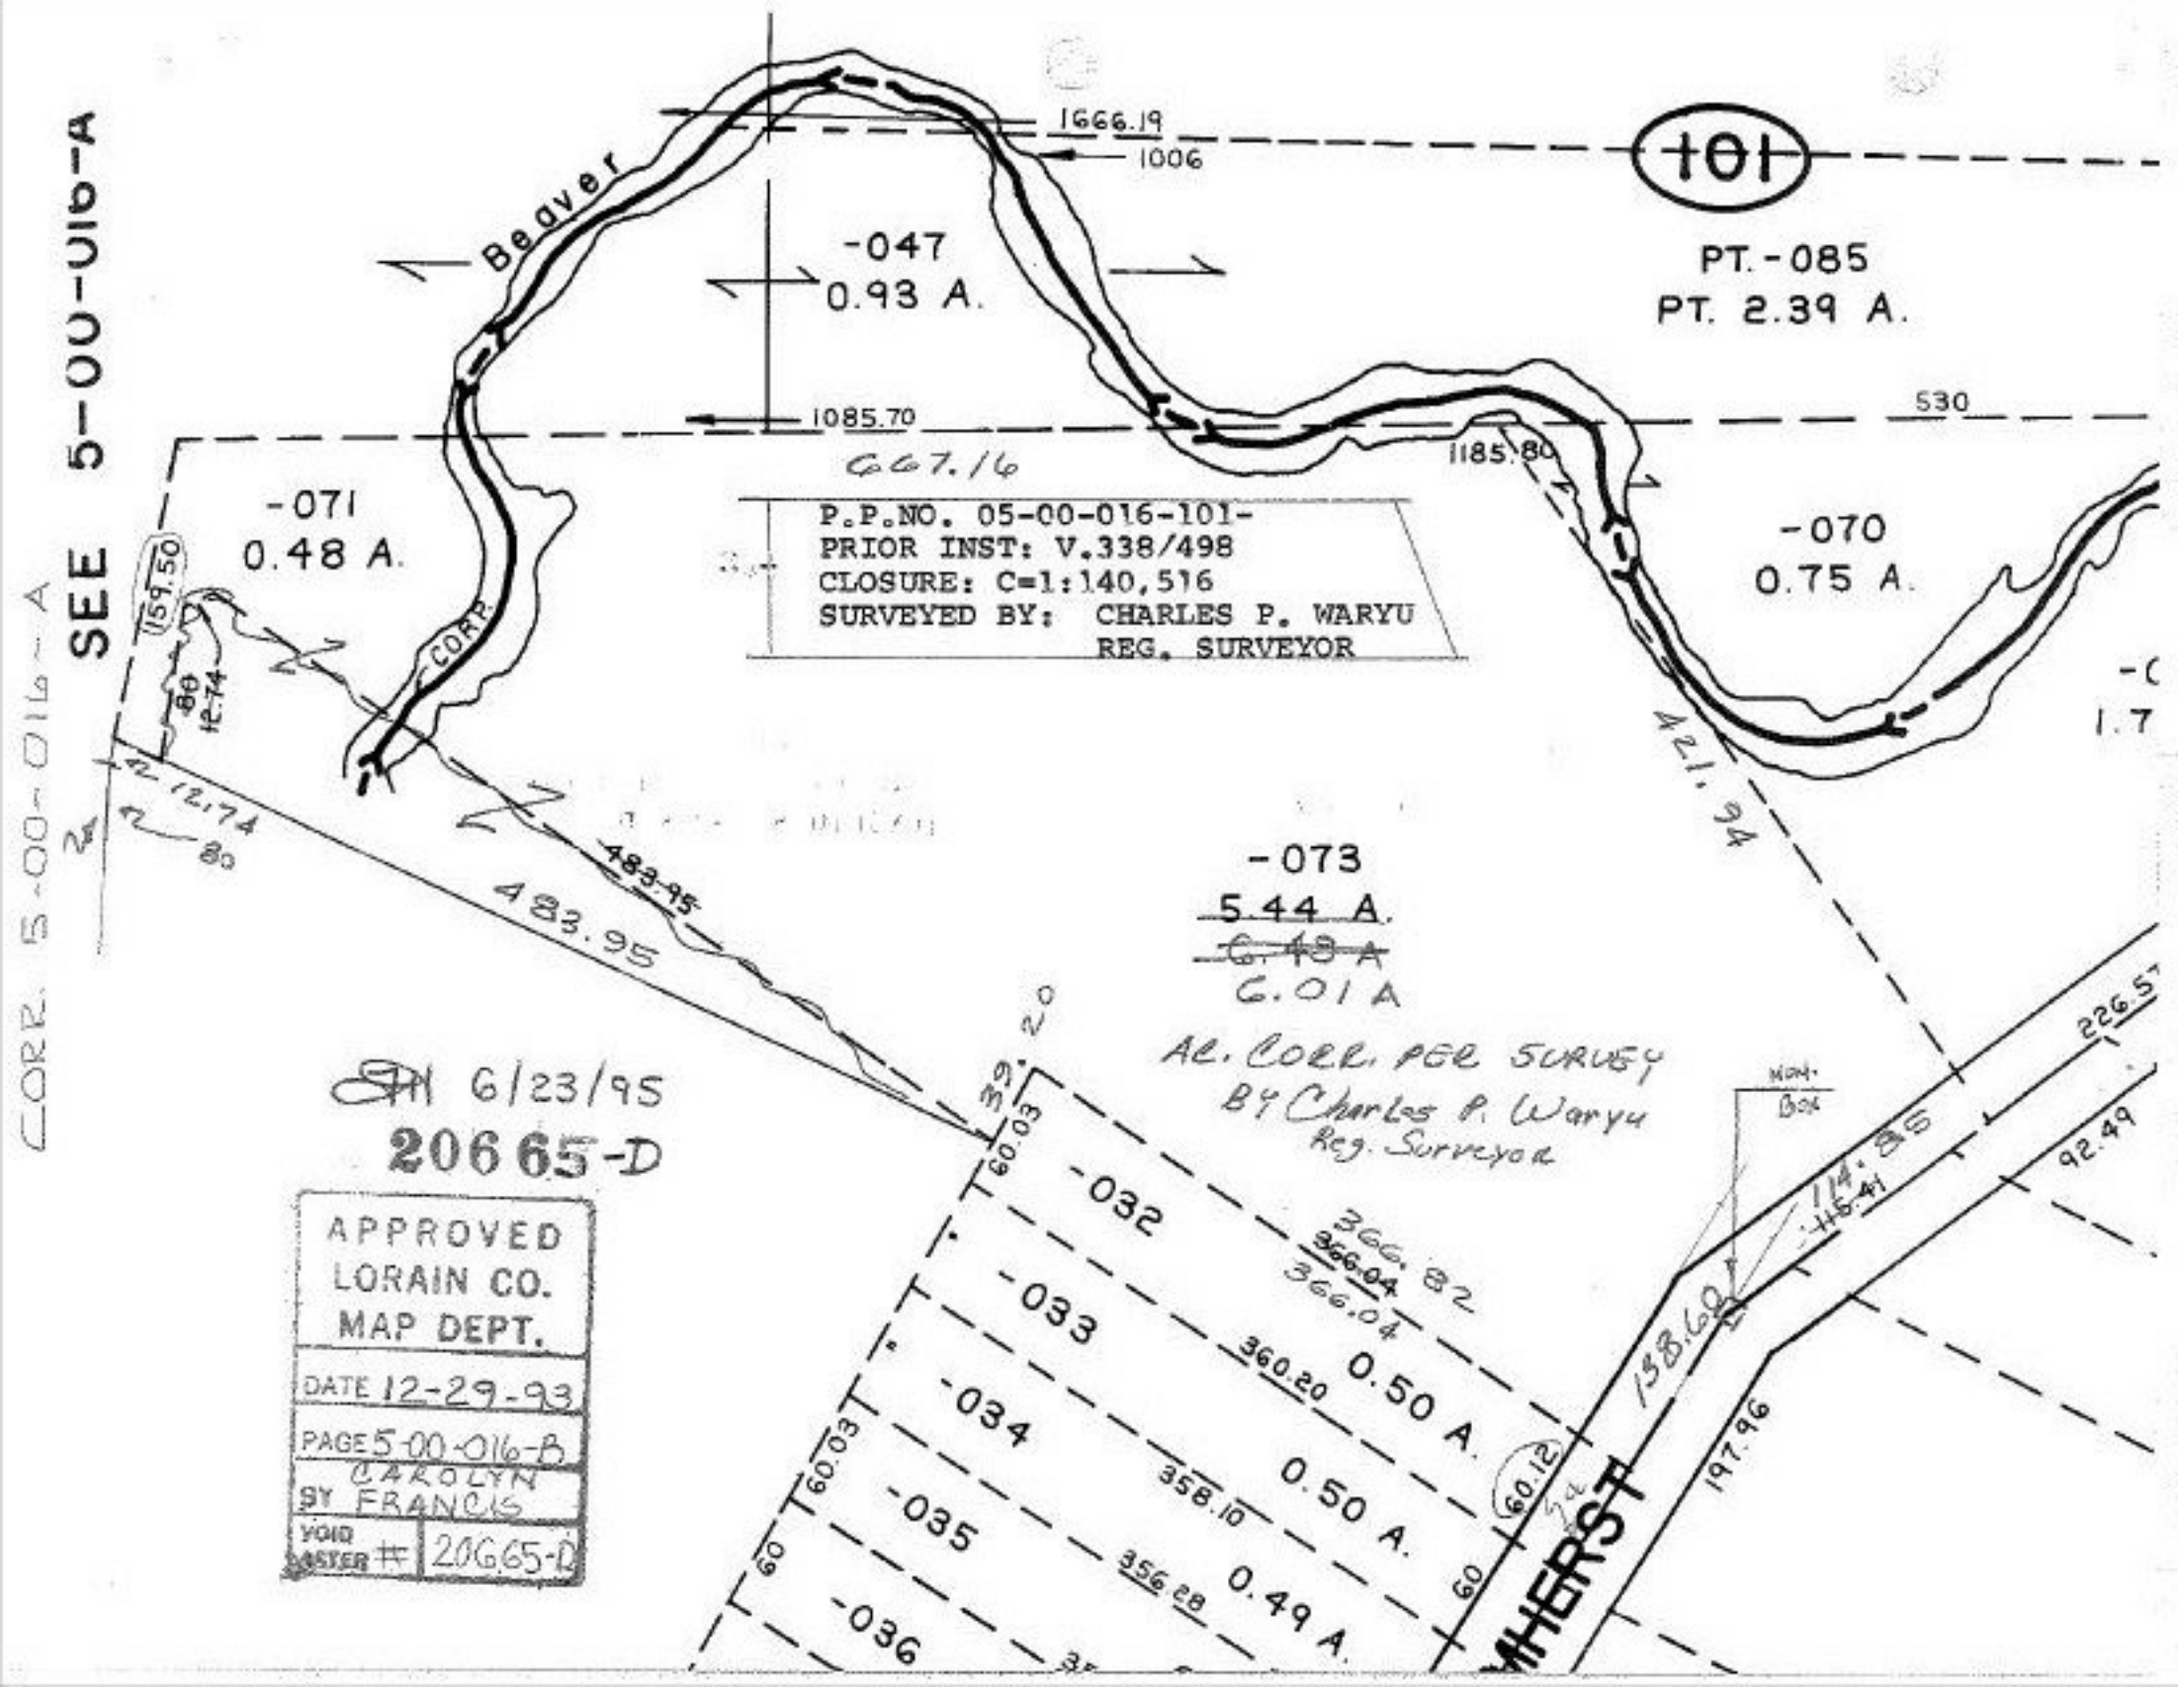
SEE 5-00-016-A
CORR. 5-00-016-A
Beaver
1666.19
1006
101
-047
0.93 A.
PT. -085
PT. 2.39 A.
1085.70
530
667.16
1185.80
-071
0.48 A.
-070
0.75 A.
P.P.NO. 05-00-016-101-
PRIOR INST: V.338/498
CLOSURE: C=1:140,516
SURVEYED BY: CHARLES P. WARYU
REG. SURVEYOR
159.50
80
12.74
CORR.
N 12.74
80
483.95
421.94
-073
5.44 A.
6.43 A.
6.01 A
Ac. corr. per survey
By Charles P. Waryu
Reg. Surveyor
39.20
60.03
-032
366.82
366.04
0.50 A.
-033
360.20
-034
358.10
0.50 A.
-035
356.28
0.49 A.
-036
60
60.12
54
HERST
138.60
114.85
116.41
197.96
226.57
92.49
MON. BOX
6/23/95
20665-D
APPROVED
LORAIN CO.
MAP DEPT.
DATE 12-29-93
PAGE 5-00-016-B
BY CAROLYN FRANCIS
VOID MASTER # 20665-D