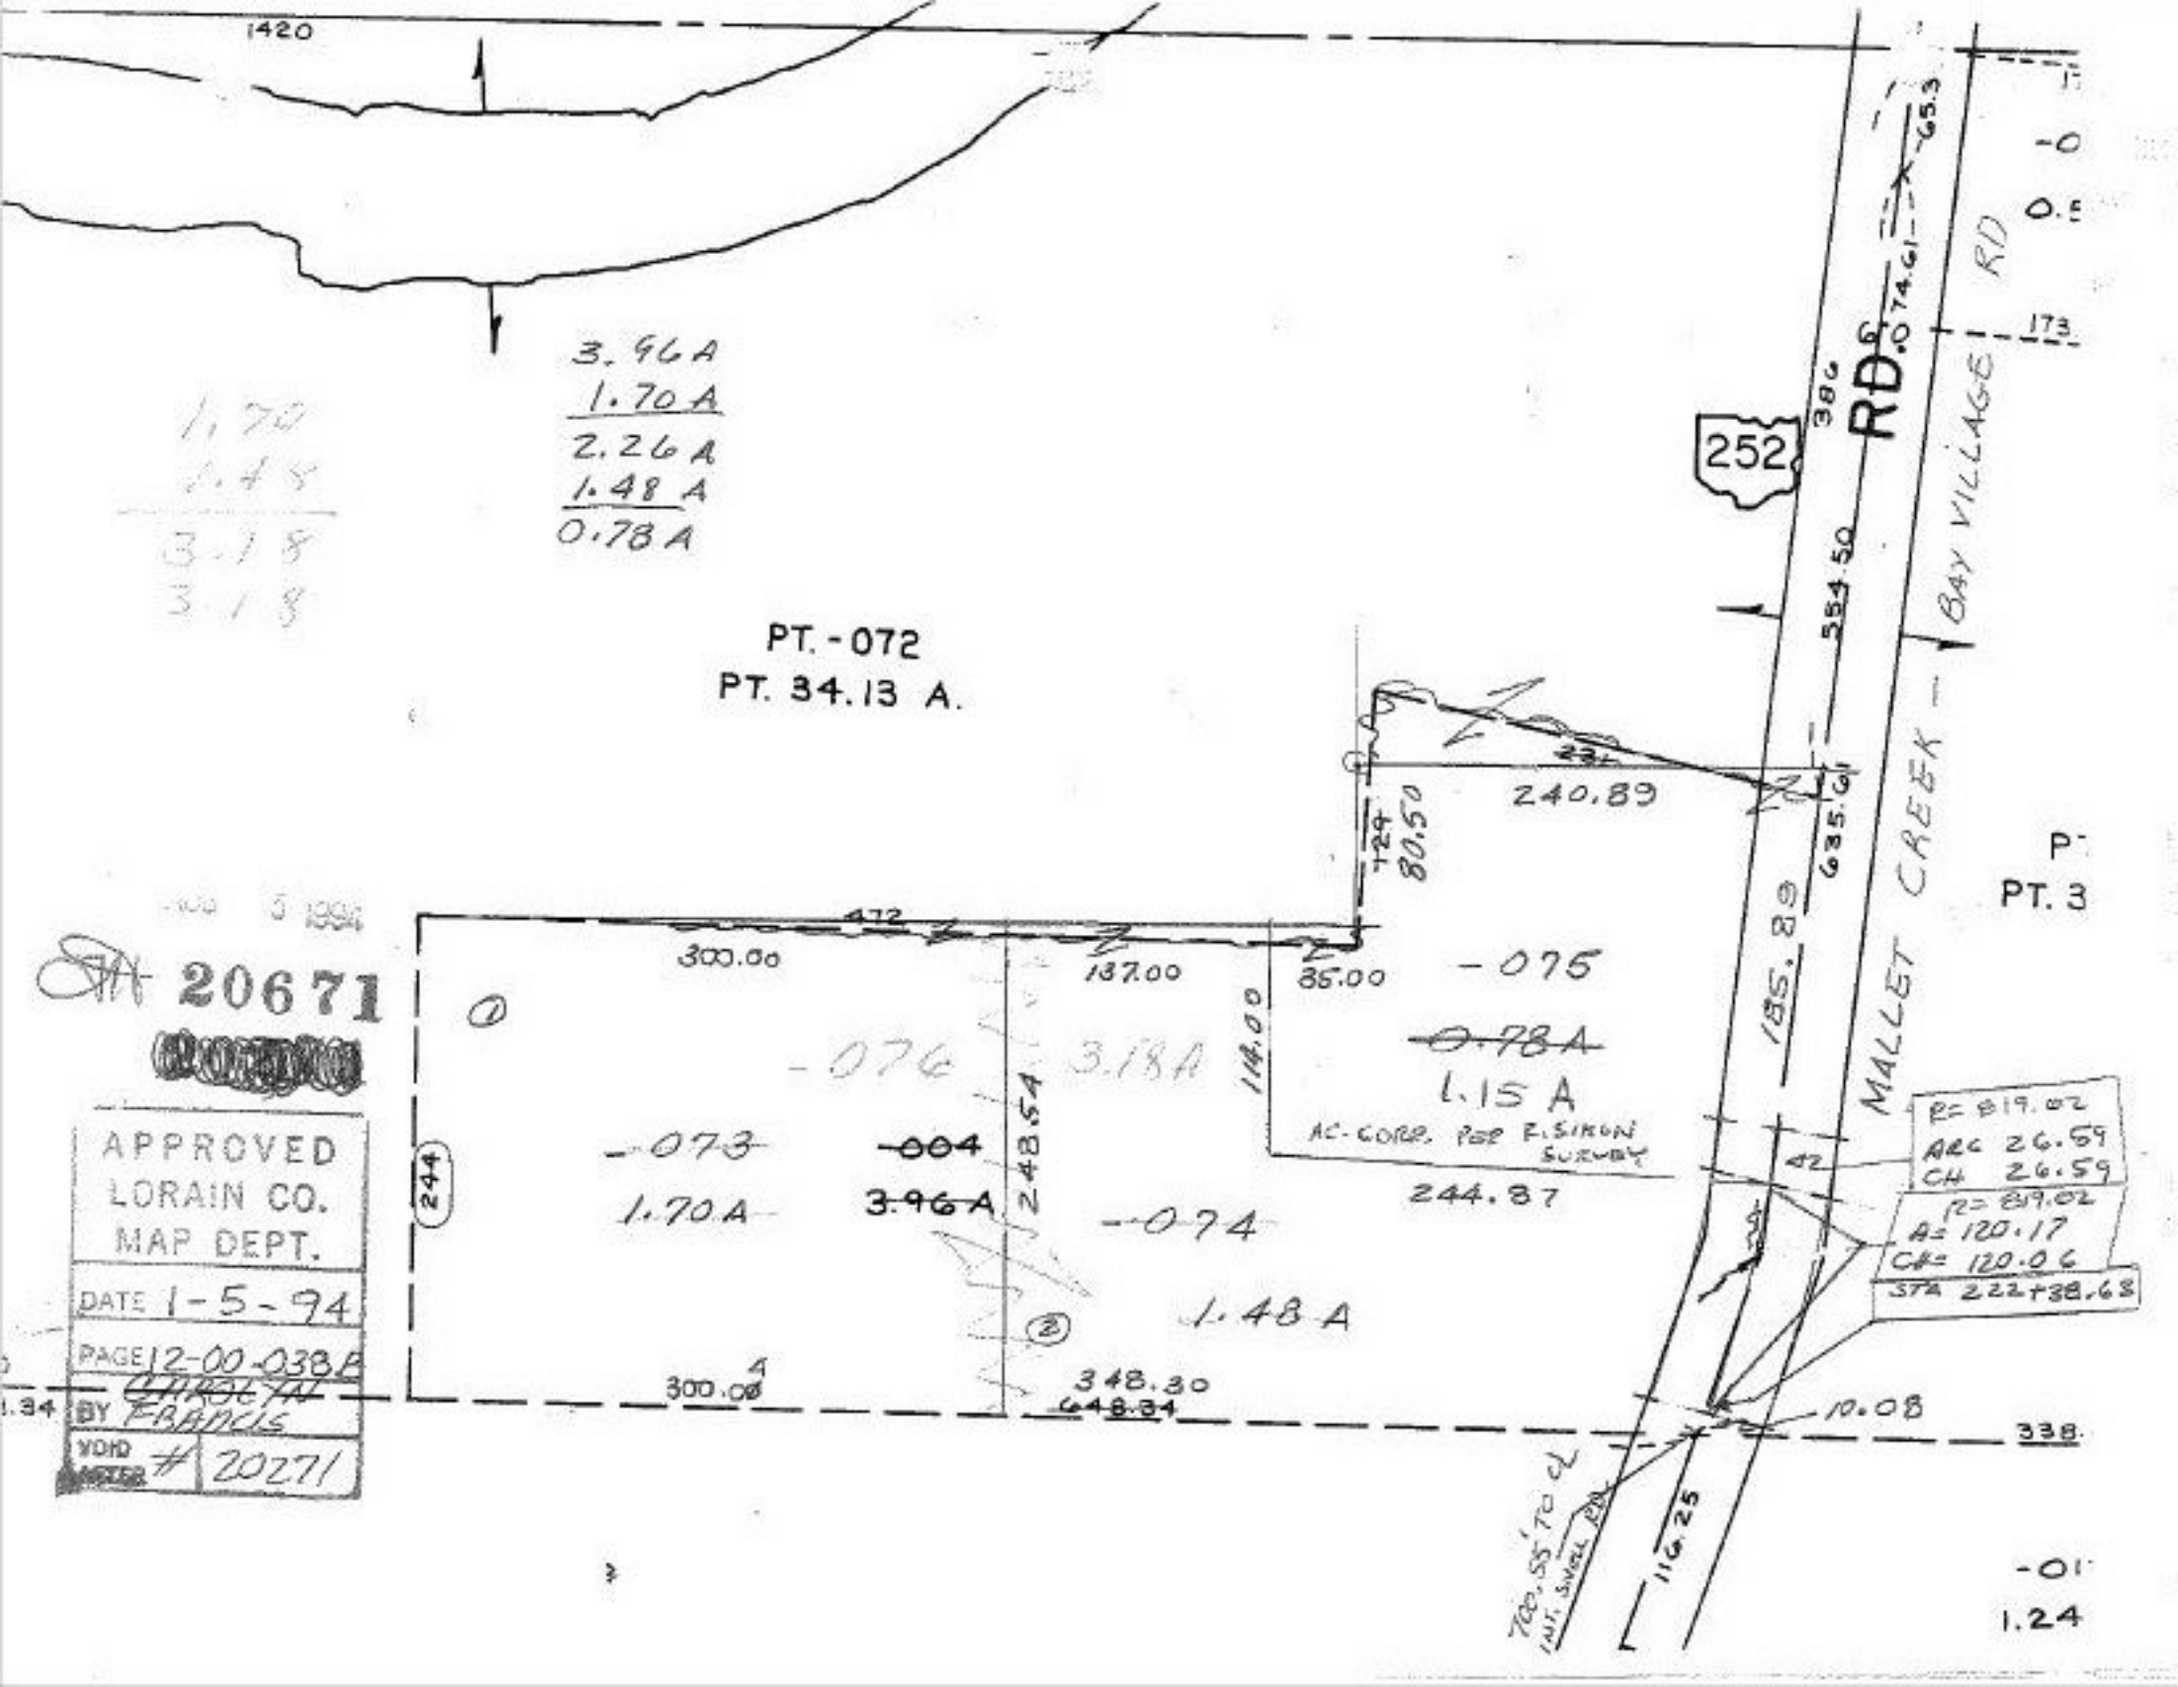

1420
3.96 A
1.70 A
2.26 A
1.48 A
0.78 A
1.70
1.48
3.18
3.18
PT. - 072
PT. 34.13 A.
252
RD
BAY VILLAGE RD
MALLET CREEK
65.3
74.61
386
354.50
635.61
185.89
240.89
80.50
472
300.00
137.00
35.00
114.00
-075
~~0.78 A~~
1.15 A
AC-CORP. PER R. SIMON SURVEY
244.87
-076
3.18 A
248.54
-073
1.70 A
~~-004~~
~~3.96 A~~
-074
1.48 A
244
300.00
348.30
648.34
10.08
338
700.55' TO ℄ INT. SWELL RD
116.25
R= 819.02
ARC 26.59
CH 26.59
R= 819.02
A= 120.17
CH= 120.06
STA 222+38.63
PT. 3
1.24
20671
APPROVED
LORAIN CO.
MAP DEPT.
DATE 1-5-94
PAGE 12-00-038B
BY CAROLYN FRANCIS
VOID AFTER # 20271