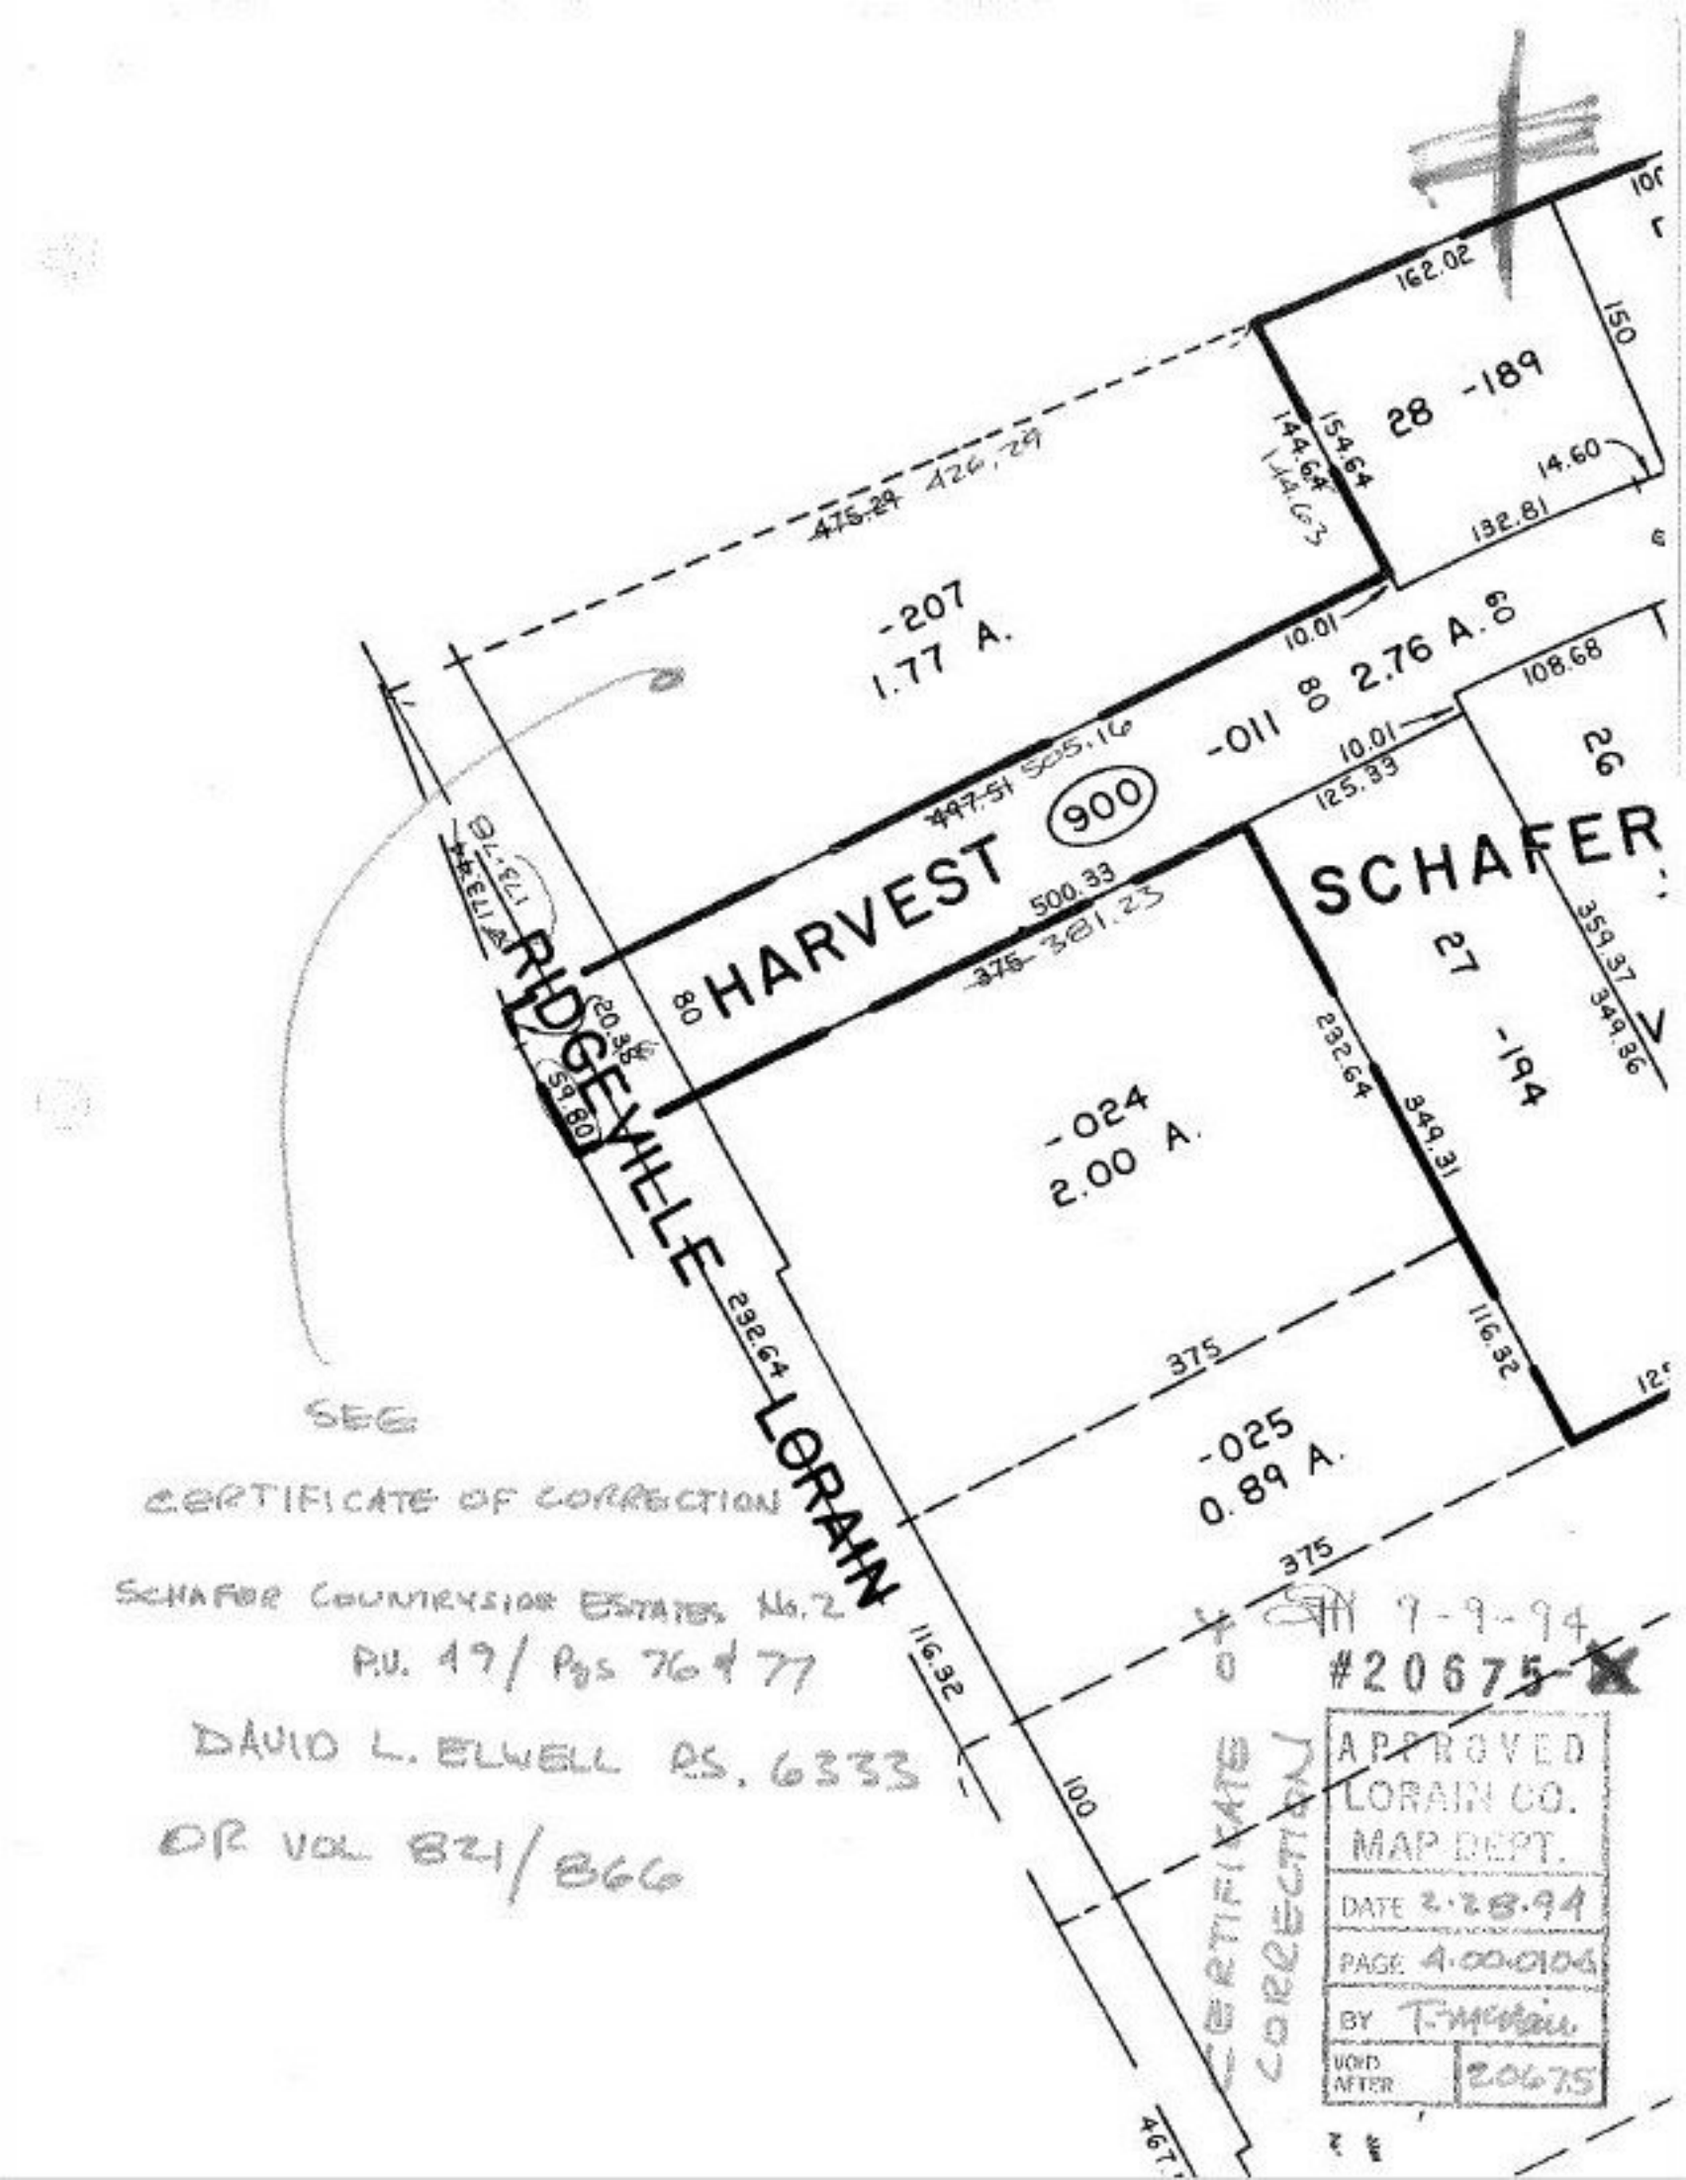

SEE

CERTIFICATE OF CORRECTION


P.U. 49/ Pgs 76 & 77

DAVID L. ELWELL PS. 6333

OR VOL 821/866

7-9-94

#20675