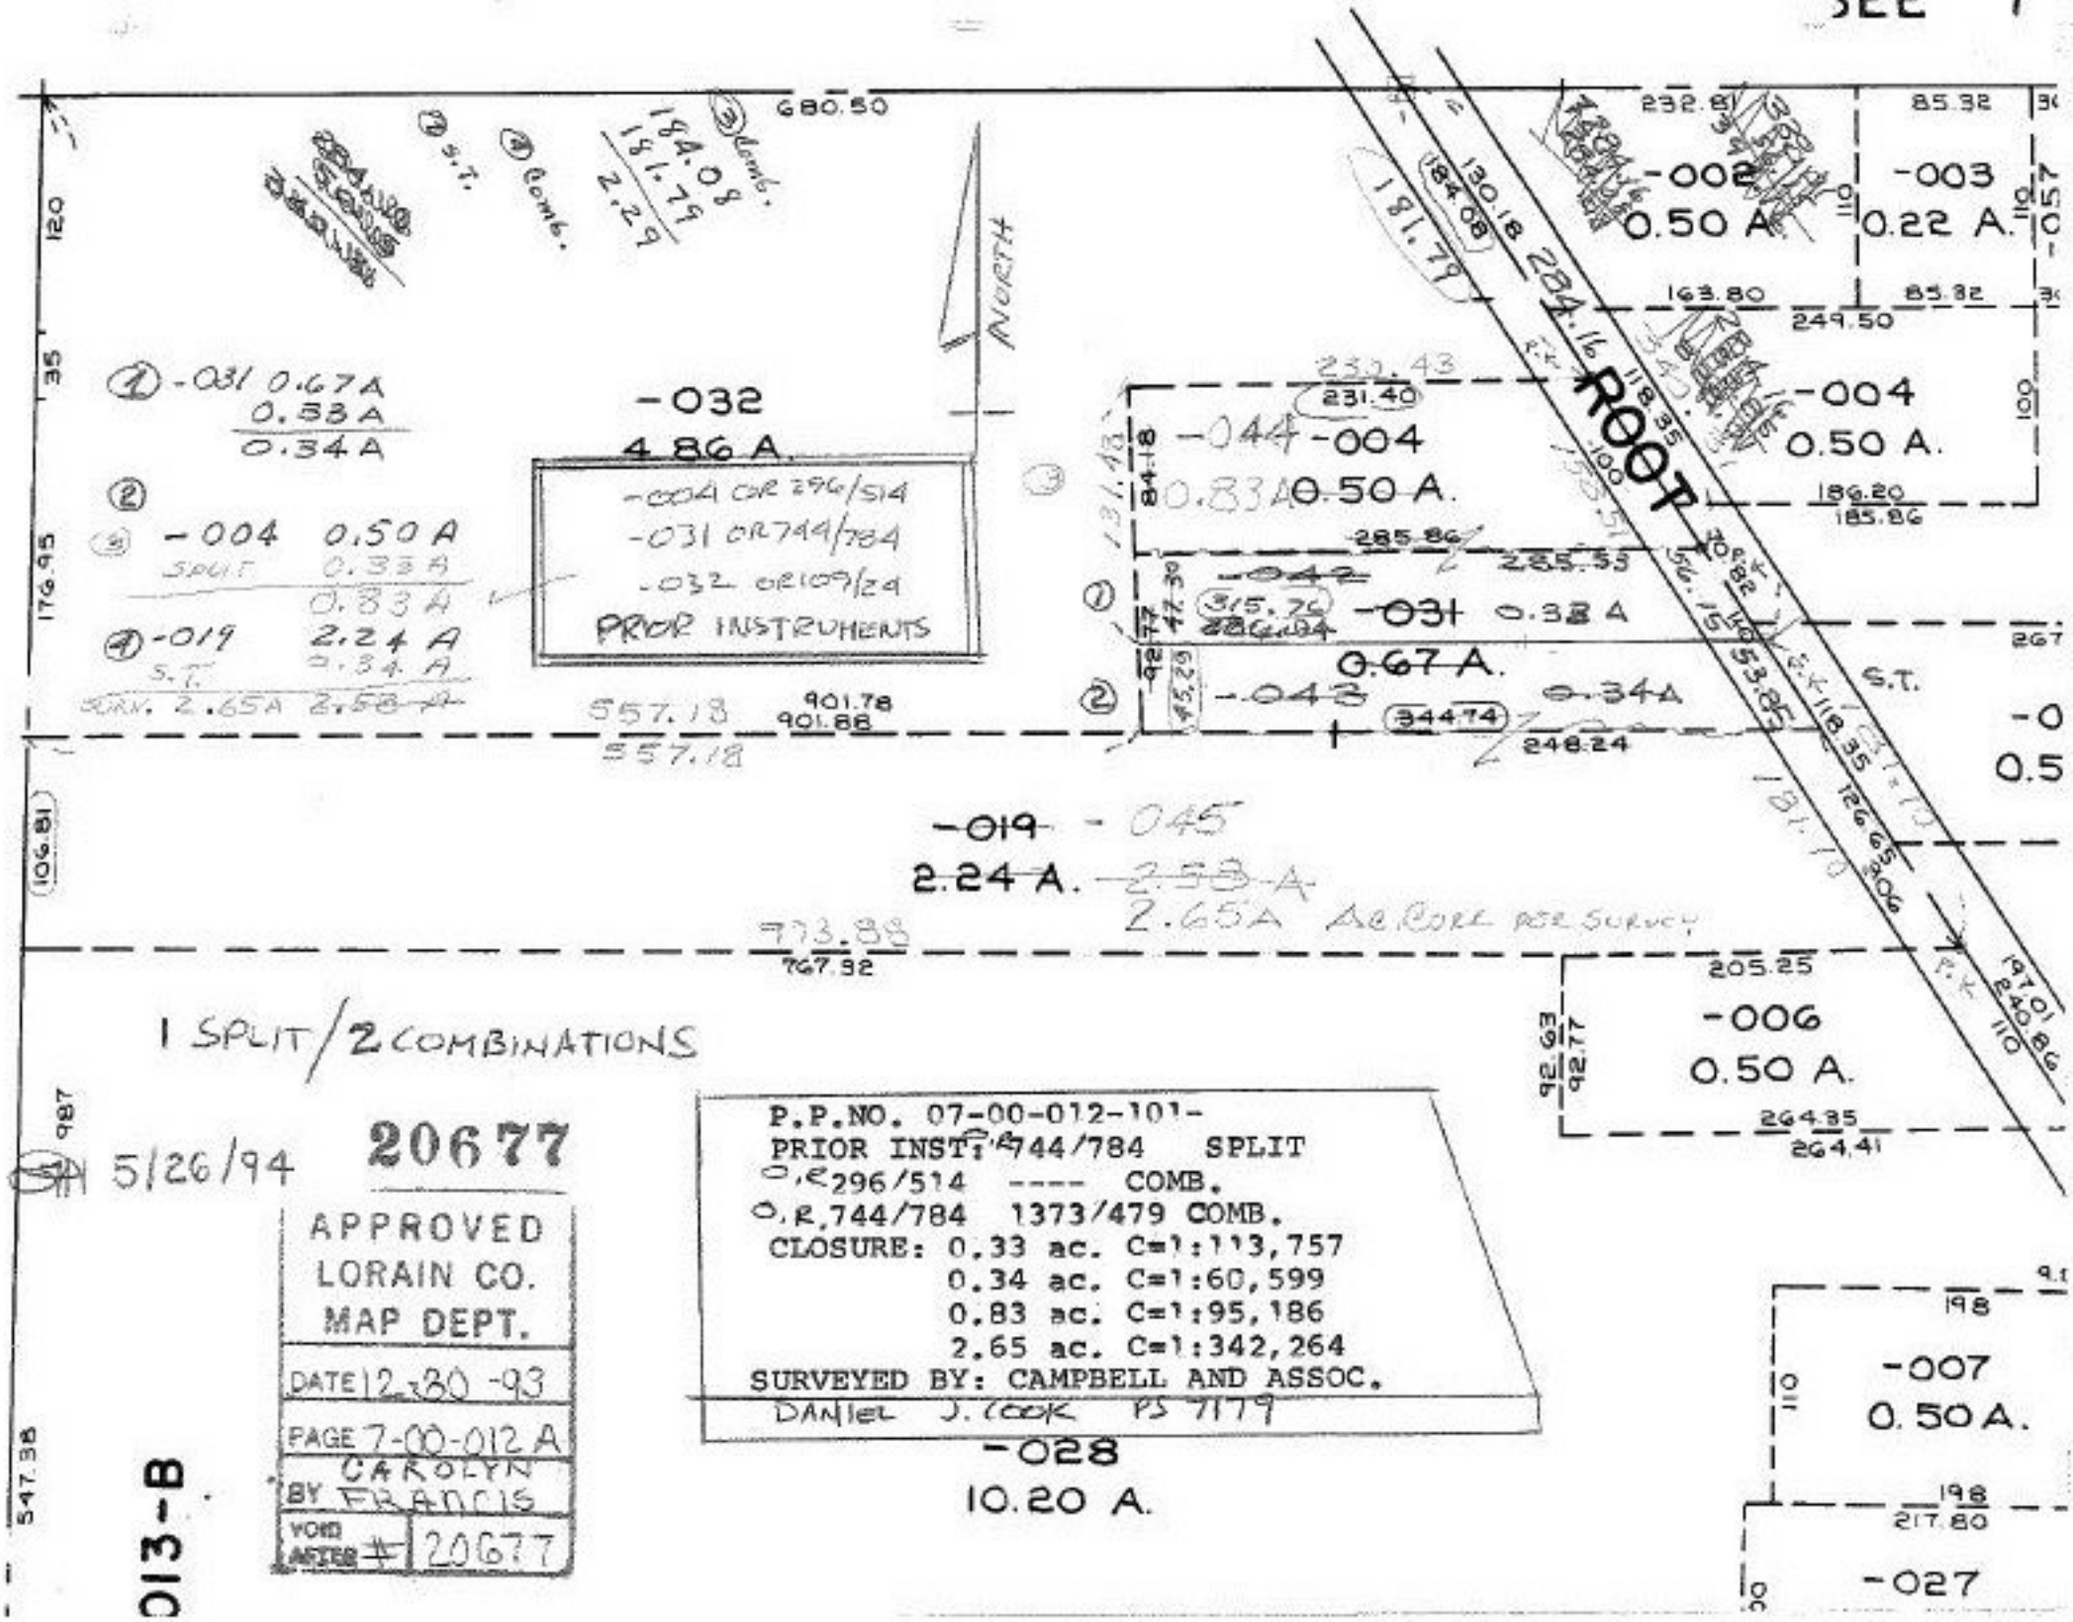
SEE 7
680.50
NORTH
-032
4.86 A
-004 OR 296/514
-031 OR 744/784
-032 OR 109/24
PRIOR INSTRUMENTS
-031 0.67A
0.33A
0.34A
-004 0.50A
SPLIT 0.33A
0.33A
-019 2.24A
S.T. 0.34A
CORR. 2.65A 2.58A
557.18
901.78
901.88
557.18
-044 -004
0.83A 0.50A
-042
315.76
286.84
-031 0.33A
0.67A
-042 0.34A
344.74
248.24
ROOT
-002
0.50 A
-003
0.22 A.
-004
0.50 A.
-045
2.24 A. 2.53A
2.65A AS PER SURVEY
973.88
767.92
-006
0.50 A.
-007
0.50A.
-027
-028
10.20 A.
1 SPLIT / 2 COMBINATIONS
5/26/94 20677
APPROVED
LORAIN CO.
MAP DEPT.
DATE 12-30-93
PAGE 7-00-012 A
BY CAROLYN FRANCIS
VOID AFTER # 20677
P.P.NO. 07-00-012-101-
PRIOR INST. R 744/784 SPLIT
O.R 296/514 ---- COMB.
O.R. 744/784 1373/479 COMB.
CLOSURE: 0.33 ac. C=1:113,757
0.34 ac. C=1:60,599
0.83 ac. C=1:95,186
2.65 ac. C=1:342,264
SURVEYED BY: CAMPBELL AND ASSOC.
DANIEL J. COOK PS 7179
013-B