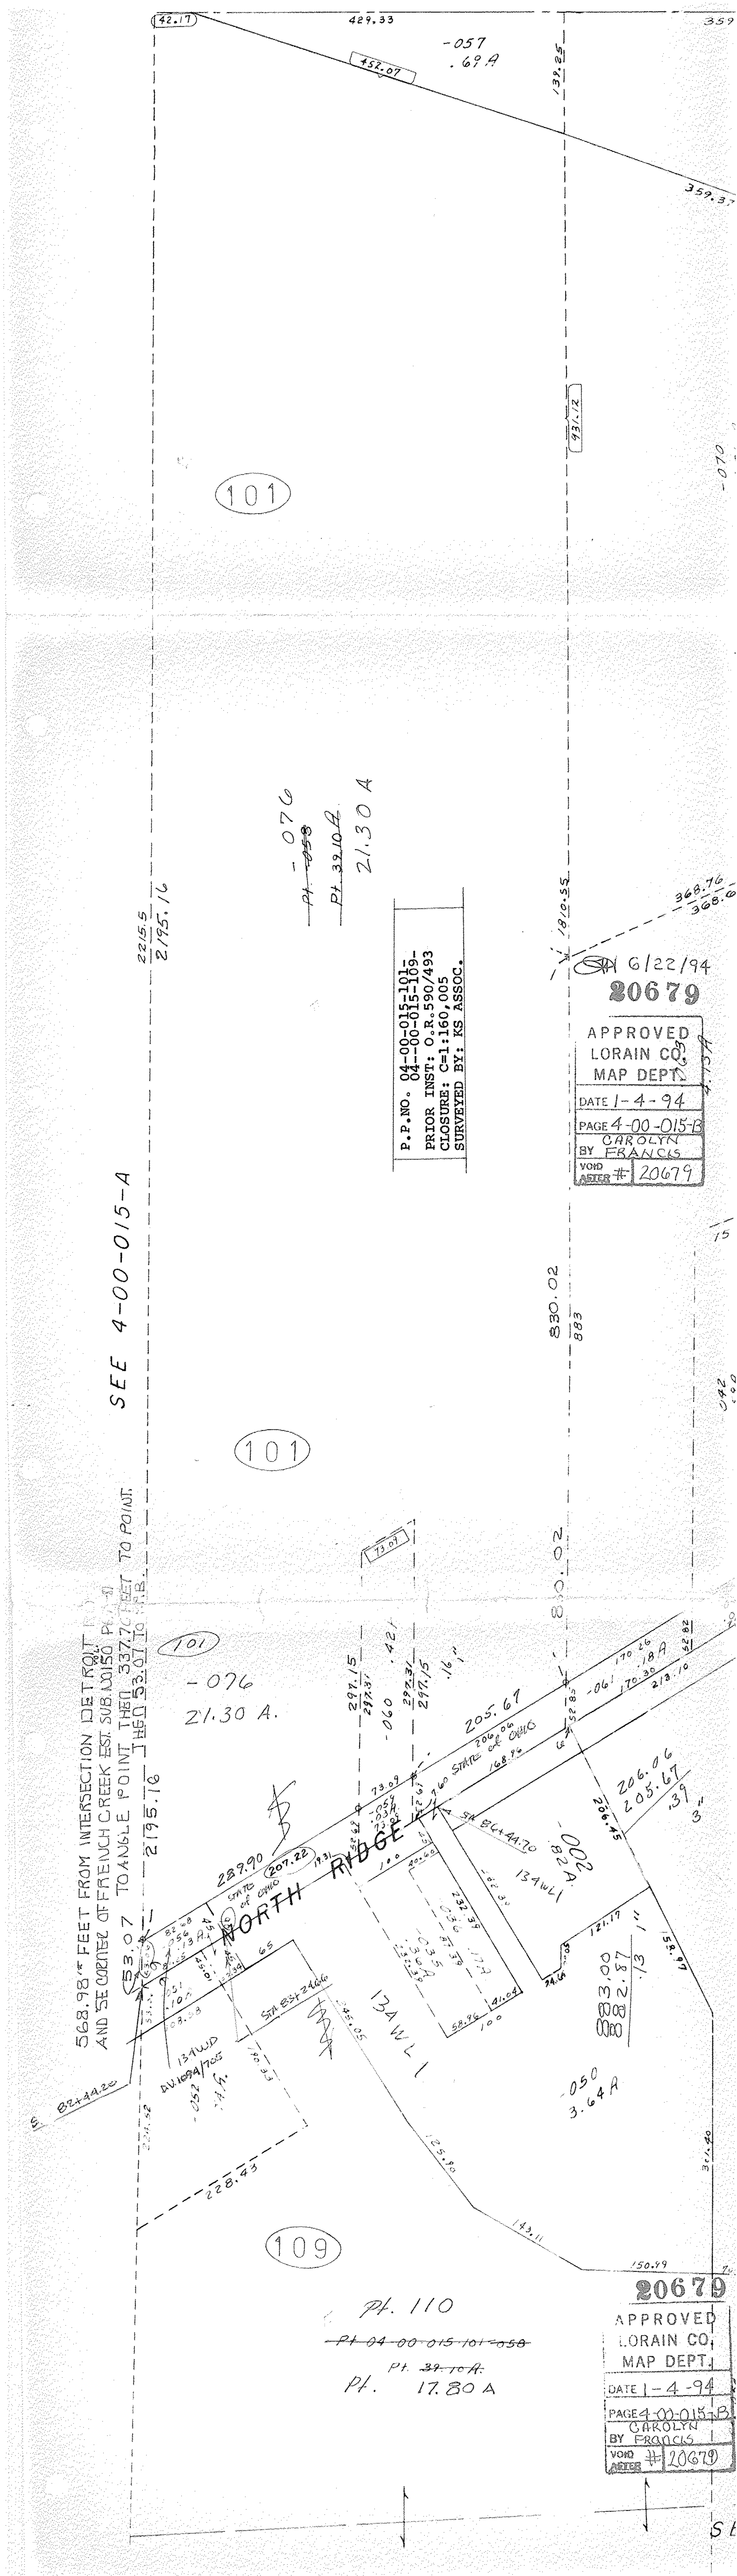

42.17
429.33
452.07
-057
.69 A
139.25
359.37
931.12
101
-070
-076
~~Pt. -058~~
Pt. 39.10 A
21.30 A
2215.5
2195.16
P.P.NO. 04-00-015-101-
04-00-015-109-
PRIOR INST: O.R.590/493
CLOSURE: C=1:160,005
SURVEYED BY: KS ASSOC.
1810.55
368.76
368.6
6/22/94
20679
APPROVED
LORAIN CO.
MAP DEPT.
DATE 1-4-94
PAGE 4-00-015-B
BY CAROLYN FRANCIS
VOID AFTER # 20679
SEE 4-00-015-A
830.02
883
101
73.09
101
-076
21.30 A.
568.98 FEET FROM INTERSECTION DETROIT
AND SE CORNER OF FRENCH CREEK EST. SUB. 0150
TO ANGLE POINT THEN 337.70 FEET TO POINT
THEN 53.07 TO N.B.
53.07
2195.16
289.90
207.22
NORTH RIDGE
STATE OF OHIO
205.67
206.06
205.67
.39
3"
-002
.82 A
13AWL1
13AWL1
883.00
882.87
.13
-050
3.64 A
228.43
109
Pt. 110
~~Pt 04-00-015-101-058~~
Pt. ~~39.10 A.~~
Pt. 17.80 A
20679
APPROVED
LORAIN CO.
MAP DEPT.
DATE 1-4-94
PAGE 4-00-015-B
BY CAROLYN FRANCIS
VOID AFTER # 20679