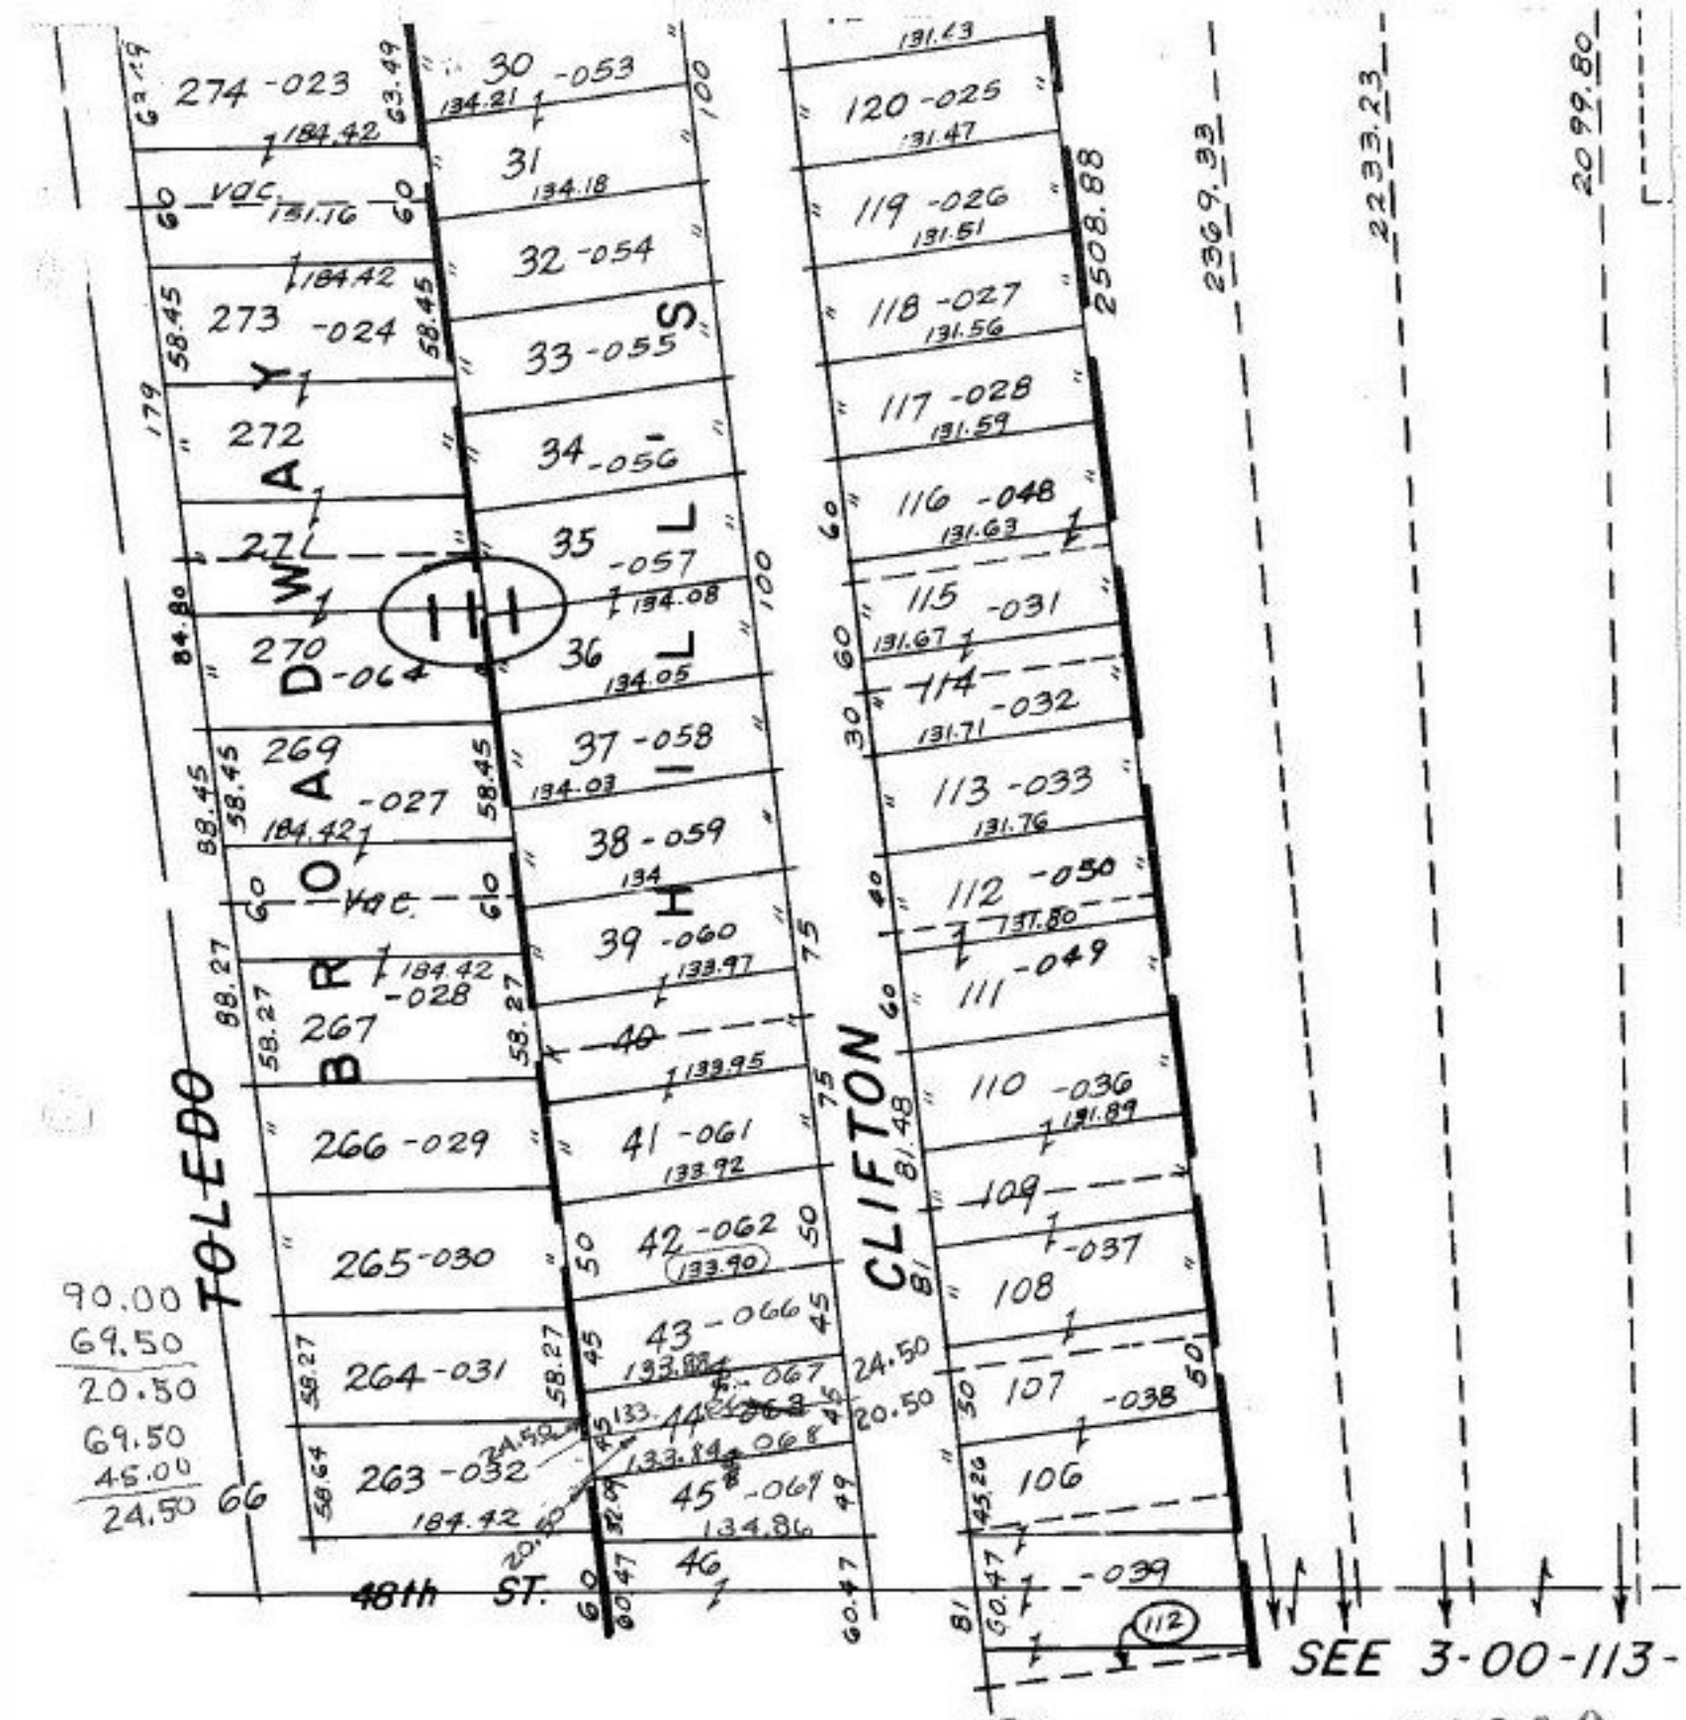

90.00
69.50
20.50
69.50
45.00
24.50

5/16/94

20680

P.P. NO. 03-00-108-111-
PRIOR INST: O.R. 271/221
SUBLOTS
JOHN POZYWAK SURVEYOR

APPROVED
LORAIN CO.
MAP DEPT.
DATE 1-6-94
PAGE 3-00-108B
BY CAROLYN FRANCIS
VOL # 20680

FFIELD TWP.

20'