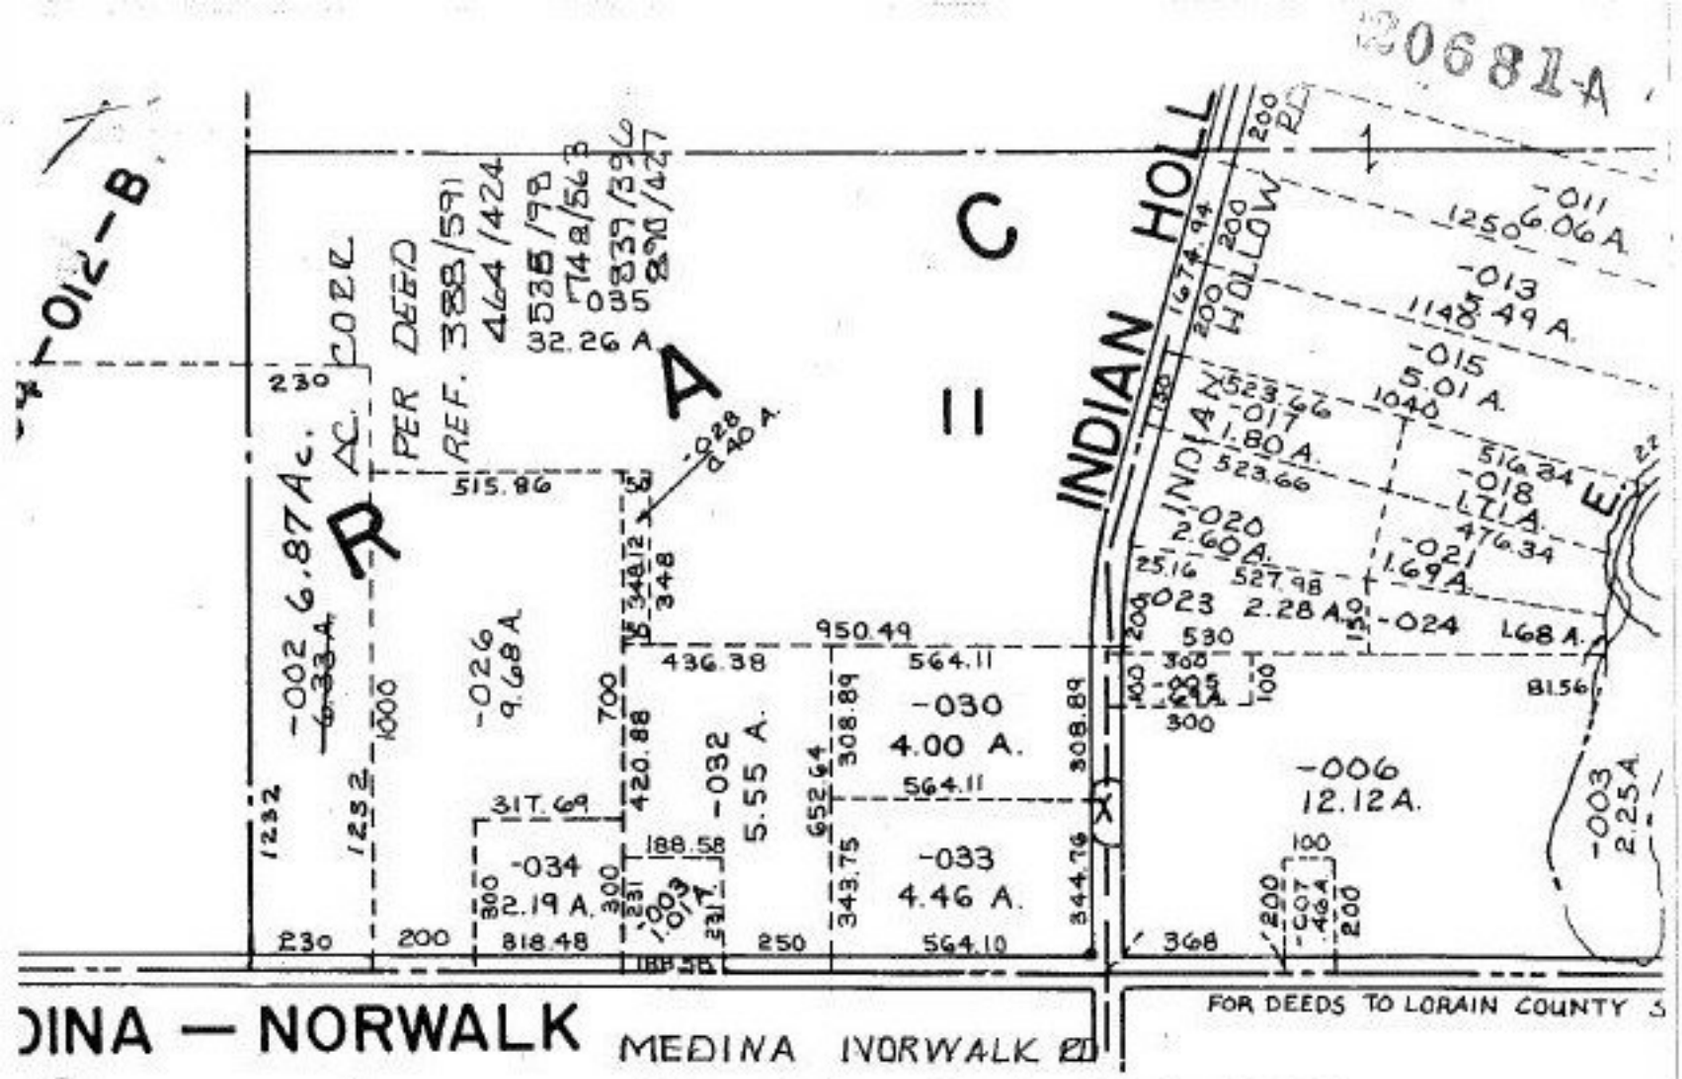

19-04-011-000-002

TRACT 4 LOTS 9 THRU 12, 34, 35
" 5 " 5 " 8 & WLY PT. LOTS
" 6 " 105 " 108

"ACREAGE" CORRECTION

0 400 800

#20681A

APPROVED LORAIN CO. MAP DEPT.
DATE 6-28-94
PAGE 19-C
BY
VOID AFTER 20681A

Completed in REG.

APPROVED LORAIN CO. MAP DEPT
DATE 7-11-95
PAGE 19-C
BY CAROLYN FRANCIS
20681A