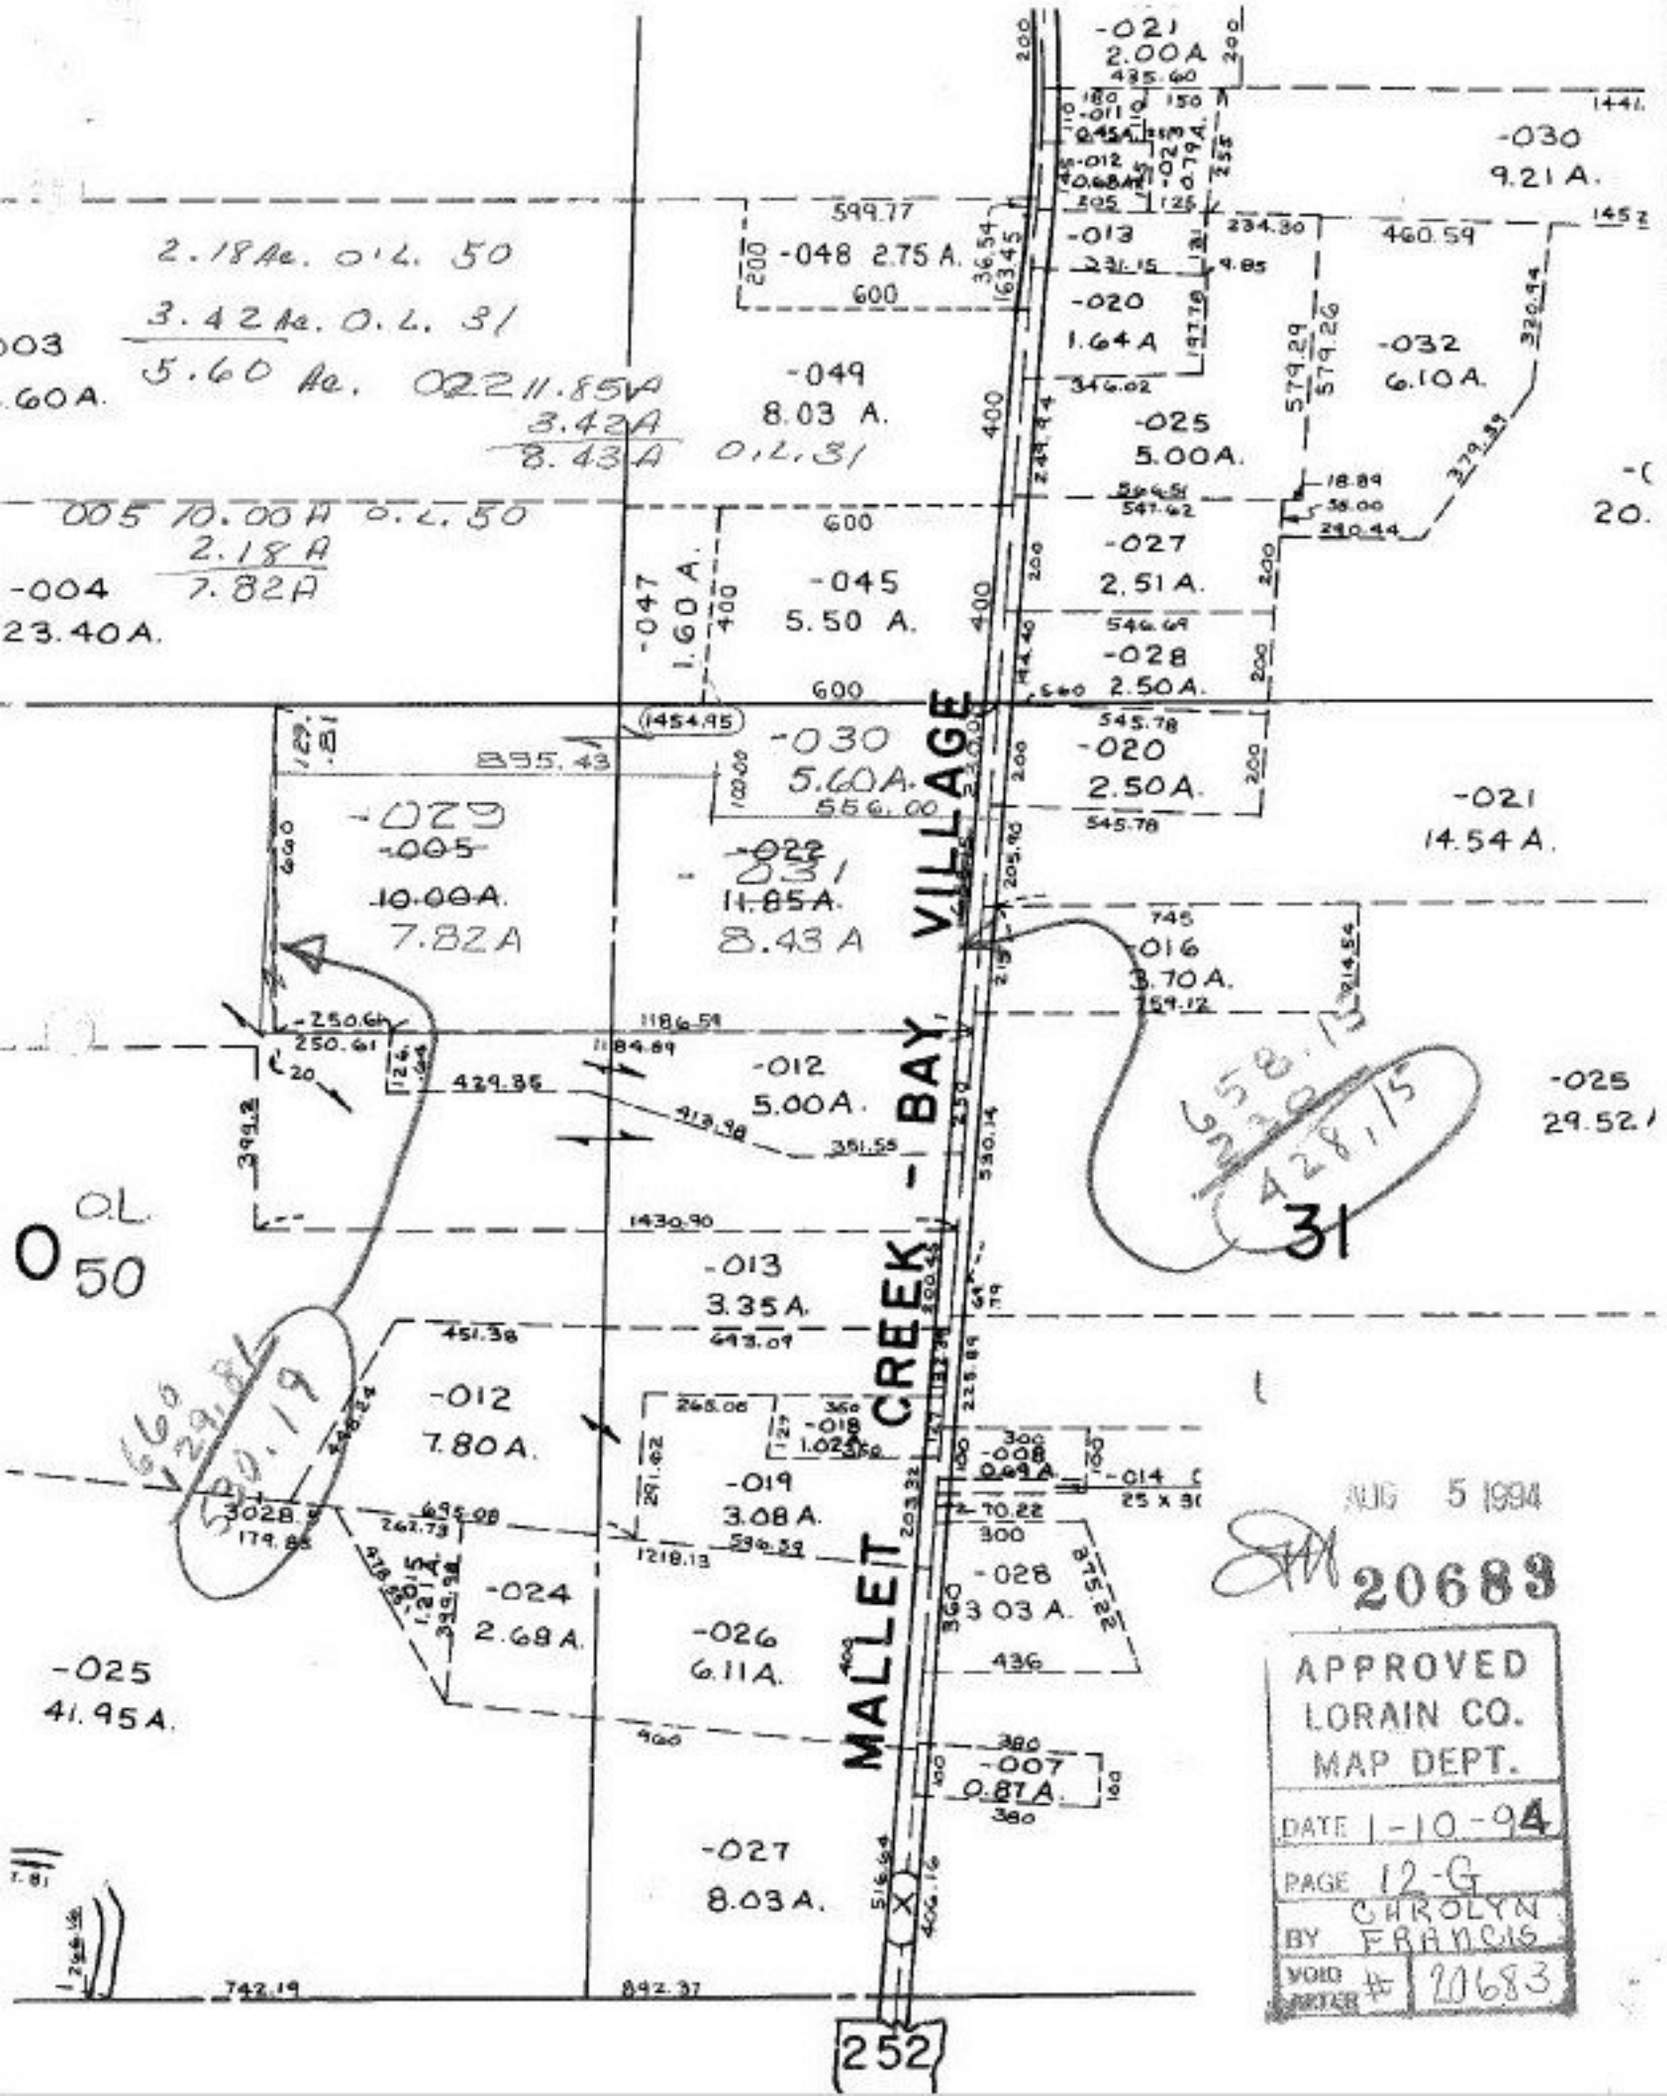
MALLET CREEK - BAY VILLAGE
-021
2.00A
-030
9.21 A.
-048 2.75 A.
-013
-020
1.64 A
-049
8.03 A.
-032
6.10A.
-025
5.00A.
2.18Ac. 0.L. 50
3.42Ac. 0.L. 31
5.60 Ac. 022 11.85VA
3.42A
8.43A 0.L. 31
005 10.00A 0.L. 50
2.18A
7.82A
-004
23.40A.
-047
1.60 A.
-045
5.50 A.
-027
2.51A.
-028
2.50A.
-030
5.60A.
-020
2.50A.
-029
-005
10.00A.
7.82A
-022
231
11.85A.
8.43A
-021
14.54 A.
-016
3.70A.
-012
5.00A.
-025
29.52
-013
3.35A.
-012
7.80A.
-018
1.02A
-008
0.99A
-019
3.08A.
-028
3.03 A.
-024
2.68A.
-026
6.11A.
-025
41.95A.
-007
0.87A.
-027
8.03A.
252
AUG 5 1994
20683
APPROVED
LORAIN CO.
MAP DEPT.
DATE 1-10-94
PAGE 12-G
BY CAROLYN FRANCIS
VOID AFTER # 20683