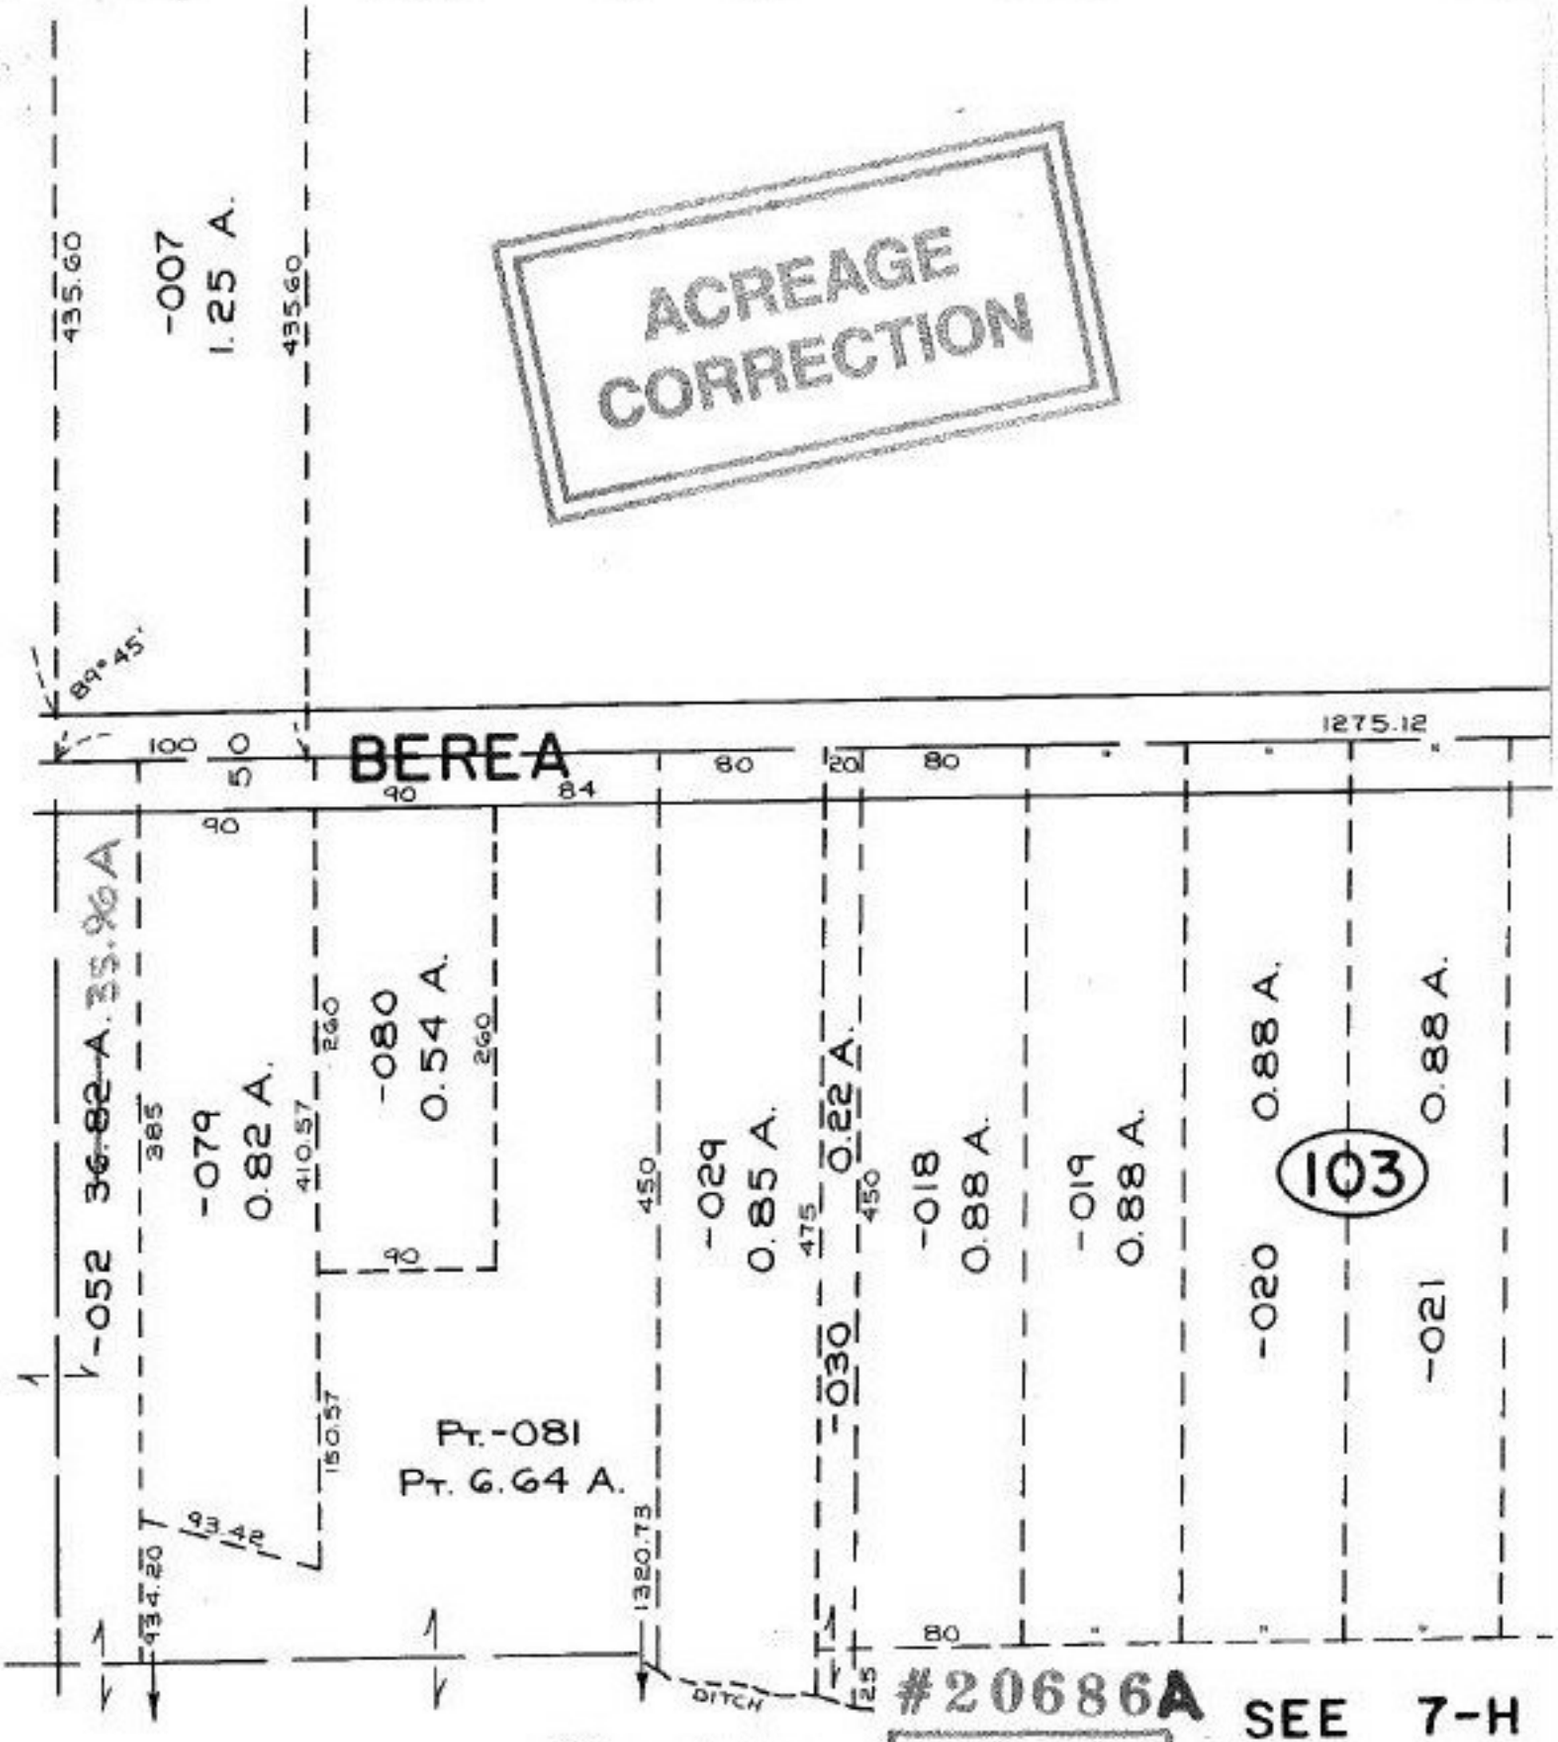

SH 2/8/94

APPROVED
LORAIN CO.
MAP DEPT.
DATE 12-28-93
PAGE 7-00-011-B
BY
VOID AFTER 20686A

MAP (2) OF (8)

7-00-011-B