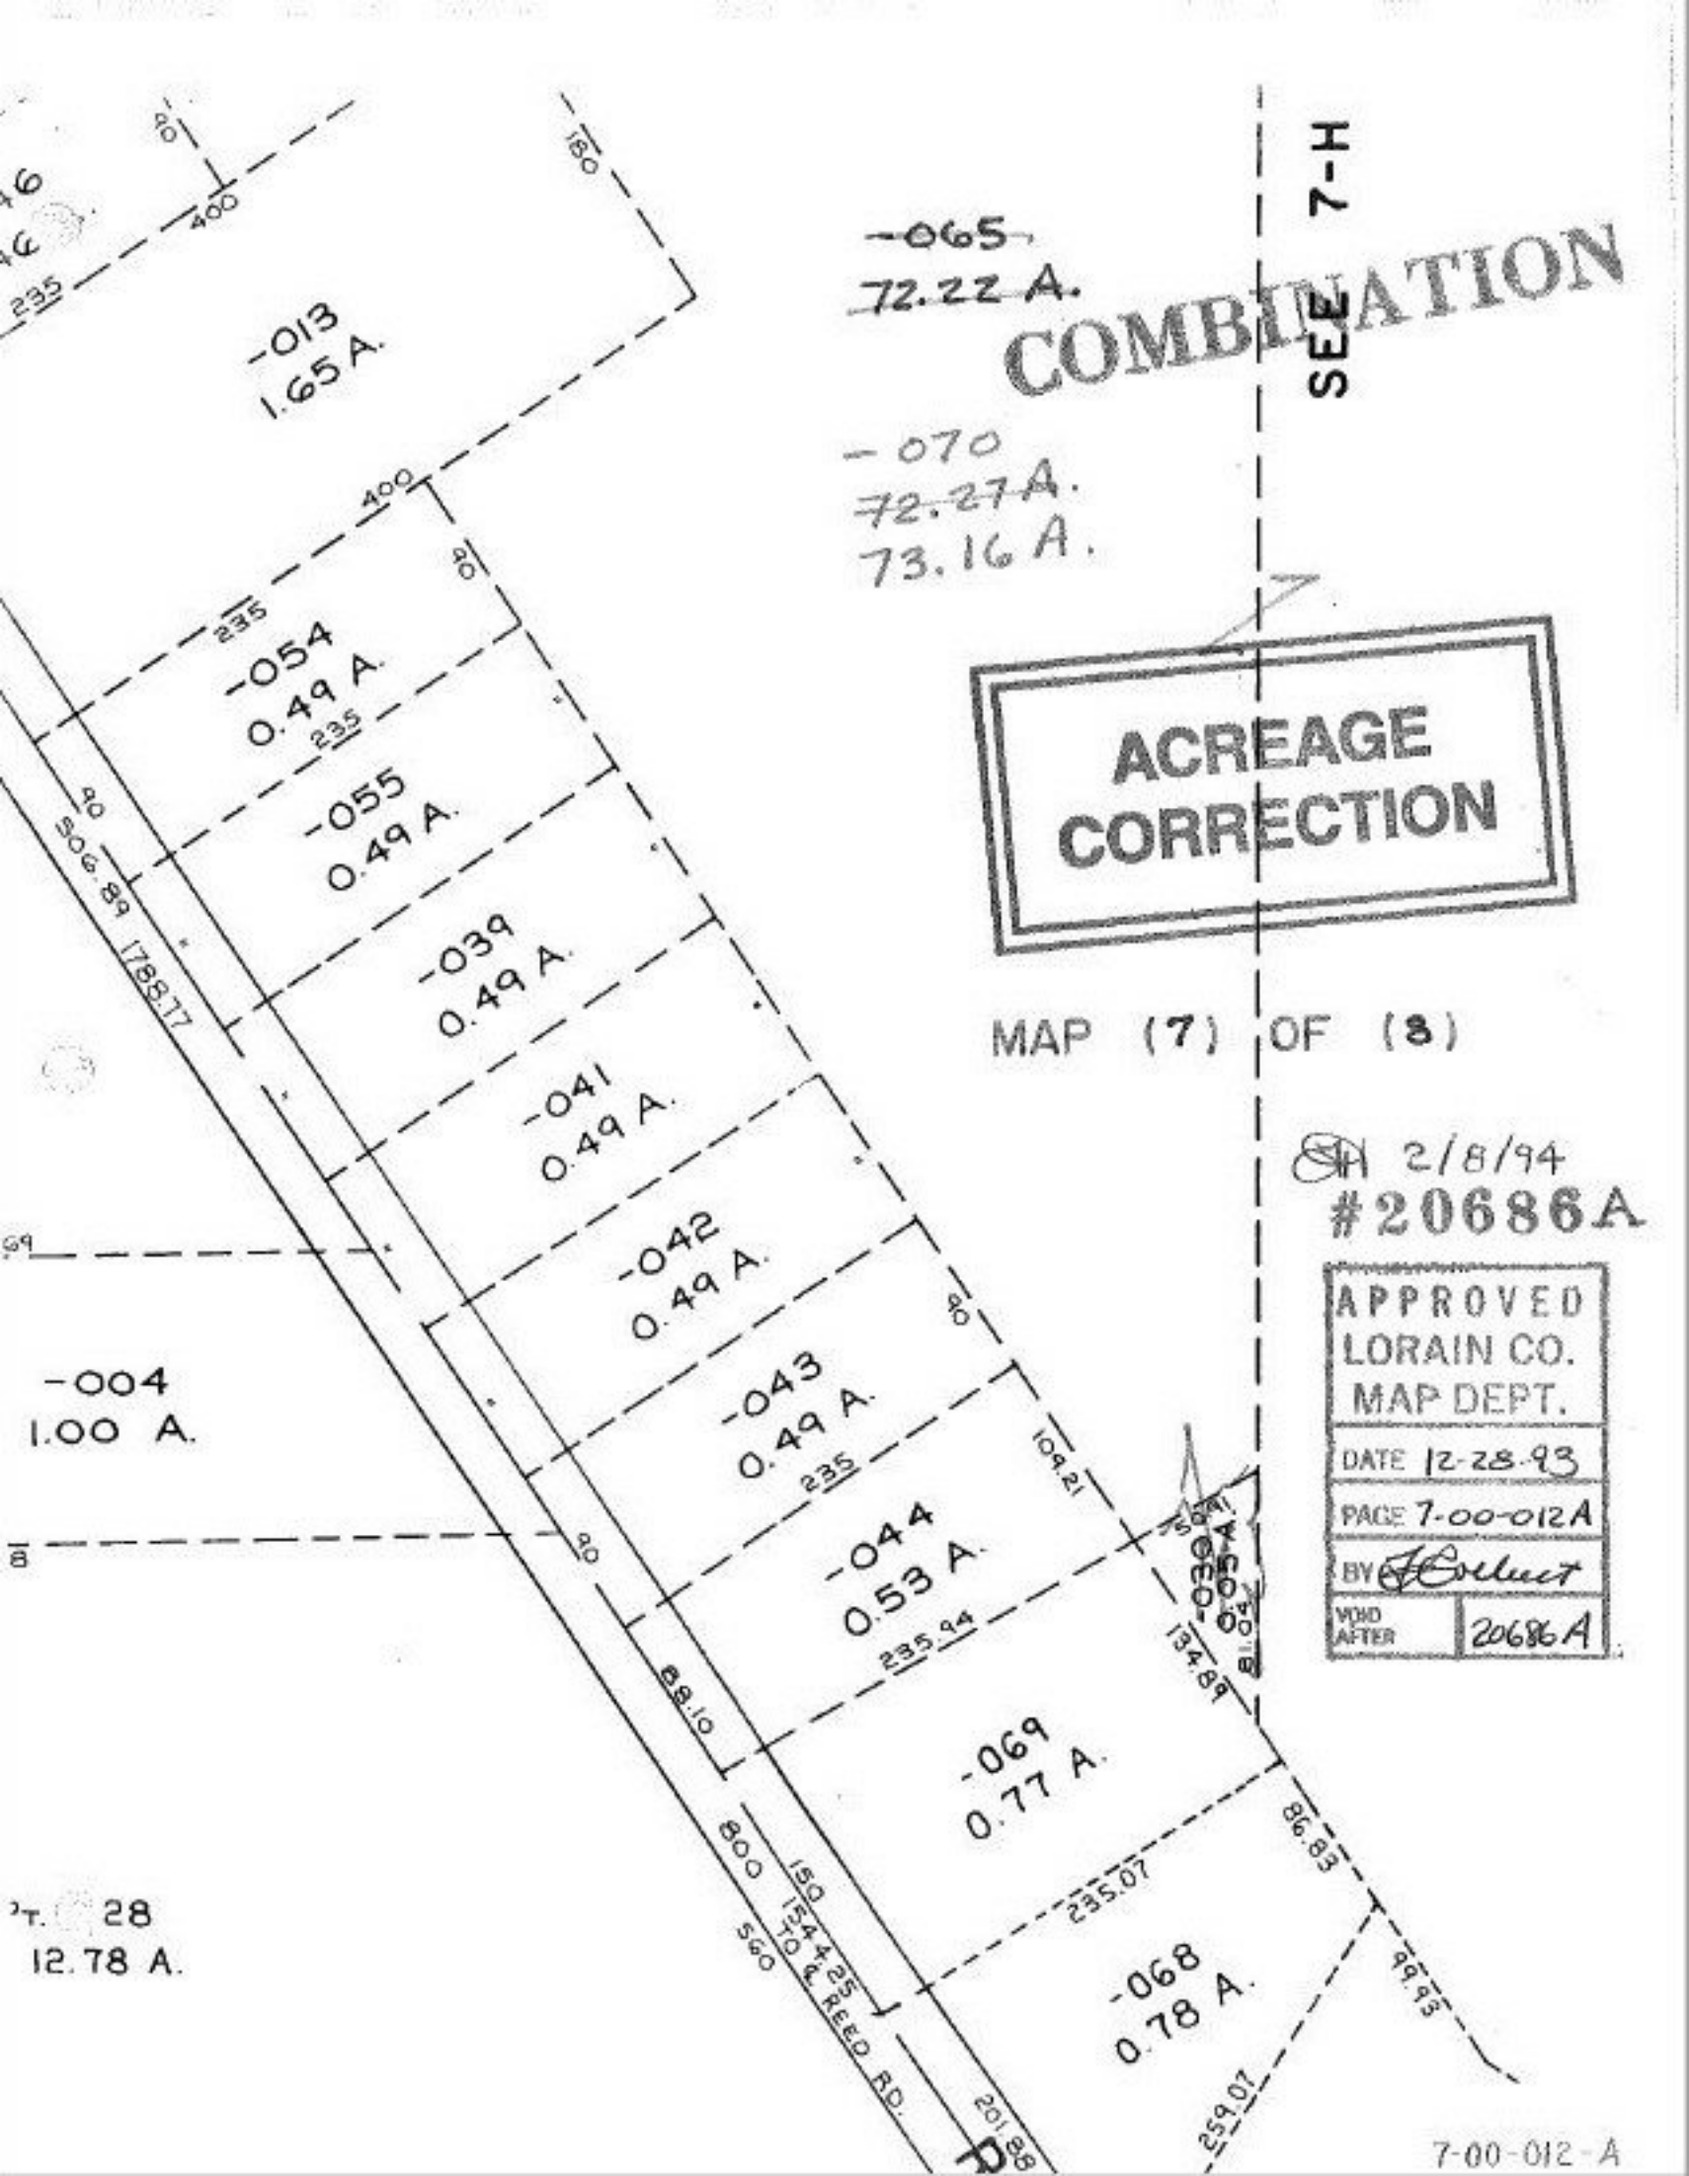

SEE 7-H
~~-065~~
~~72.22 A.~~
COMBINATION
-070
~~72.27 A.~~
73.16 A.
ACREAGE CORRECTION
MAP (7) OF (8)
2/8/94
#20686A
APPROVED
LORAIN CO.
MAP DEPT.
DATE 12-28-93
PAGE 7-00-012A
BY
VOID AFTER 20686A
-013
1.65 A.
-054
0.49 A.
-055
0.49 A.
-039
0.49 A.
-041
0.49 A.
-042
0.49 A.
-043
0.49 A.
-044
0.53 A.
-069
0.77 A.
-068
0.78 A.
-004
1.00 A.
-030
0.05 A.
PT. 28
12.78 A.
506.89
1788.77
109.21
235.94
88.10
134.89
235.07
86.83
99.93
259.07
201.88
800
150
154.425
560
TO ℄ REED RD.
7-00-012-A