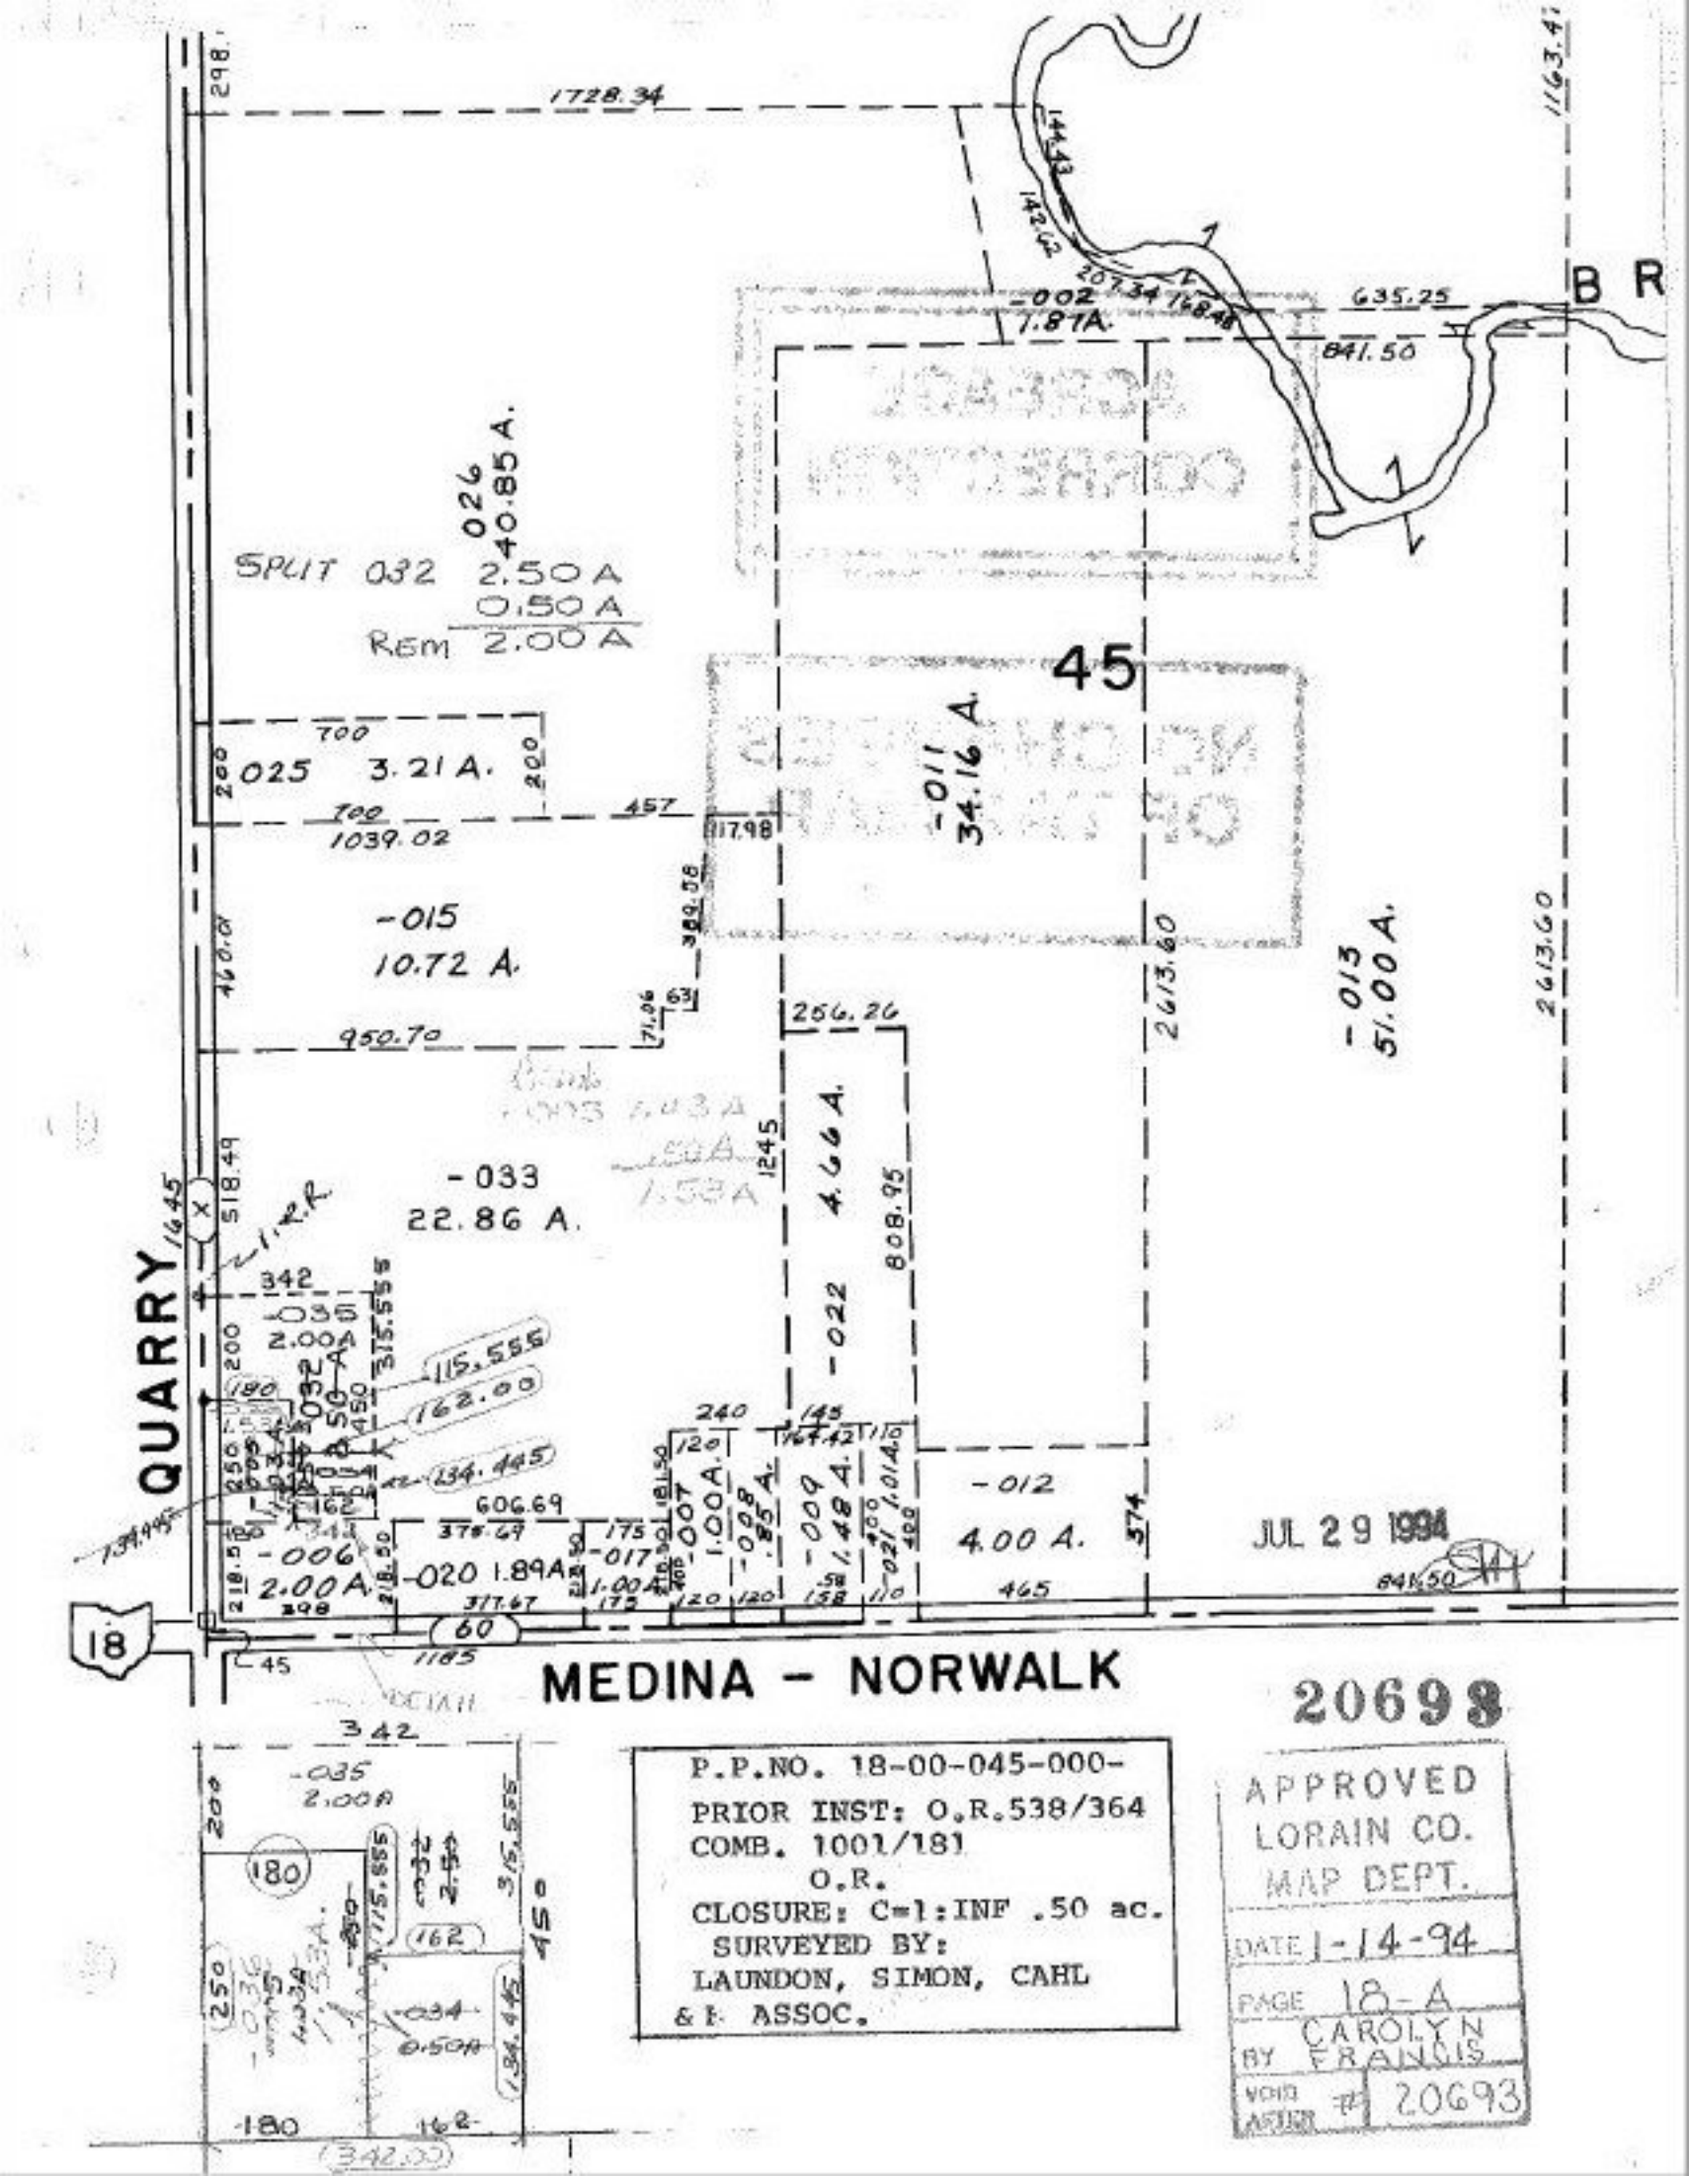

P.P.NO. 18-00-045-000-
PRIOR INST: O.R.538/364
COMB. 1001/181
O.R.
CLOSURE: C=1:INF .50 ac.
SURVEYED BY:
LAUNDON, SIMON, CAHL
& ASSOC.

20698

APPROVED
LORAIN CO.
MAP DEPT.
DATE 1-14-94
PAGE 18-A
BY CAROLYN FRANCIS
VOID AFFIDAVIT # 20693