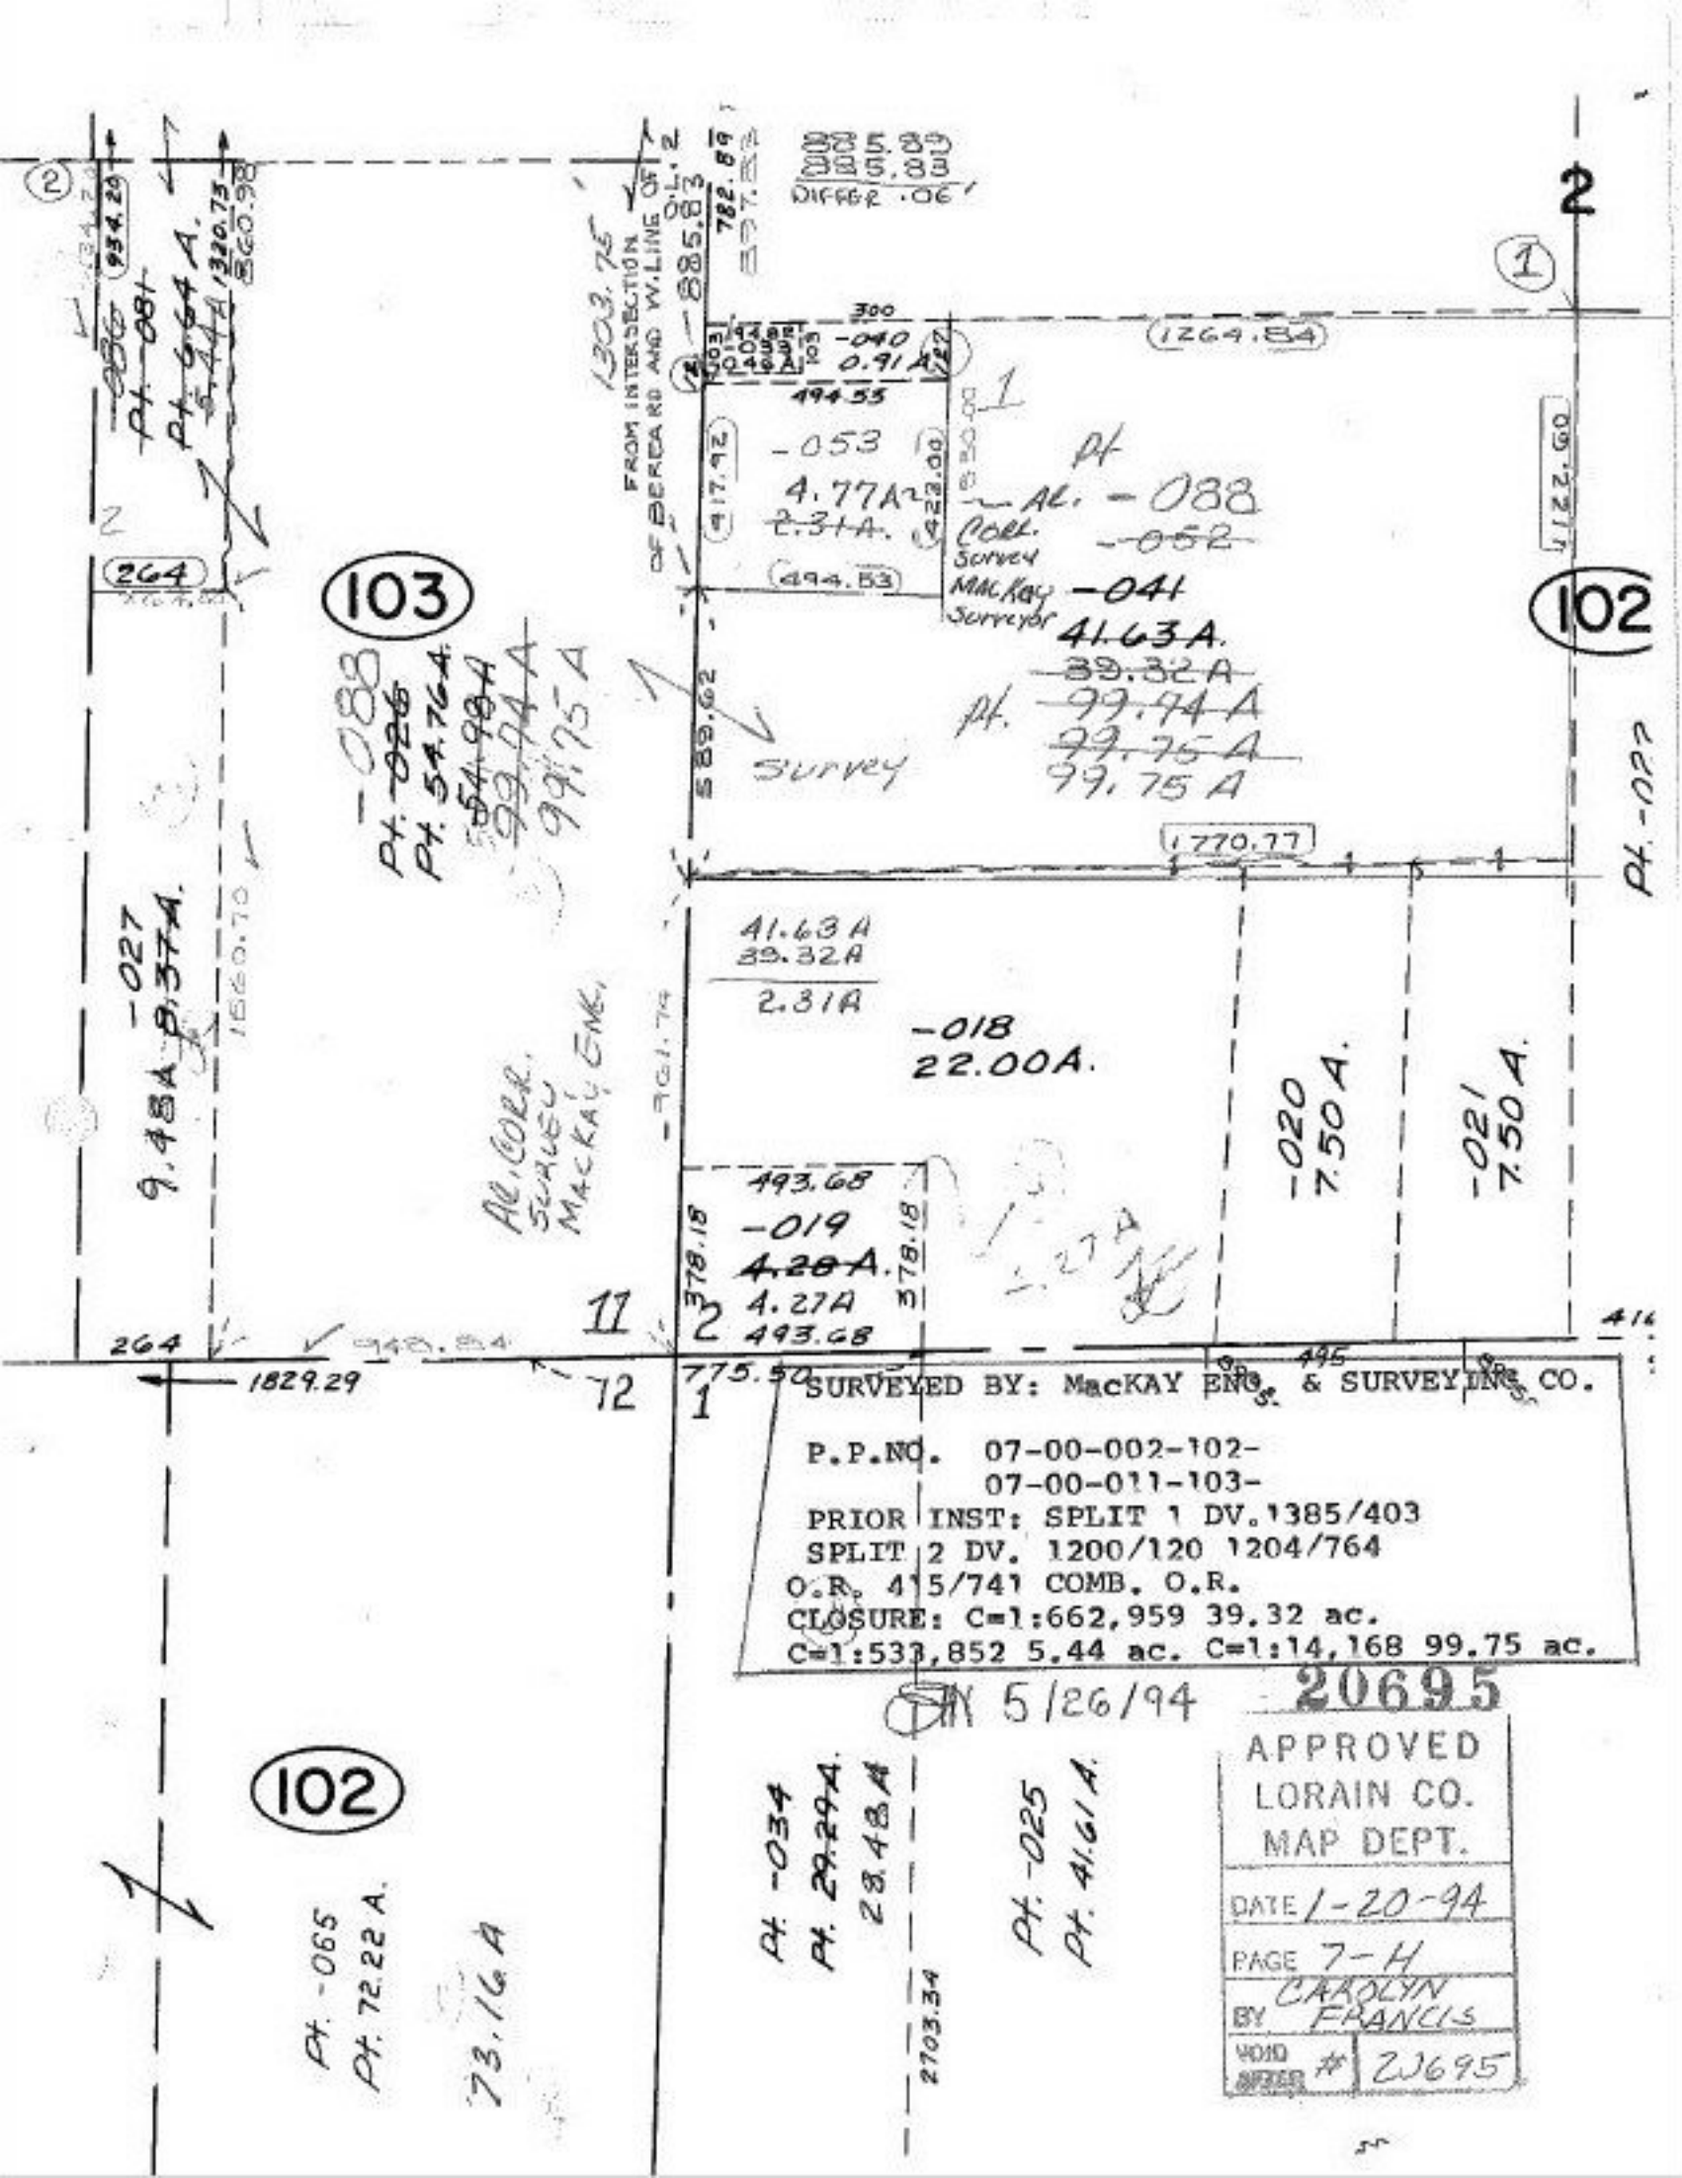
103
102
-088
Pt. 54.764 A.
54.984 A
99.94 A
99.75 A
-027
9.484 A. 9.374 A.
-053
4.77A
2.31A.
-040
0.91 A
-088
Pt.
-052
-041
41.63A.
39.32A
99.94 A
99.75 A
-018
22.00A.
41.63A
39.32A
2.31A
-020
7.50 A.
-021
7.50 A.
-019
4.20A.
4.27A
493.68
-034
Pt. 29.294.
28.484
-025
Pt. 41.61 A.
-065
Pt. 72.22 A.
73.16 A
1264.84
1829.29
1770.77
1660.70
2703.34
SURVEYED BY: MacKAY ENG. & SURVEYING CO.
P.P.NO. 07-00-002-102-
07-00-011-103-
PRIOR INST: SPLIT 1 DV. 1385/403
SPLIT 2 DV. 1200/120 1204/764
O.R. 415/741 COMB. O.R.
CLOSURE: C=1:662,959 39.32 ac.
C=1:533,852 5.44 ac. C=1:14,168 99.75 ac.
5/26/94
20695
APPROVED
LORAIN CO.
MAP DEPT.
DATE 1-20-94
PAGE 7-H
BY CAROLYN FRANCIS
VOID AFTER # 20695