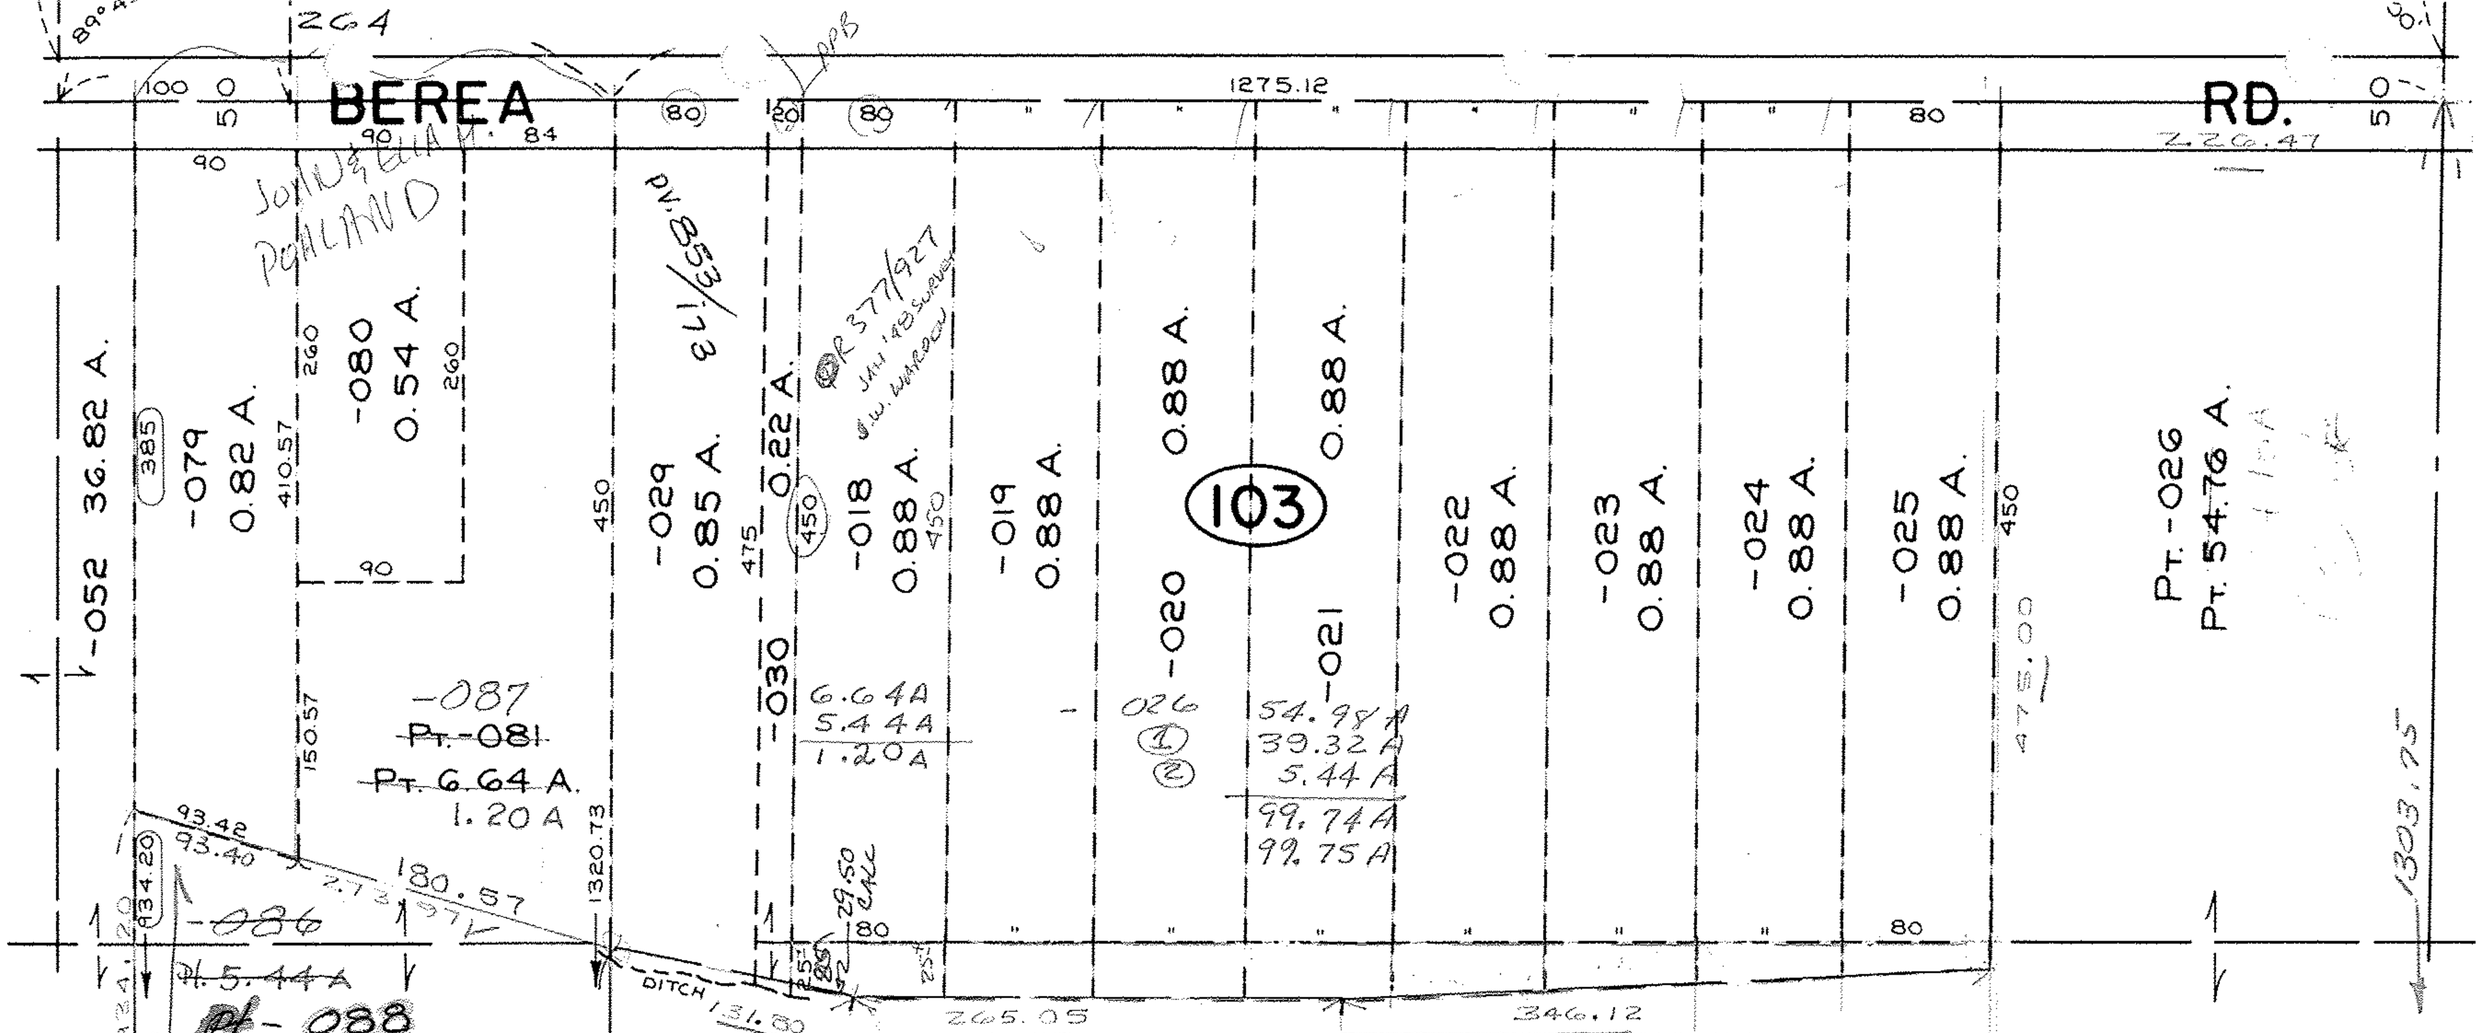

P.P.NO. 07-00-002-102- 07-00-011-103-
PRIOR INST: SPLIT 1 DV. 1385/403
SPLIT 2 DV. 1200/120 1204/764 O.R.415/741
O.R. COMB. O.R.
CLOSURE: 39.32 ac. C=1:662,959 5.44 ac. C=1:533,852
99.75 ac. deed 99.76 ac. ~~xxxx~~ calc.
SURVEYED BY: MacKAY ENG. & SURVEYING CO.

20695

SAN 5/26/94

APPROVED
LORAIN CO.
MAP DEPT.
DATE 1-20-94
PAGE 7-00-011-B
BY CAROLYN FRANCIS
VOID AFTER # 20695