

CONDOMINIUM


THIS CONDOMINIUM VACATED BY CERTIFICATES
RECORDED IN DEED VOLUME OR 870, PAGE 539.

*Tracy put this
Note on map*

5/26/94

#20698V

APPROVED	
LORAIN CO.	
MAP DEPT.	
DATE 3-8-94	
PAGE 7-00-008-D-	
BY <i>Holbert</i>	
VOID AFTER	20698V

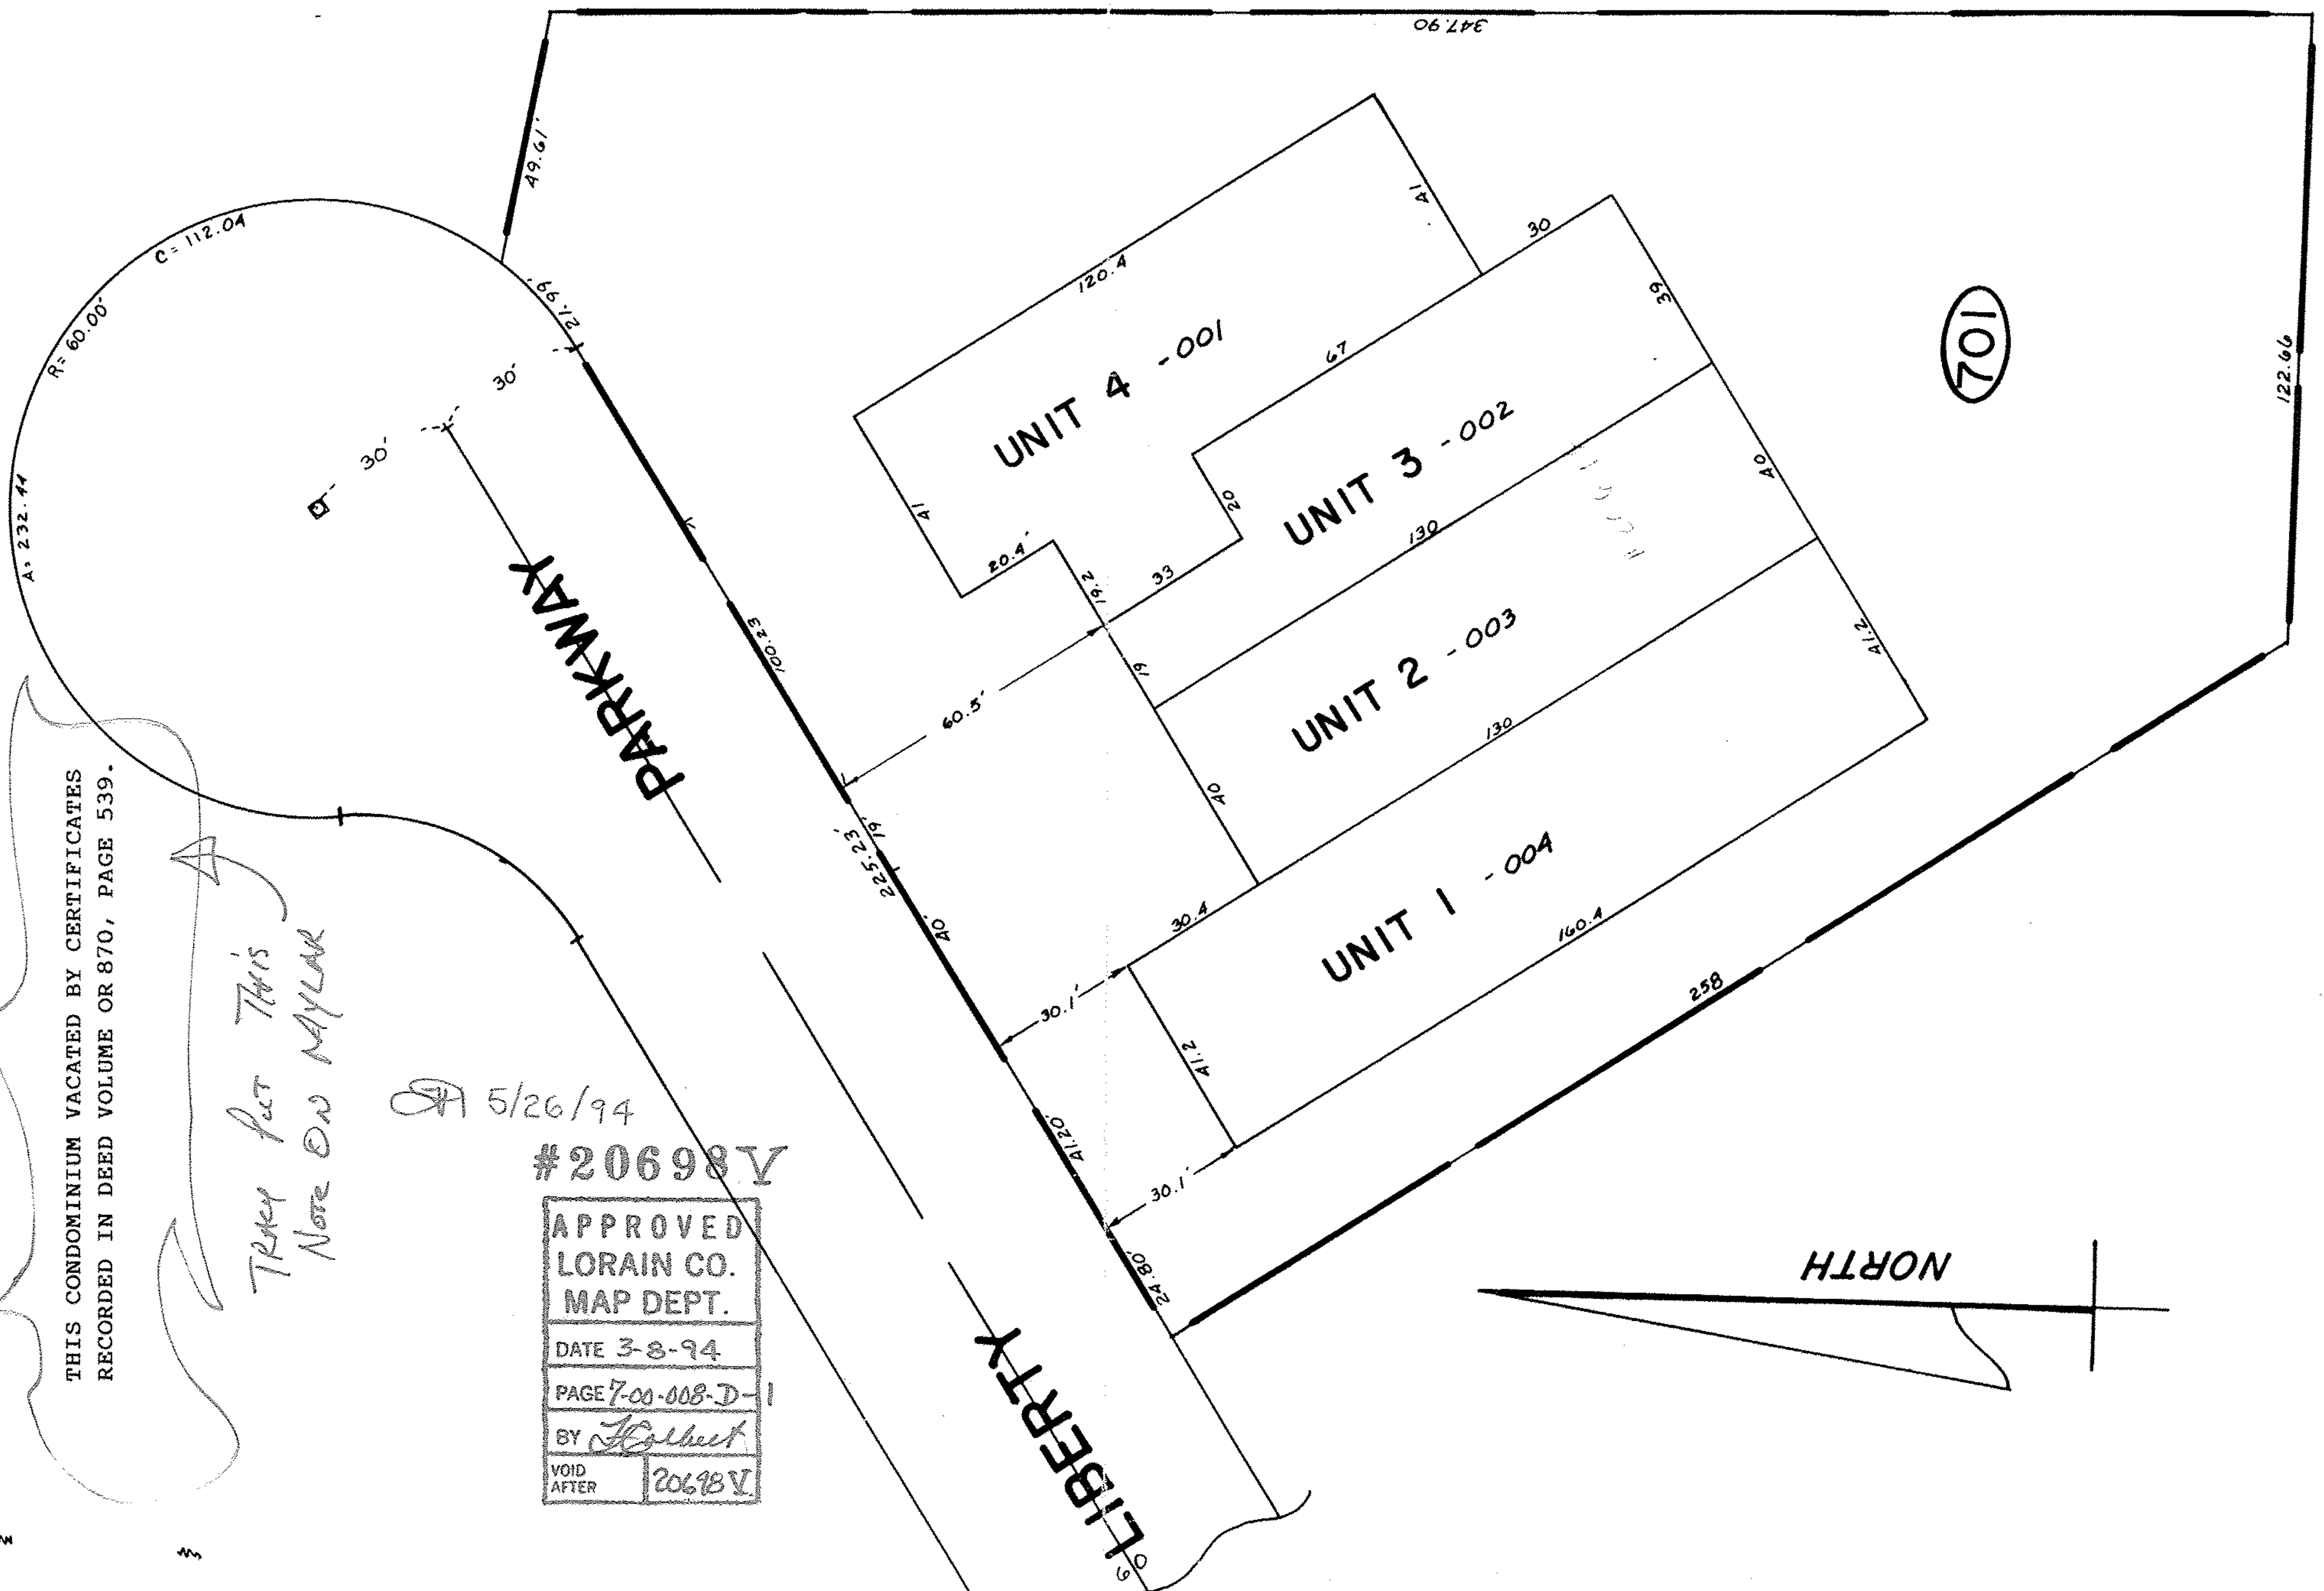

101

NORTH